




Written dimensions in these drawings shall have precedence over scale dimensions. Contractors shall verify and be responsible for all dimensions on the job and SITECON, Inc. shall not be liable for any errors or omissions from the dimensions and conditions shown on these drawings.

SITECON, Inc.
 Engineers-Surveyors
 10935 Hedden Rd. Suite 2
 Evansville, Indiana 47725
 (812) 868-0877

BRIDLEWOOD
 INDEX

Project: _____
 Sheet Title: _____

No.	Date	Description
1	8-12-99	REVISED PAD ELEVATIONS
2	8-2-99	UPDATE SANITARY SEWER
3	7-29-99	UPDATE SANITARY SEWER AND BOX COLLECTOR
4	6-28-99	UPDATE ROAD ELEVATIONS
5	6-28-99	UPDATE STORM SEWER

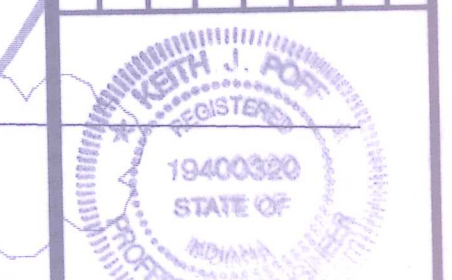

RECORD DRAWING
 SANITARY SEC. I - 9-15-99
 STORM SEC. I - 12-2-99

Scale: 1"=50'
 Designed By: KLP Job Number: 109-98-7
 Drawn By: RRB Date: 6-3-99
 Checked By: SUBPLAT
 Sheet Number: INDEX "A"