


Written dimensions on these drawings shall have precedence over all other dimensions and conditions on the job and SITECON, Inc. shall be held responsible for any discrepancies from the dimensions and conditions shown by these drawings.

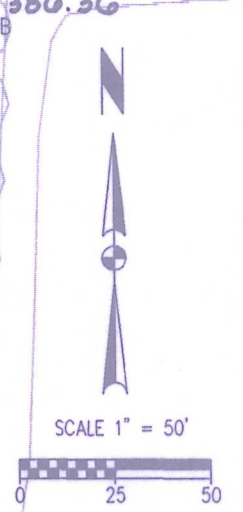

**SITECON, Inc.**  
Engineers-Surveyors

10935 Hedden Rd. Suite 2  
Evansville, Indiana 47765  
(612) 868-0877

**BRIDEWOOD**

**INDEX**


Project:

Sheet Title:

No.	Date	By	Description
1	8-12-99	RRB	REVISED PAID ELEVATIONS
2	8-12-99	RRB	UPDATE SANITARY SEWER
3	9-2-99	RRB	UPDATE SANITARY SEWER AND BOX COLLECTOR
4	9-2-99	RRB	UPDATE STORM ELEVATIONS
5	9-2-99	RRB	UPDATE STORM SEWER

**RECORD DRAWING**

SANITARY SEC. I - 9-15-99  
STORM SEC. I - 12-2-99

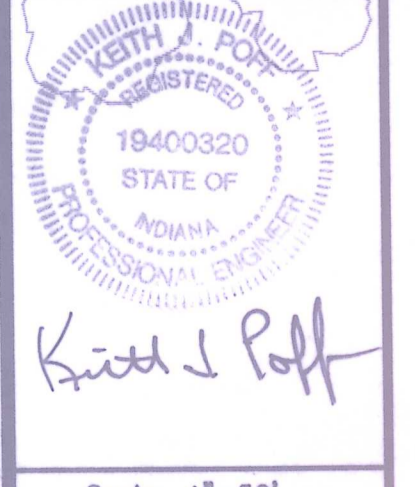

Scale: 1"=50'  
Designed By: KJP Job Number: 109-98-7  
Drawn By: RRB Date: 6-3-99  
Checked By: RRB File Name: SUBPLAT  
Sheet Number: **INDEX "B"**