


**RECORD DRAWING**

STORM SEC. I 12-2-99

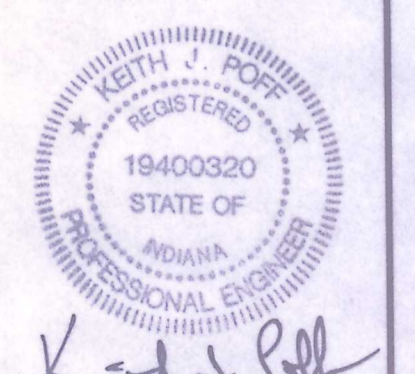

Scale: 1"=50'

Designed By: KJP	Job Number: 109-97-7
Drawn By: RRB	Date: 6-3-99
Checked By: [Signature]	Filename: PROFILE1.DWG

Sheet Number: **RP-1**

UPDATE SANITARY SEWER BOX CULVERT & EASEMENTS 7-29-99  
 UPDATE SAN. SEWER 8-9-99  
 UPDATE STORM SEWER 6-9-99