


(PAVED AREAS)

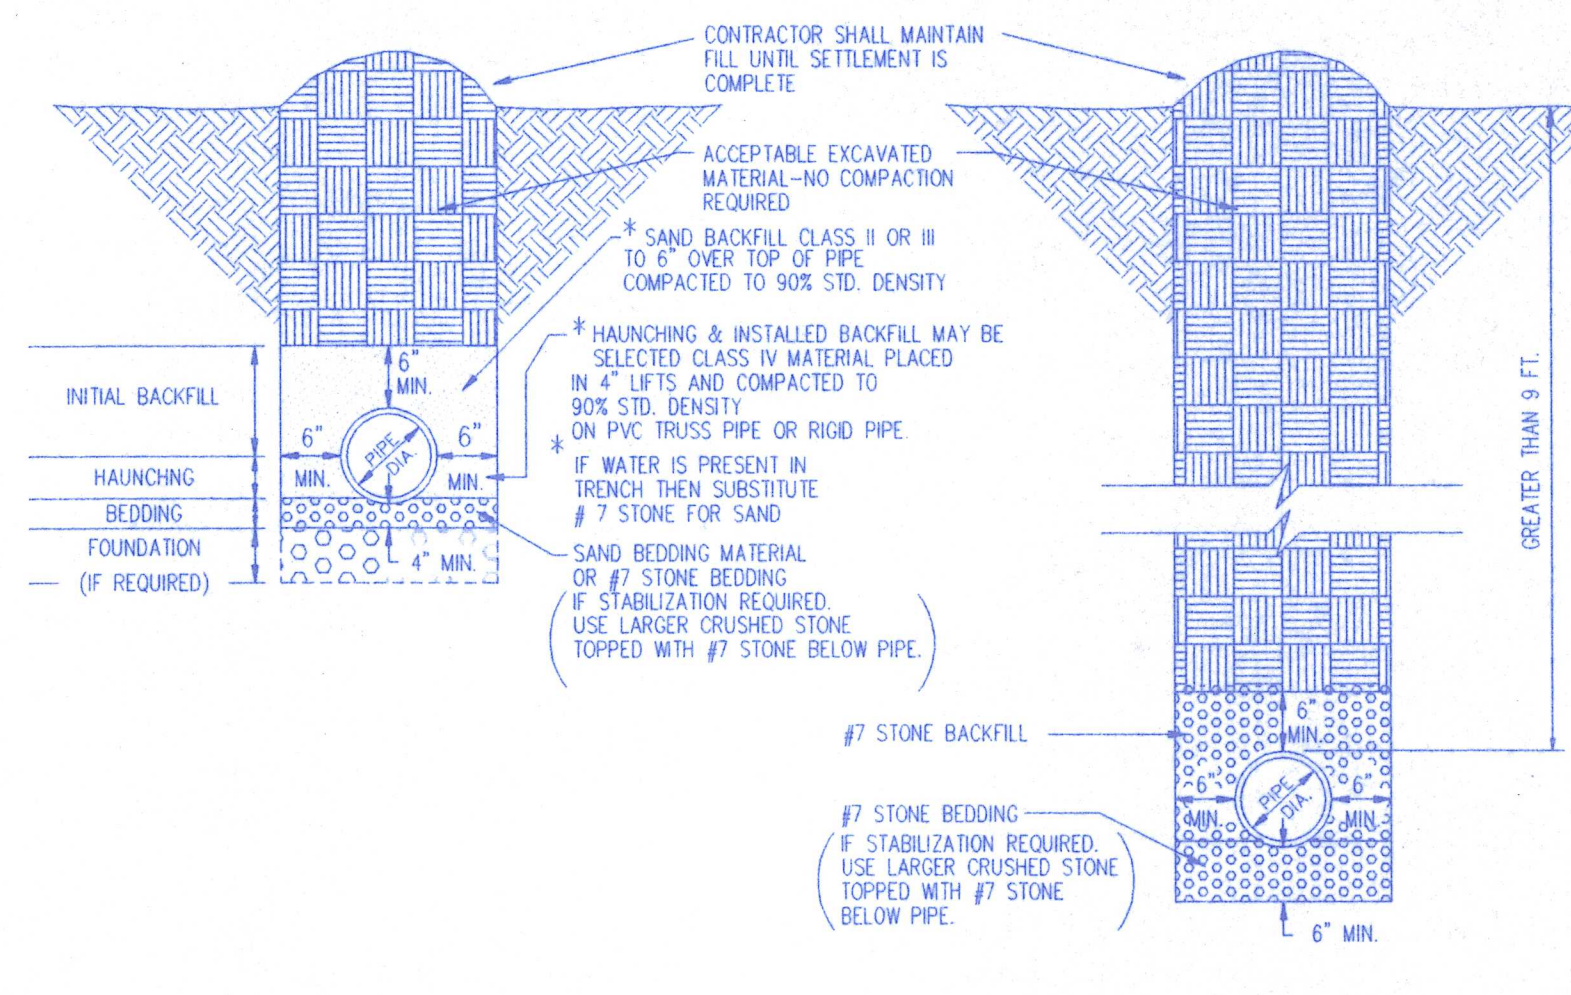


(UNPAVED AREAS)


**SANITARY SEWER BEDDING DETAILS**  
NO SCALE

**GENERAL NOTES**

- THE FOLLOWING LOCAL GOVERNMENTAL AGENCY SHALL BE NOTIFIED 24 HOURS PRIOR TO BEGINNING WORK AND ON A DAILY BASIS THEREAFTER WHEN PERFORMING THE WORK LISTED BELOW.
- SANITARY SEWERS**  
EVANSVILLE WATER & SEWER UTILITY OPERATIONS DEPARTMENT 421-2130
- SANITARY SEWERS**  
CONTRACTOR MUST VERIFY EVERY MANHOLE AND CLEANOUT TOP ELEVATION WITH OWNER SO THAT THEY END UP SLIGHTLY ABOVE FINAL LANDSCAPE GRADE.
- PRODUCT CERTIFICATIONS OR REPORTS ARE TO BE OBTAINED BY THE CONTRACTOR FROM THE CONCRETE SUPPLIER AND MADE AVAILABLE TO THE UTILITY'S INSPECTOR OR OFFICE.
- SEPARATION BETWEEN SANITARY SEWER AND WATER LINES IS TO BE IN ACCORDANCE WITH "TEN STATES STANDARDS".
- SEWER LATERALS SHALL BE CONSTRUCTED WITH FACTORY 8"x8"x6" WYE ON MAIN AND 6" PVC TO LOT OR EASEMENT LINE.

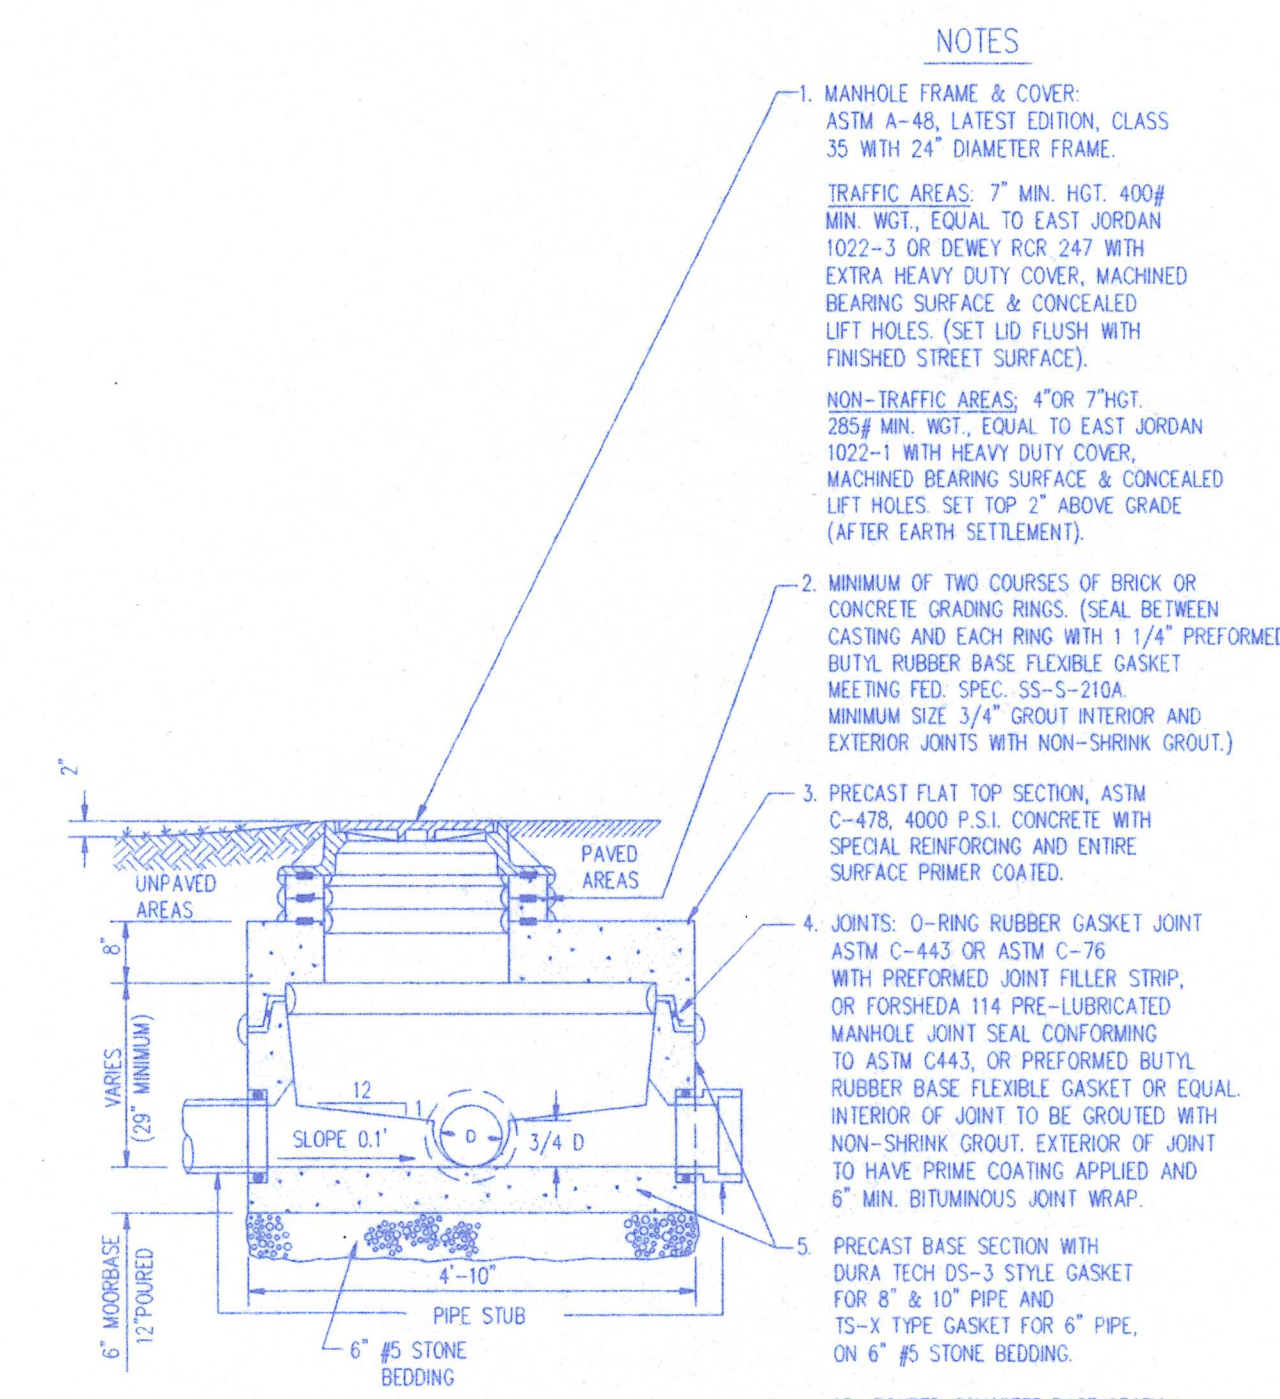


**PRECAST CONCRETE SHALLOW SANITARY SEWER MANHOLE #728 DETAIL**  
SCALE: N.T.S.

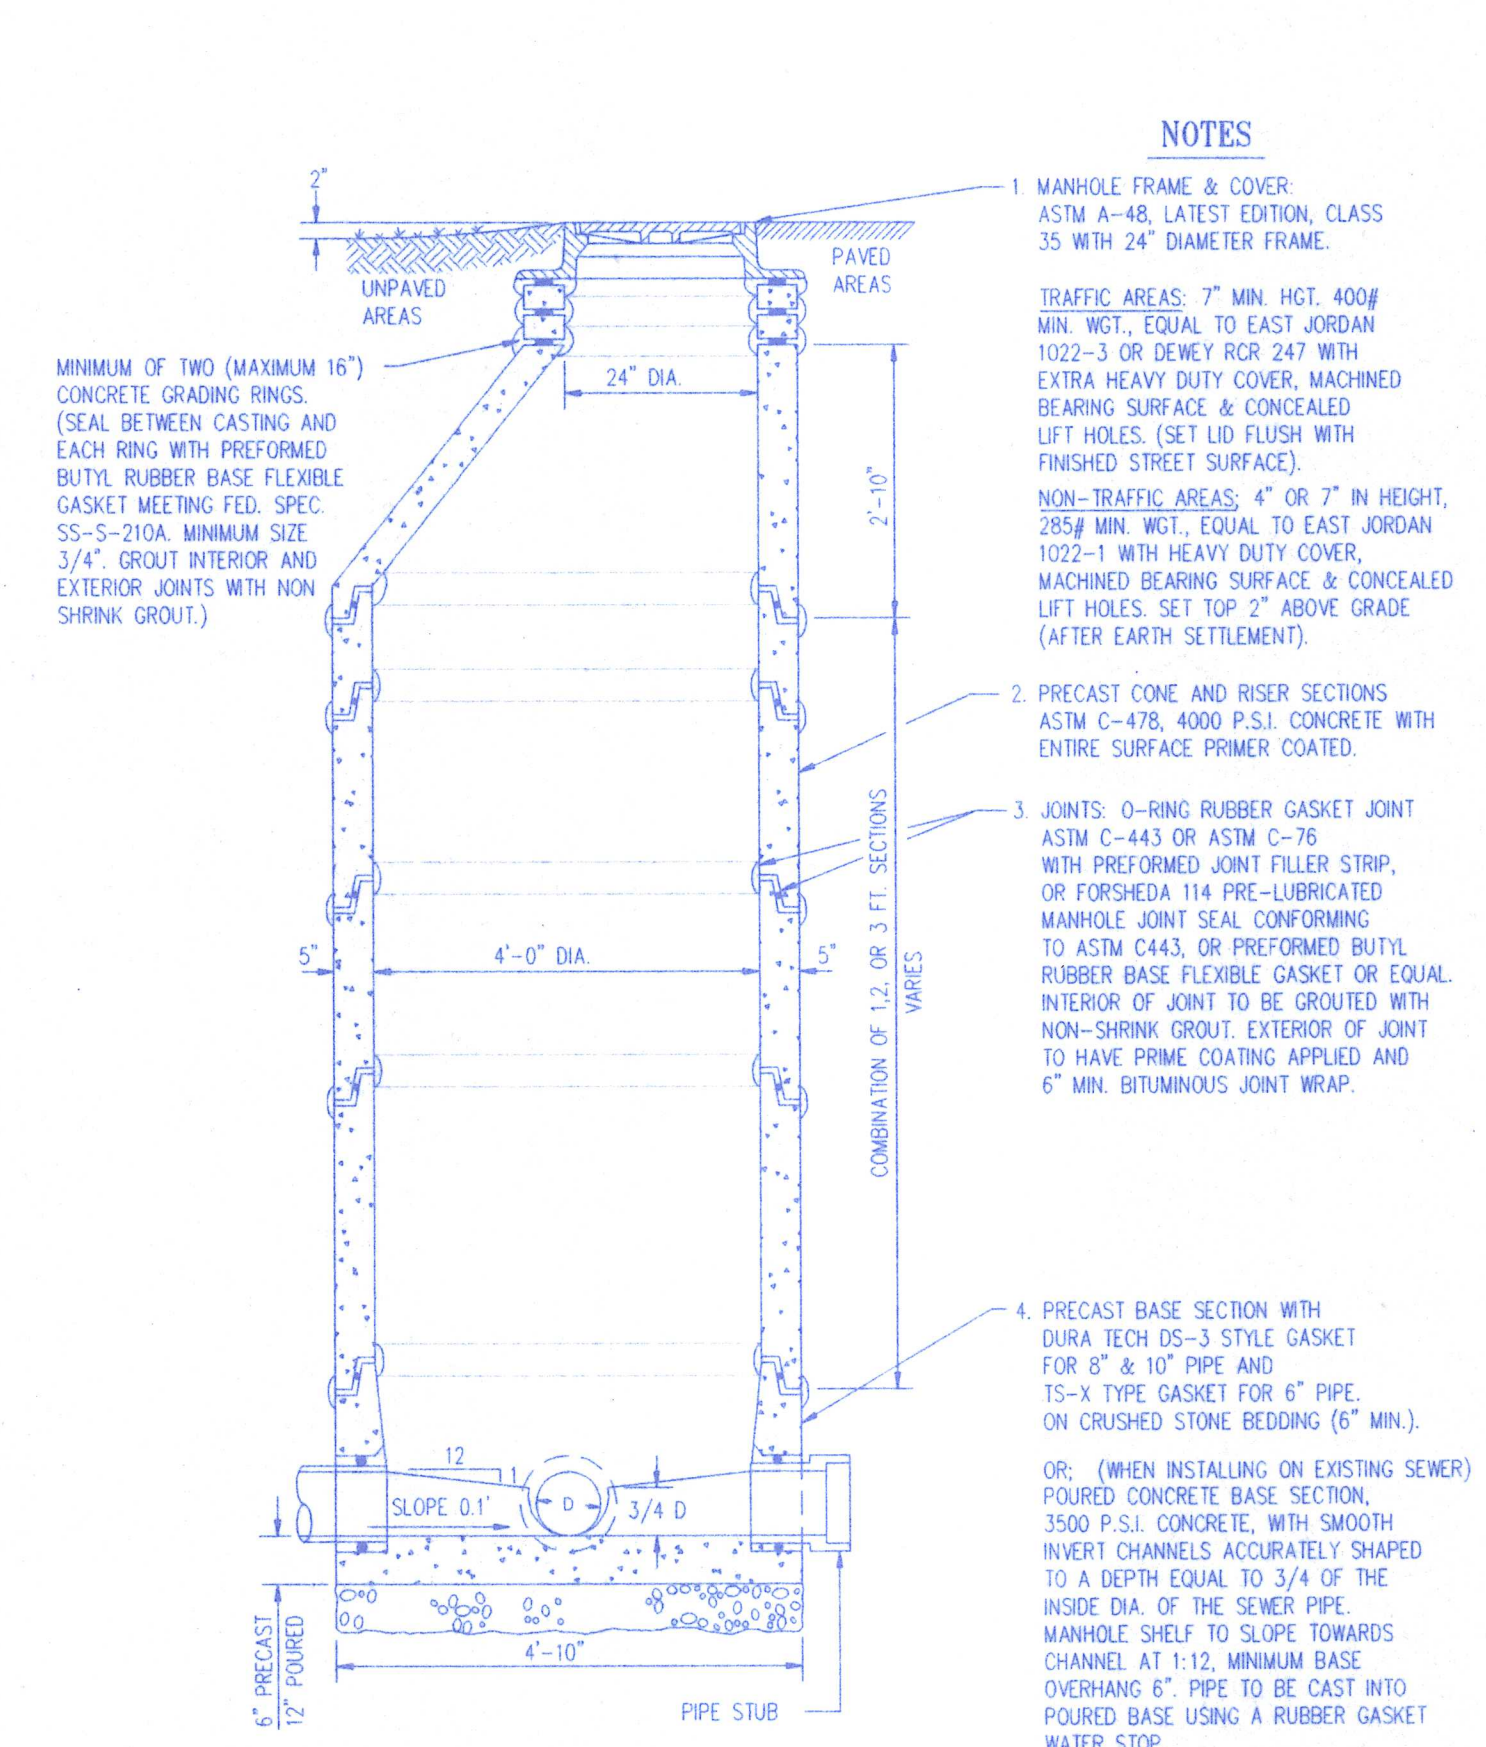

**PRECAST CONCRETE MANHOLE DETAIL**  
SCALE: N.T.S.

**RECORD DRAWING**  
SANITARY 9-4-02

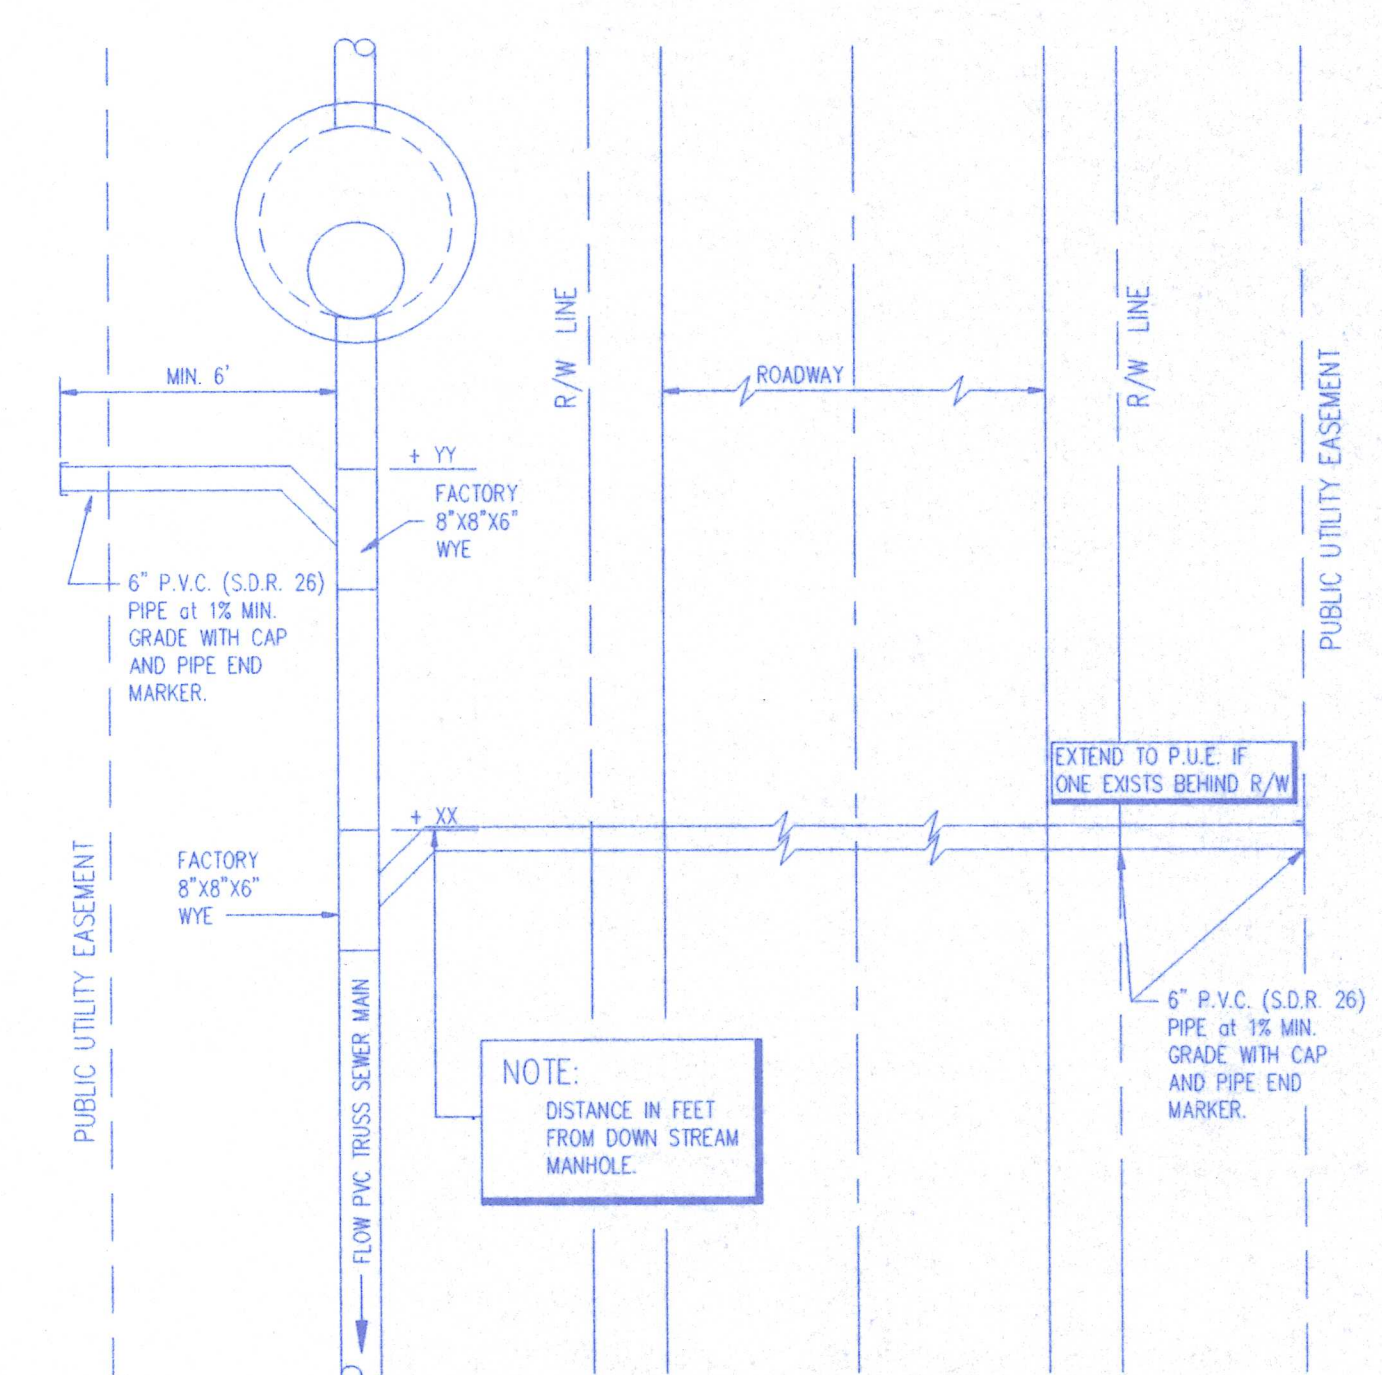


**SEWER LATERAL DETAIL**  
NO SCALE

Within dimensions on these drawings shall have precedence over scale dimensions. Contractors shall verify and be responsible for all dimensions and conditions on the job and SITECON, Inc. shall not be liable for any conditions from the dimensions and conditions shown by these drawings.

**SITECON, Inc.**  
Engineers-Surveyors  
10335 Hedden Rd. Suite 2  
Evansville, Indiana 47725  
(812) 868-0877

Project: **BRIDLEWOOD - SECTION 3**  
Sheet Title: **SANITARY SEWER DETAILS**

Revisions	Description	Date	By	No.

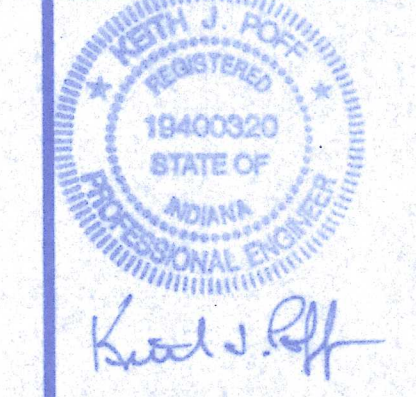

Scale: AS NOTED  
Designed By: P.J.G. Job Number: 109-01-27  
Drawn By: P.J.G. Date: 08-29-01  
Checked By: Filmore  
Sheet Name: SANDET.DWG  
Sheet Number: **DE-1**