
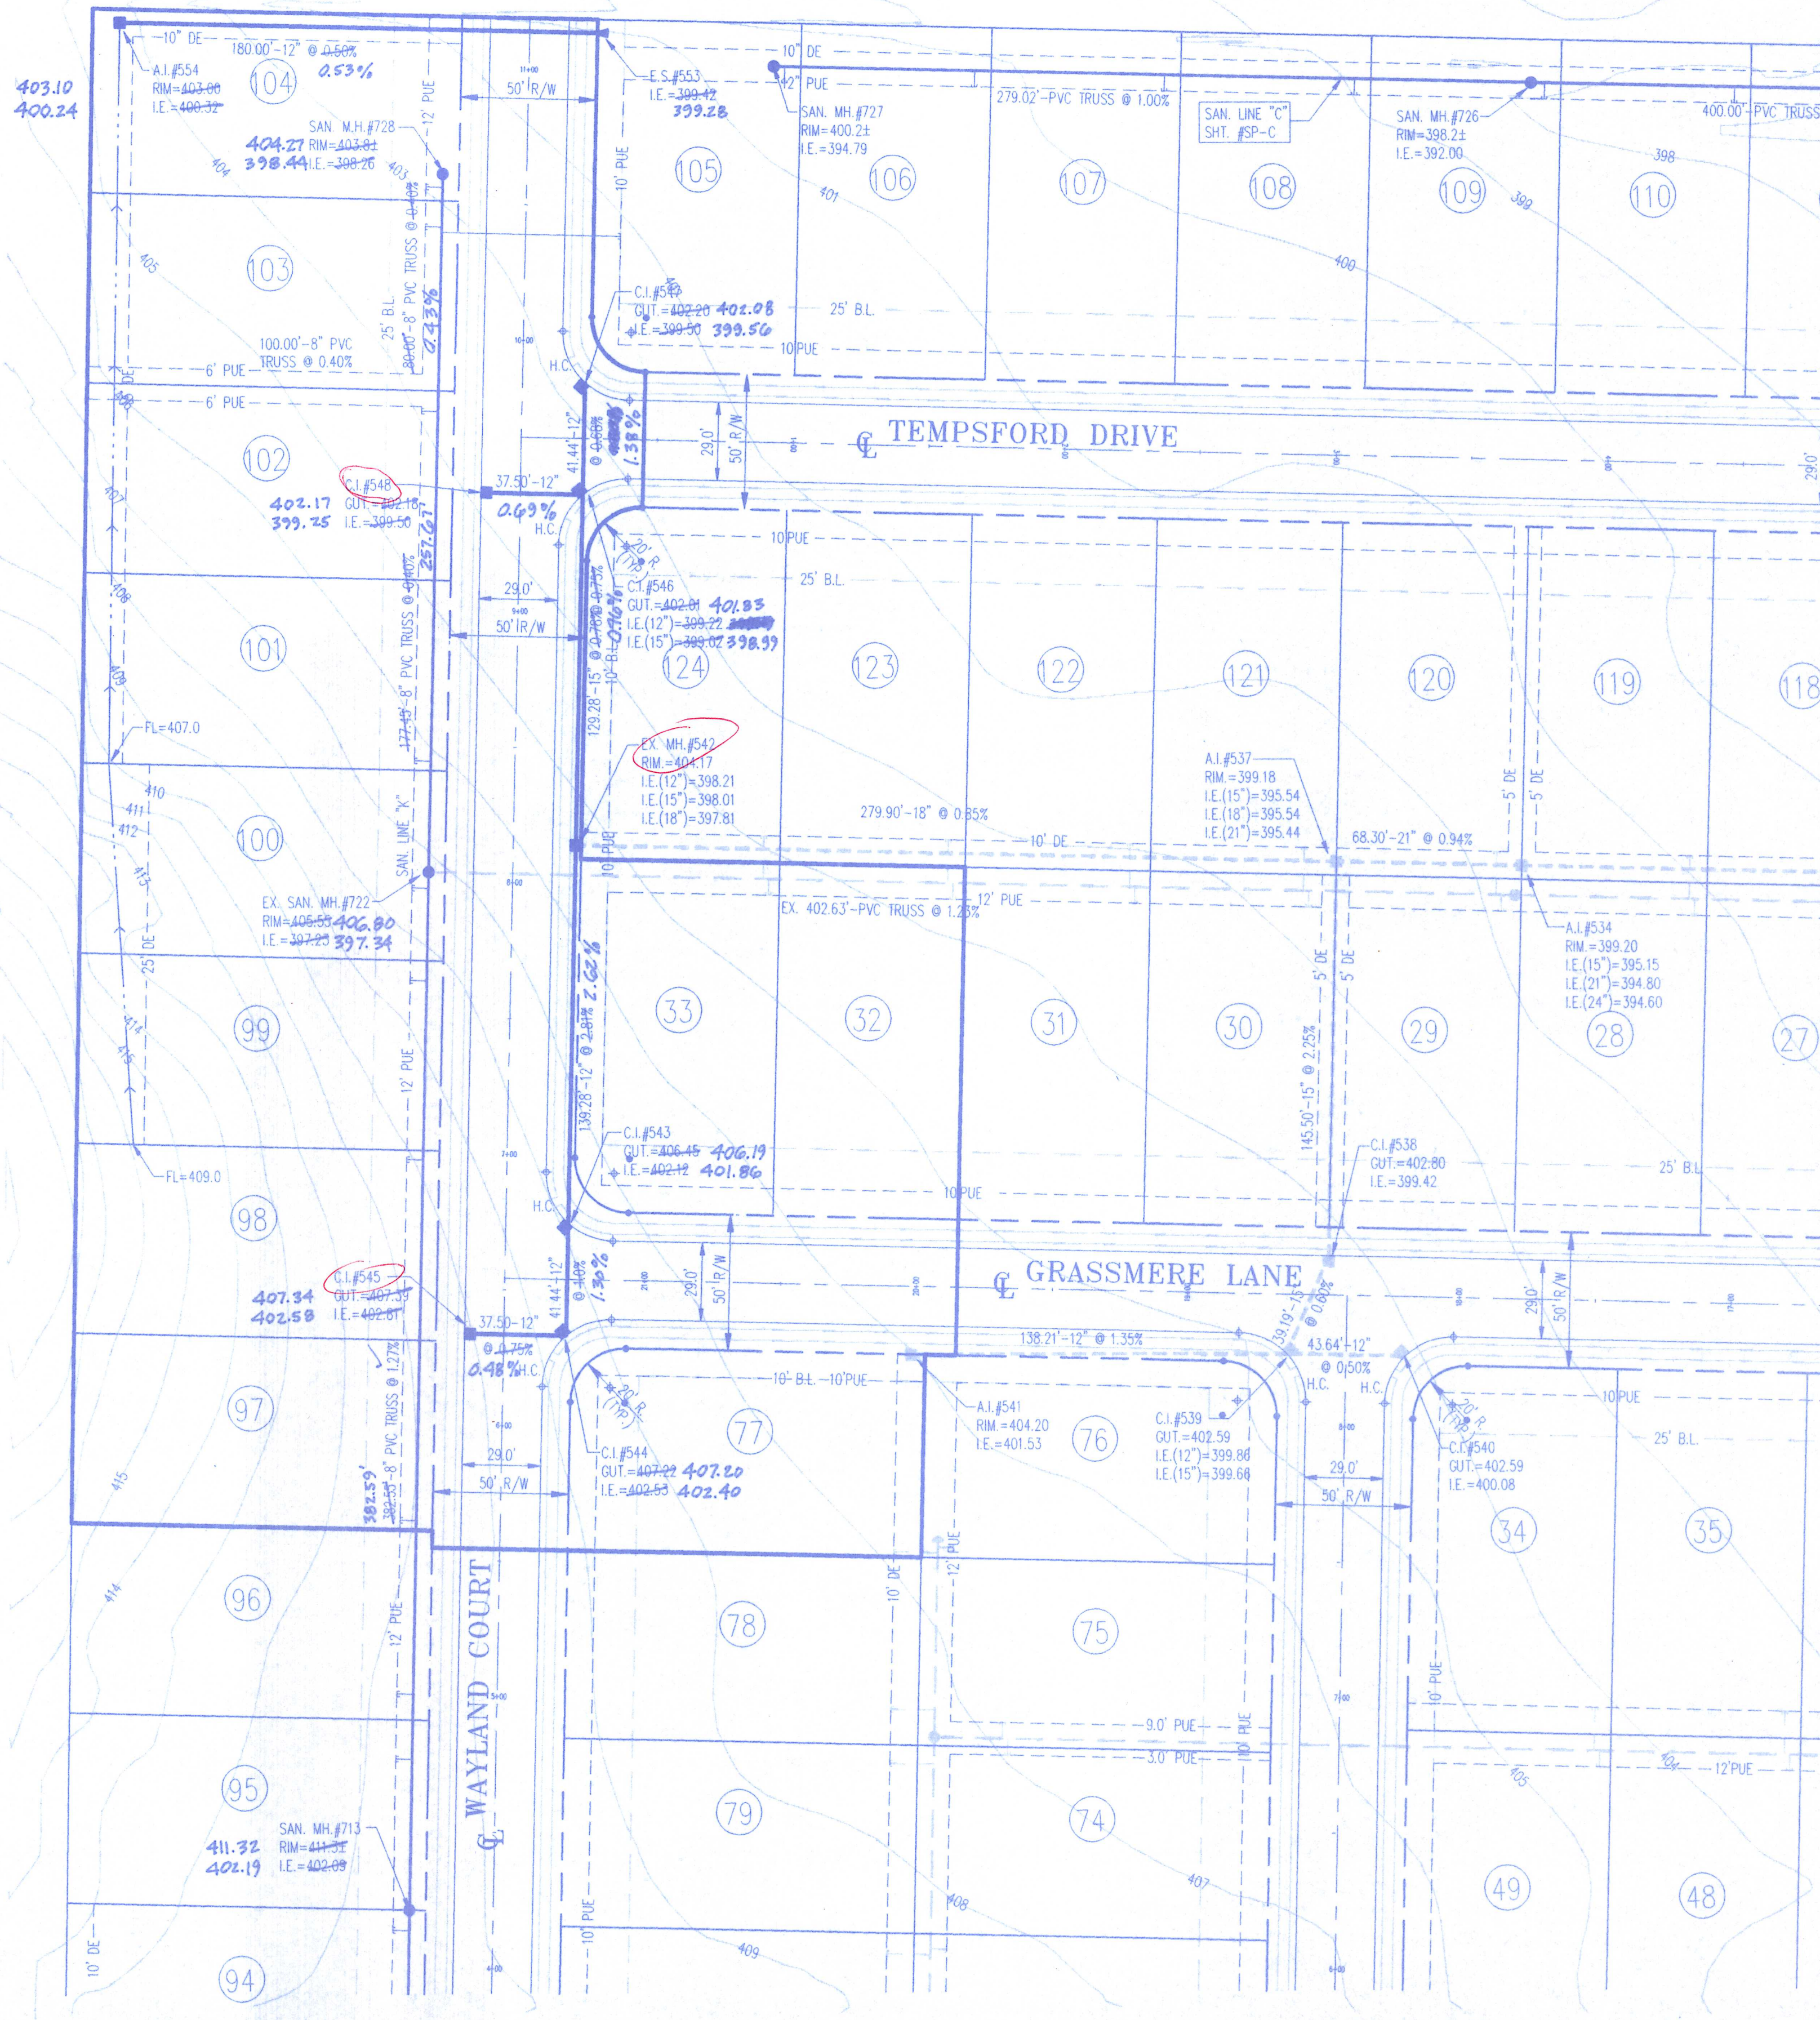


RECORD DRAWING

SANITARY 9-4-02
STREET & STORM 9-19-02

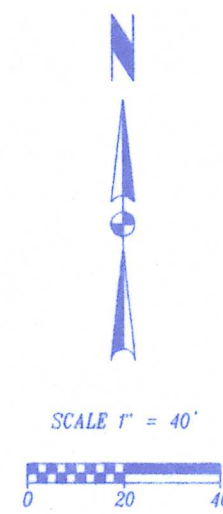


Written dimensions on these drawings shall have precedence over scale dimensions. Contractors shall be held responsible for verifying the accuracy of the dimensions and conditions shown by these drawings.

SITECON, Inc.
Engineers-Surveyors
10335 Hedden Rd. Suite 2
Evansville, Indiana 47725
(812) 868-0877

Project: **BRIDLEWOOD-SECTION 3**
Sheet Title: **INDEX SHEET**

No.	By	Date	Description

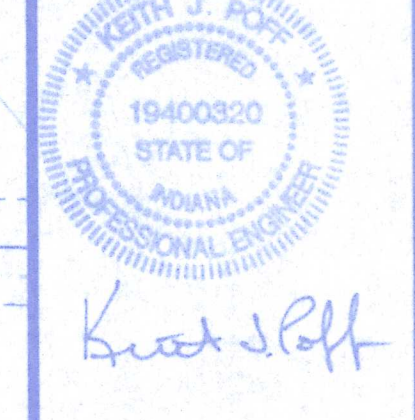

Scale: 1"=40'
Designed By: PJC Job Number: 109-01-27
Drawn By: PJC Date: 08-29-01
Checked By: PJC Filename: INDEX.DWG
Sheet Number: **INDEX**