

CURVE DATA

DESIGNATION	RADIUS	DELTA	LENGTH	CHORD
CURVE #7	100.00'	36°07'10"	63.04'	N71°56'25"W 62.00'
CURVE #8	100.00'	73°53'12"	128.96'	S53°03'24"W 128.00'
CURVE #9	100.00'	34°33'51"	60.33'	S01°10'07"E 59.42'

P.O.T. 0+14.5
ELEV.=430.08

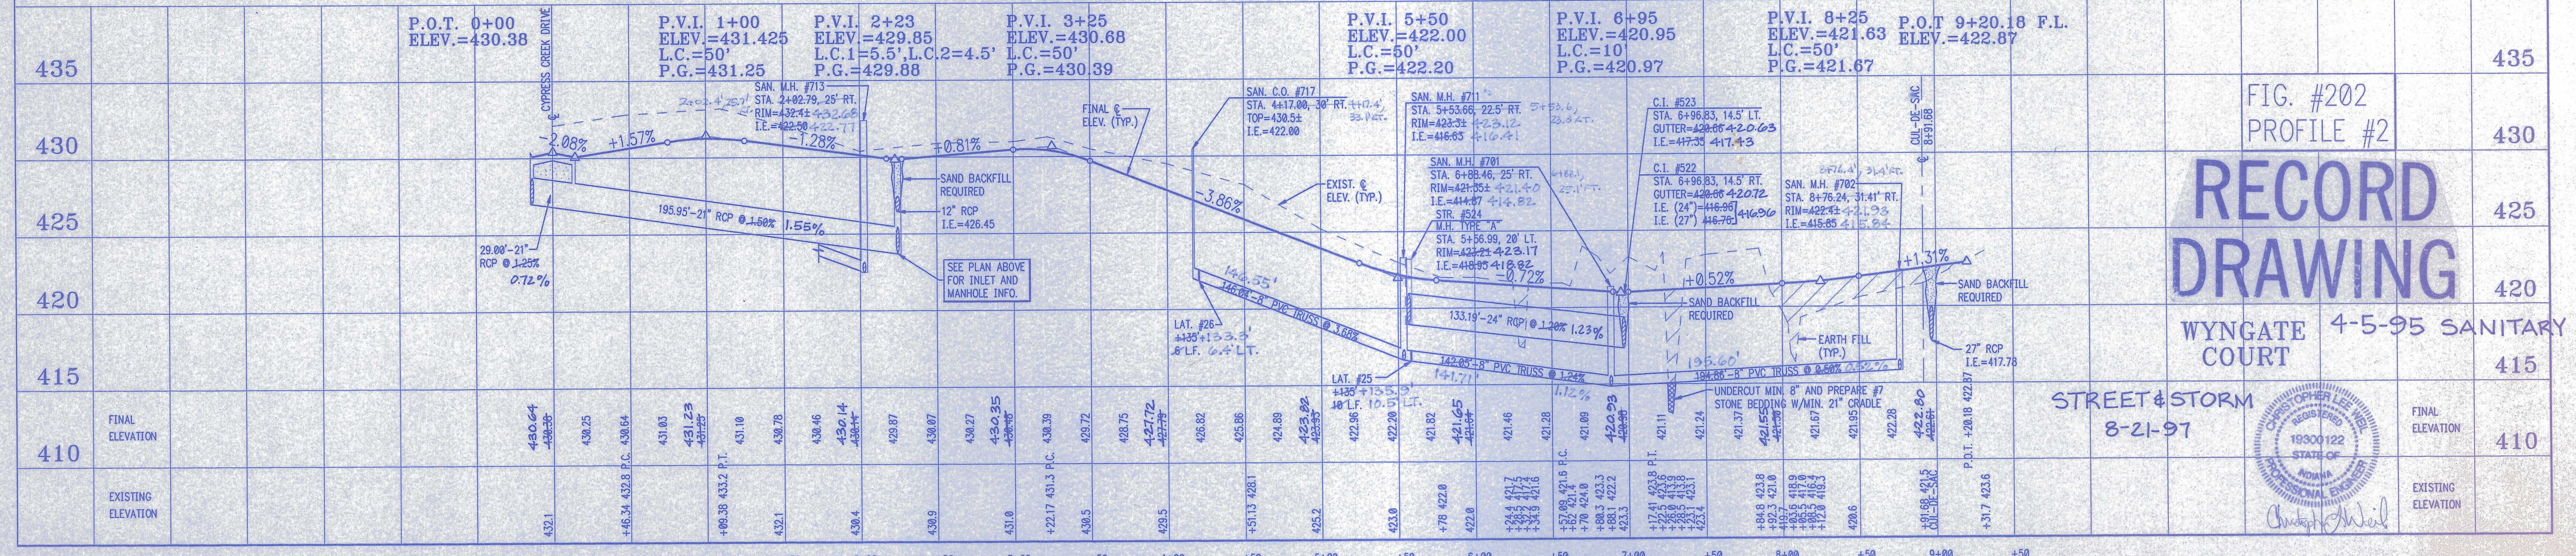


FIG. #202
PROFILE #2

RECORD DRAWING

WYNGATE COURT 4-5-95 SANITARY STREET & STORM 8-21-97

FINAL ELEVATION 415

EXISTING ELEVATION 410