


RECORD DRAWING
STORM-12-19-03

We, the undersigned, hereby certify that we have prepared these drawings and specifications in accordance with the provisions of the laws of the State of Indiana, and that we are duly licensed and qualified to practice as Professional Engineers in the State of Indiana. We are not responsible for any errors or omissions in these drawings and specifications, nor for any consequences that may result therefrom.

SITECON, Inc.
Engineers-Surveyors
10335 Hedden Rd. Suite 2
Evansville, Indiana 47725
(812) 668-0877

Project: **HAVENWOOD MEADOWS**
Sheet Title: **SUBDIVISION DRAINAGE PLAN**

No.	By	Date	Description
1	PUG	12-19-03	REVISED ENTRANCE RADI
2	PUG		
3	PUG		
4	PUG		

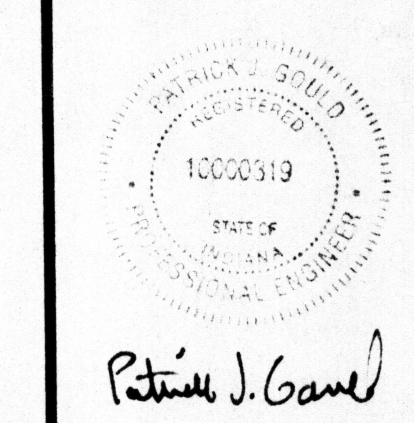

Scale: 1"=60'
Designed By: PUG Job Number: 465-02-1
Drawn By: PUG Date: 03-19-03
Filename: DRAINAGE.DWG
Sheet Number: **DR-1**