

VICINITY MAP


SCALE: 1"=2000'

LEGEND

THE PLASTIC PIPE SYSTEM INSTALLED IN THE CLOUDED REGION DOES NOT CONFORM TO THE VANDERBURGH COUNTY DRAINAGE ORDINANCE. THEREFORE THE SYSTEM WILL BE PRIVATELY MAINTAINED BY THE INDIVIDUAL LOT OWNERS.


- AREA INLET
- BOUNDARY
- EASEMENT
- CHAINLINK FENCE
- LOT LINE
- RIGHT-OF-WAY
- PLASTIC PIPE
- STORM SEWER EXIST
- OVERHEAD POWER LINES

RECORD STORM INFORMATION
MAY 22, 2009

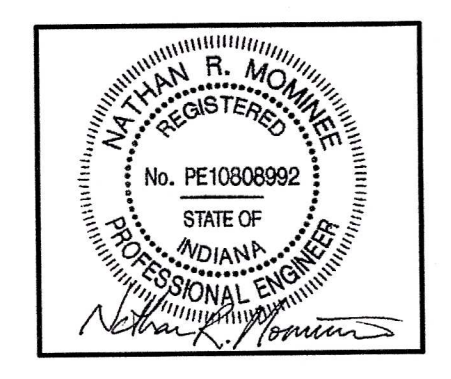

The information on this drawing shall be used by the contractor for construction purposes only. The contractor shall verify and be responsible for all dimensions and conditions on the job and SITECON, Inc. shall not be held responsible for any errors or omissions from the information and conditions shown by these drawings.

SITECON, Inc.
Engineers-Surveyors
10836 Hadden Rd. Suite 2
Evansville, Indiana 47725
(812) 868-0877

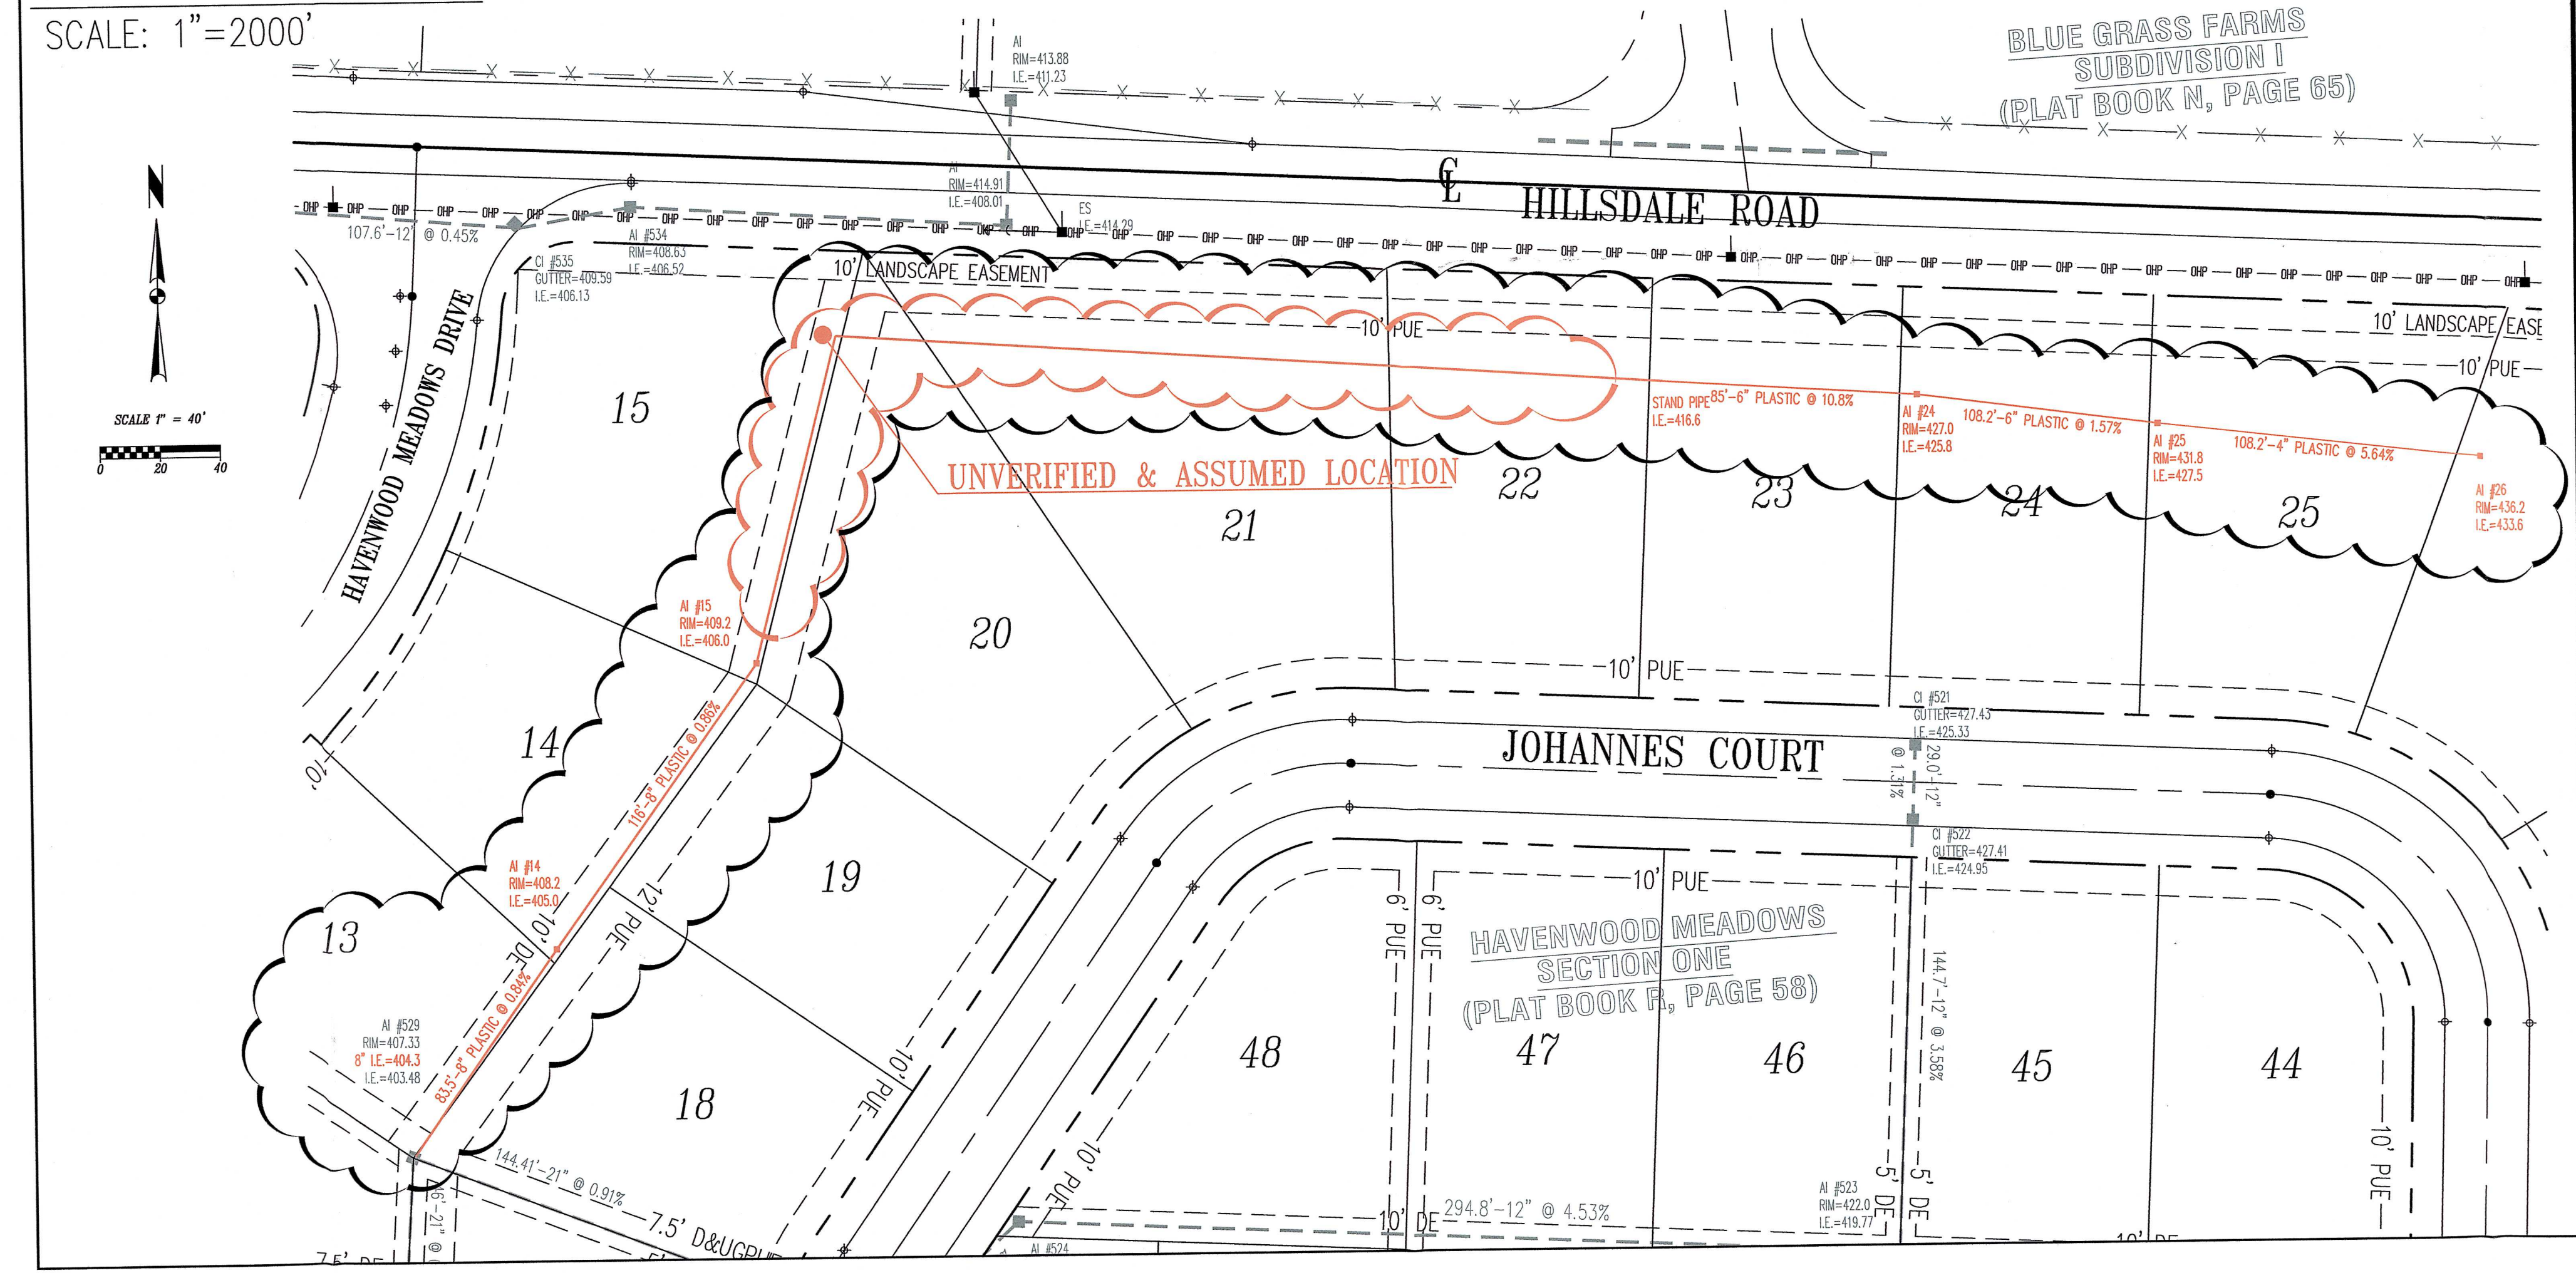

Project: HAVENWOOD MEADOWS
Sheet Title: PLASTIC PIPE RECORD DRAWING

No.	By	Date	Description

Scale: 1"=40'

Designed By: NRM Job Number: 465-09-1
Drawn By: NRM Date: 05-22-09
Filename: REC PLASTIC PIPE.DWG
Sheet Number: 1