

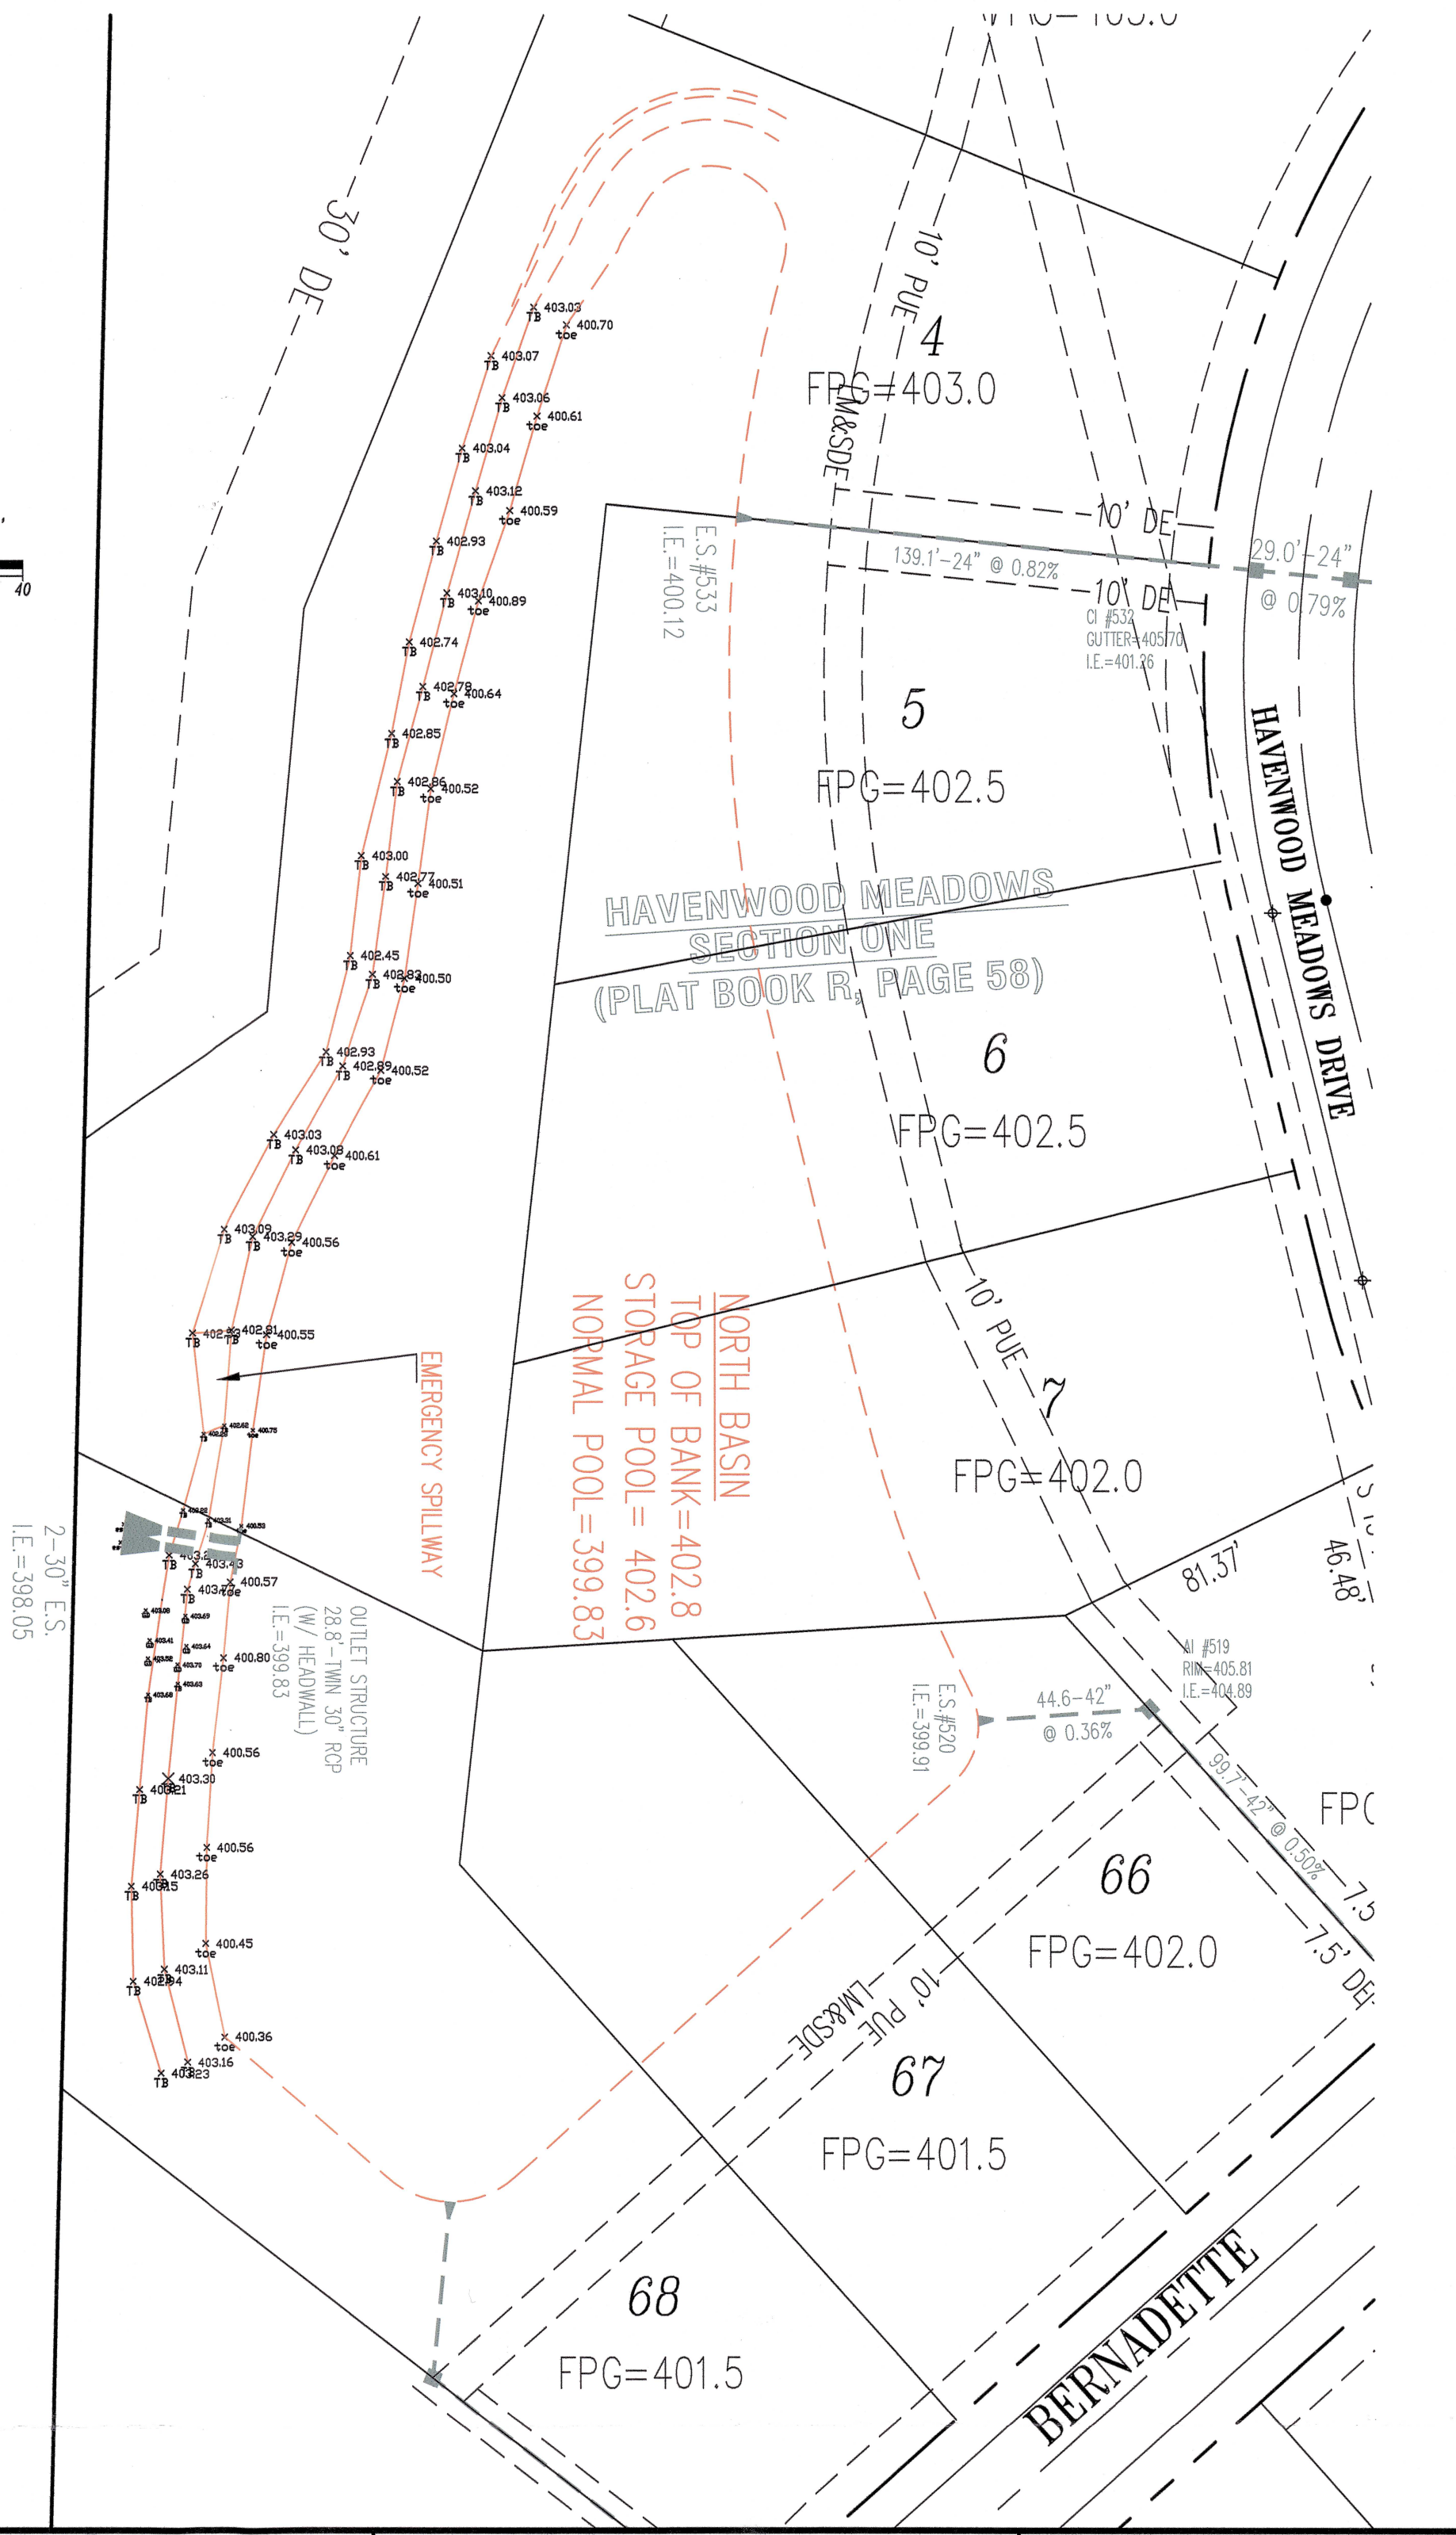


VICINITY MAP
SCALE: 1"=2000'

LEGEND	
AREA INLET	■
BOUNDARY	—
EASEMENT	- - -
CHAINLINK FENCE	× × × × × × × ×
LOT LINE	- · - · - · - ·
RIGHT-OF-WAY	— · — · — · — ·
PLASTIC PIPE	— · — · — · — ·
STORM SEWER EXIST	— · — · — · — ·
OVERHEAD POWER LINES	— · — · — · — ·
DETENTION BASIN	— · — · — · — ·
CENTERLINE	— · — · — · — ·

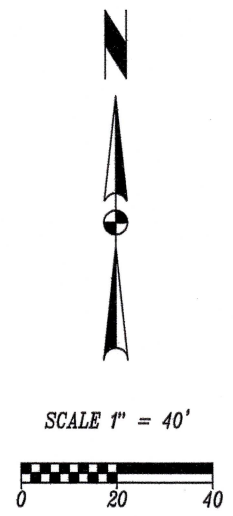

RECORD BASIN INFORMATION
MAY 22, 2009

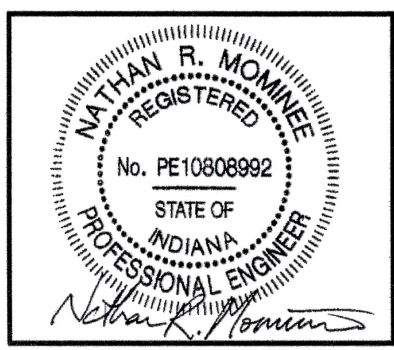

Revisions			
No.	By	Date	Description
▲			
▲			
Project: **HAVENWOOD MEADOWS SECTION ONE**
Sheet Title: **SPILLWAY RECORD DRAWING**

SITECON, Inc.
Engineers-Surveyors
10335 Hedden Rd. Suite 2
Evansville, Indiana 47725
(812) 868-0877

Written dimensions on these drawings shall have precedence over scale dimensions. Contractors shall verify and be responsible for all dimensions and conditions on the job and SITECON, Inc., must be notified of any variations from the dimensions and conditions shown by these drawings.