


N 89°49'09" E 1318.93'

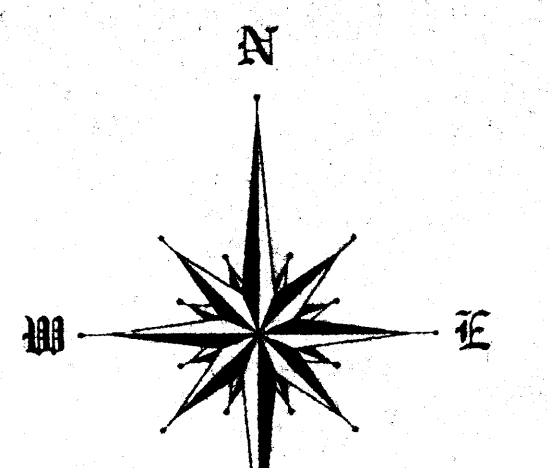

STORM SEWER LINE TABLE

LINE 101	119.07 LF	15" DIA AT 0.74% = AB=108.97 @ 0.91%
LINE 201	176.04 LF	24" DIA AT 0.48% = AB=170.96 @ 0.73%
LINE 202	64.48 LF	24" DIA AT 0.48% = AB=67.49 @ 0.73%
LINE 203	121.17 LF	24" DIA AT 0.88% = AB=121.70 @ 0.70%
LINE 204	158.73 LF	18" DIA AT 2.88% = AB=152.72 @ 2.00%
LINE 205	178.80 LF	18" DIA AT 8.11% = AB=180.76 @ 6.10%
LINE 206	128.50 LF	18" DIA AT 1.70% = AB=131.32 @ 1.77%
LINE 207	28.00 LF	12" DIA AT 0.86% = AB=27.72 @ 0.54%
LINE 208	200.77 LF	12" DIA AT 4.07% = AB=200.82 @ 3.96%
LINE 209	30.73 LF	12" DIA AT 0.91% = AB=29.67 @ 1.45%
LINE 210	16.83 LF	12" DIA AT 2.13% = AB=17.38 @ 2.38%
LINE 211	28.00 LF	12" DIA AT 0.71% = AB=27.91 @ 0.36%
LINE 401	143.98 LF	42" DIA AT 1.00% = AB=140.61 @ 1.01%
LINE 402	29.00 LF	42" DIA AT 1.00% = AB=27.97 @ 0.88%
LINE 403	130.51 LF	42" DIA AT 1.00% = AB=130.72 @ 0.99%
LINE 404	130.60 LF	30" DIA AT 5.29% = Not Constructed
LINE 405	71.68 LF	30" DIA AT 1.00% = N/C
LINE 406	70.65 LF	30" DIA AT 1.00% = N/C
LINE 407	12.71 LF	24" DIA AT 1.00% = N/C
LINE 408	34.66 LF	30" DIA AT 1.00% = N/C
LINE 409	139.61 LF	30" DIA AT 1.00% = N/C
LINE 410	76.65 LF	30" DIA AT 1.00% = N/C
LINE 411	171.71 LF	30" DIA AT 1.00% = AB=170.17 @ 0.08%
LINE 412	130.48 LF	30" DIA AT 1.74% = N/C
LINE 413	29.00 LF	30" DIA AT 1.74% = N/C
LINE 414	38.57 LF	30" DIA AT 1.74% = N/C
LINE 415	29.00 LF	18" DIA AT 1.00% = N/C
LINE 416	57.61 LF	18" DIA AT 1.00% = N/C
LINE 417	OMITTED	
LINE 418	33.06 LF	24" DIA AT 9.38% = N/C
LINE 501	148.59 LF	30" DIA AT 0.80% = AB=142.40 @ 0.58%
LINE 502	28.00 LF	30" DIA AT 1.02% = AB=27.84 @ 0.19%
LINE 503	69.00 LF	24" DIA AT 1.02% = AB=64.34 @ 0.87%
LINE 504	114.00 LF	24" DIA AT 1.02% = AB=114.40 @ 0.98%
LINE 505	140.89 LF	18" DIA AT 2.83% = N/C
LINE 506	34.23 LF	18" DIA AT 2.00% = N/C
LINE 507	32.90 LF	18" DIA AT 1.00% = N/C
LINE 508	29.00 LF	18" DIA AT 1.00% = N/C
LINE 509	215.41 LF	12" DIA AT 3.58% = N/C
LINE 510	46.95 LF	12" DIA AT 1.50% = N/C
LINE 511	119.33 LF	12" DIA AT 4.33% = N/C
LINE 512	76.00 LF	12" DIA AT 1.28% = N/C
LINE 600	44.85 LF	12" DIA AT 4.36% = AB=32.75 @ 6.40%
LINE 700	171.90 LF	12" DIA AT 2.11% = AB=167.85 @ 2.18%

1. Ralph A. Fasley, certify and affirm that the portion of the completed storm water drainage system, installed to date, for this project complies with the Final Drainage Plan as approved by the Vanderburgh County Drainage Board and as amended as follows:

1. Deletion of Junction Box 801.
2. Addition of End Section 800A.
3. Variation of rim, invert elevation and slopes as indicated by this Construction Record Drawing.

Ralph A. Fasley 6-27-06
 Ralph A. Fasley, Jr., P.E.
 Indiana Registration No. 12892

CONSTRUCTION RECORD DRAWING
 Based on Field Information
 Obtained On: 1-9-06 - Sec. "A"
 Updated: REVIS 02/06
 Updated:

NOTE:
 AS OF 1/9/06 - ONLY HAC BINDER COURSE INSTALLED.
 NO WEARING SURFACE FOR ALL OF STREETS - SECTION "A".

Network: 01 Description: 180 series

Node No.	Northing	Easting	Rim Elev (ft)	Junc Type	Size (in)	Flow (cfs)	Width (ft)	Kj	Inlet Type	Node No.
1	4624.9247	4153.6327	411.350	circ	4.000	4.000	1.00	none	1	

Network: 07 Description: 700 series

Node No.	Northing	Easting	Rim Elev (ft)	Junc Type	Size (in)	Flow (cfs)	Width (ft)	Kj	Inlet Type	Node No.
1	5095.4137	4388.6317	413.230	circ	4.000	4.000	1.00	none	1	
2	4745.7189	4330.5770	412.490	circ	4.000	4.000	1.00	none	2	
3	4826.2033	4519.8297	415.500	circ	4.000	4.000	1.00	grate	3	
4	4826.2033	4519.8297	415.500	circ	4.000	4.000	1.00	grate	4	
5	4826.2033	4519.8297	415.500	circ	4.000	4.000	1.00	none	5	
6	4666.4488	4808.4535	431.000	circ	4.000	4.000	1.00	none	6	
7	4666.4488	4808.4535	431.000	circ	4.000	4.000	1.00	none	7	
8	4837.3100	4507.5827	413.000	circ	4.000	4.000	1.00	none	8	
9	4855.7831	4486.1371	413.000	circ	4.000	4.000	1.00	none	9	
10	4973.6228	4623.3331	420.940	circ	4.000	4.000	1.00	none	10	
11	5000.8417	4671.4966	420.940	circ	4.000	4.000	1.00	none	11	

Network: 04 Description: 400 series

Node No.	Northing	Easting	Rim Elev (ft)	Junc Type	Size (in)	Flow (cfs)	Width (ft)	Kj	Inlet Type	Node No.
1	5784.3170	4178.5083	415.618	circ	4.000	4.000	1.00	none	1	
2	5308.0364	4595.1934	415.618	circ	4.000	4.000	1.00	none	2	
3	5413.9208	4671.8831	417.100	circ	4.000	4.000	1.00	none	3	
4	5223.6289	4741.8905	425.880	circ	4.000	4.000	1.00	none	4	
5	5582.9178	4782.6217	424.000	circ	4.000	4.000	1.00	none	5	
6	5641.0588	4782.6217	424.737	circ	4.000	4.000	1.00	none	6	
7	5584.6197	4771.8719	423.660	circ	4.000	4.000	1.00	none	7	
8	5213.3150	4857.4332	425.847	circ	4.000	4.000	1.00	none	8	
9	5284.5746	4985.6223	419.640	circ	4.000	4.000	1.00	none	9	
10	5848.7648	4892.0787	426.700	circ	4.000	4.000	1.00	none	10	
11	5284.5746	4985.6223	419.640	circ	4.000	4.000	1.00	none	11	
12	5341.9848	4894.9388	426.270	circ	4.000	4.000	1.00	none	12	
13	5354.9692	4925.8705	426.270	circ	4.000	4.000	1.00	none	13	
14	5354.9692	4925.8705	426.270	circ	4.000	4.000	1.00	none	14	
15	5601.9108	4747.1808	423.060	circ	4.000	4.000	1.00	none	15	
16	5452.2630	4752.7882	423.710	circ	4.000	4.000	1.00	none	16	
17	5344.0352	5130.0781	422.000	circ	4.000	4.000	1.00	none	17	
18	5312.0362	5163.0806	425.000	circ	4.000	4.000	1.00	none	18	

Network: 05 Description: 500 series

Node No.	Northing	Easting	Rim Elev (ft)	Junc Type	Size (in)	Flow (cfs)	Width (ft)	Kj	Inlet Type	Node No.
1	5019.6129	4099.7245	412.480	circ	4.000	4.000	1.00	combo	1	
2	5101.8516	4081.1116	412.480	circ	4.000	4.000	1.00	combo	2	
3	5174.2707	4118.0100	413.750	circ	4.000	4.000	1.00	combo	3	
4	5241.8138	4014.8420	413.656	circ	4.000	4.000	1.00	none	4	
5	5381.0241	4024.0849	419.000	circ	4.000	4.000	1.00	none	5	
6	5384.4252	4190.0020	419.000	circ	4.000	4.000	1.00	combo	6	
7	5415.2867	4000.5845	418.950	circ	4.000	4.000	1.00	none	7	
8	5427.3741	4180.0824	419.000	circ	4.000	4.000	1.00	none	8	
9	5467.8650	4185.0294	426.450	circ	4.000	4.000	1.00	none	9	
10	5594.6498	4223.8295	426.950	circ	4.000	4.000	1.00	none	10	
11	5492.0214	4840.2686	420.000	circ	4.000	4.000	1.00	none	11	
12	5492.1187	3862.2709	424.000	circ	4.000	4.000	1.00	none	12	

Network: 06 Description: 600 series - seb road - N

Node No.	Northing	Easting	Rim Elev (ft)	Junc Type	Size (in)	Flow (cfs)	Width (ft)	Kj	Inlet Type	Node No.
1	5302.1152	5164.4462	430.640	circ	4.000	4.000	1.00	none	1	

Network: 07 Description: 700 series - Seb Road - N


Node No.	Northing	Easting	Rim Elev (ft)	Junc Type	Size (in)	Flow (cfs)	Width (ft)	Kj	Inlet Type	Node No.
1	4873.5143	5171.1173	434.670	circ	4.000	4.000	1.00	none	1	

Network: 08 Description: BIG LAKE RELEASE

Node No.	Northing	Easting	Rim Elev (ft)	Junc Type	Size (in)	Flow (cfs)	Width (ft)	Kj	Inlet Type	Node No.
1	4555.3076	3938.8741	410.000	circ	4.000	4.000	1.00	none	1	
2	4718.2030	4030.6491	409.864	circ	4.000	4.000	1.00	none	2	

SCALES:

FES 700
 STA 98+66.29
 Rim=430.25
 I.E.=428.00 AB=428.11'

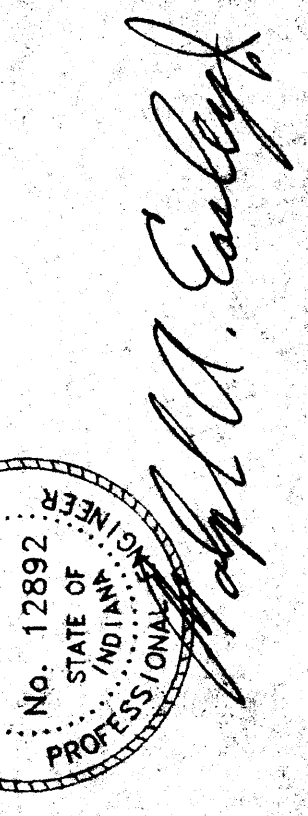

Storm Drainage Plan
 Newburgh Development
 Vanderburgh County, Indiana

Storm Drainage Plan
 Newburgh Development
 Vanderburgh County, Indiana

DRAIN BY: DATE: 3/26/04
 PROJECT NO: 04
 REVISIONS: TBT
 SCALE: 1" = 40'
 SHEET NO: 5.0

N 89°57'25" W 1318.41'