



Delk Drive-Langly Court Intersection
 Scale: 1" = 20'
 1" = 50' HOR
 1" = 5' VER

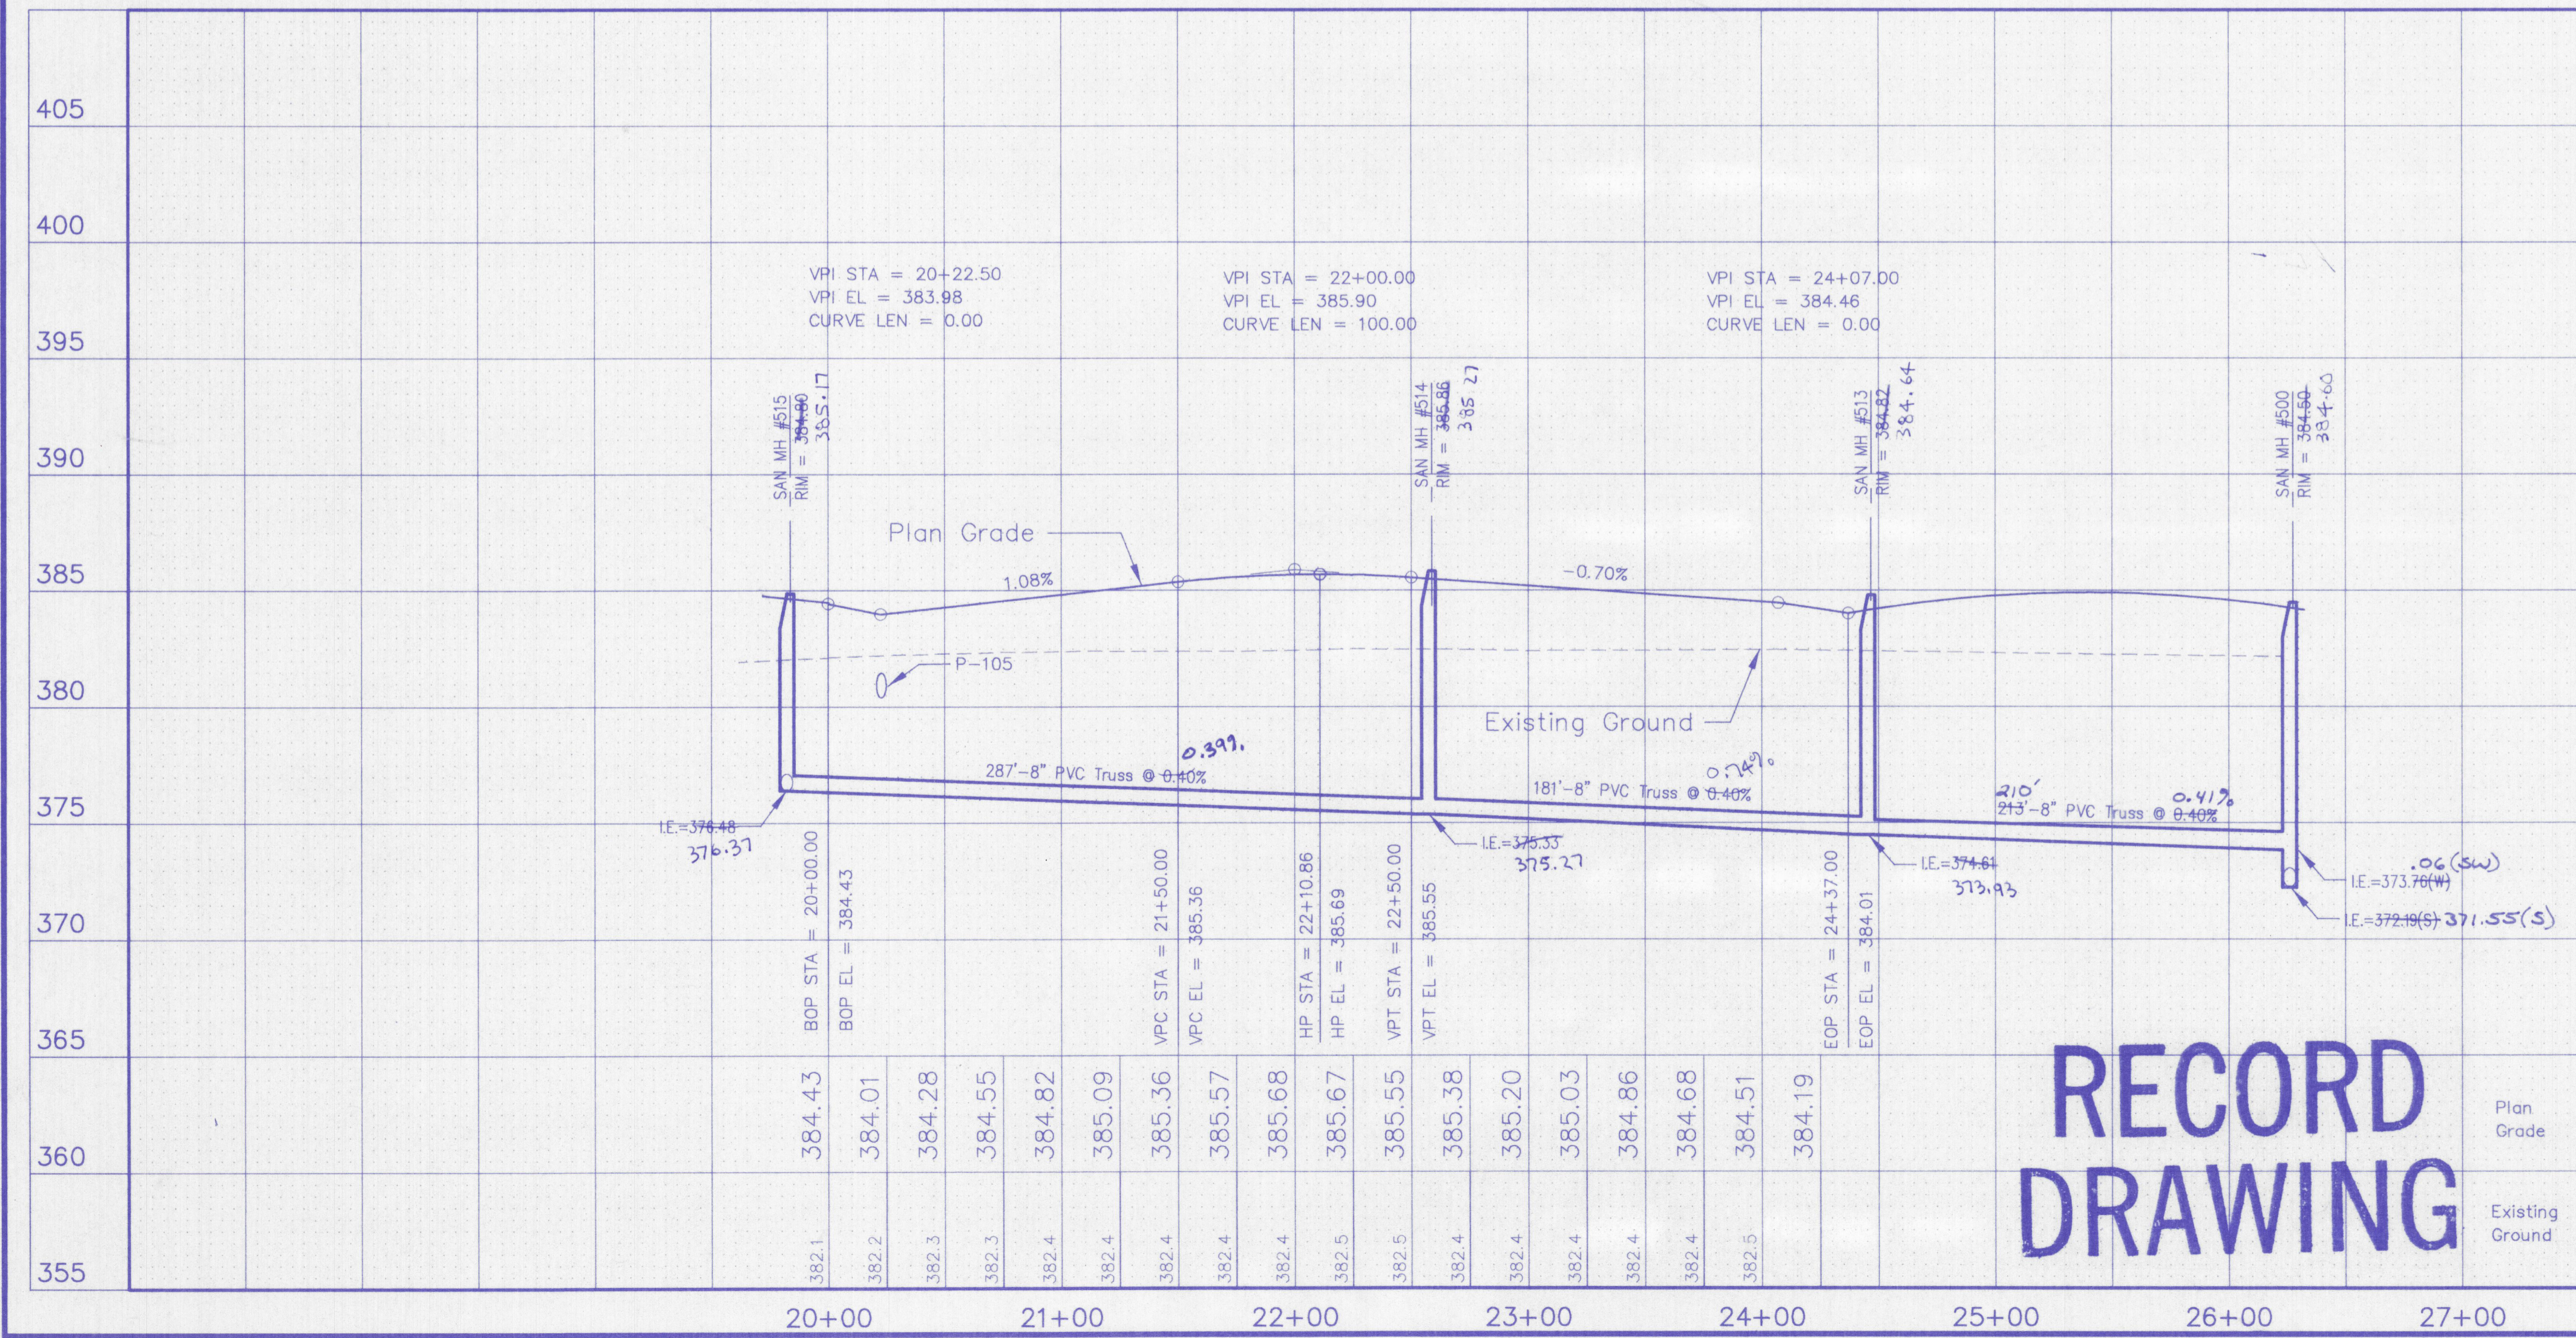

**RECORD
DRAWING**

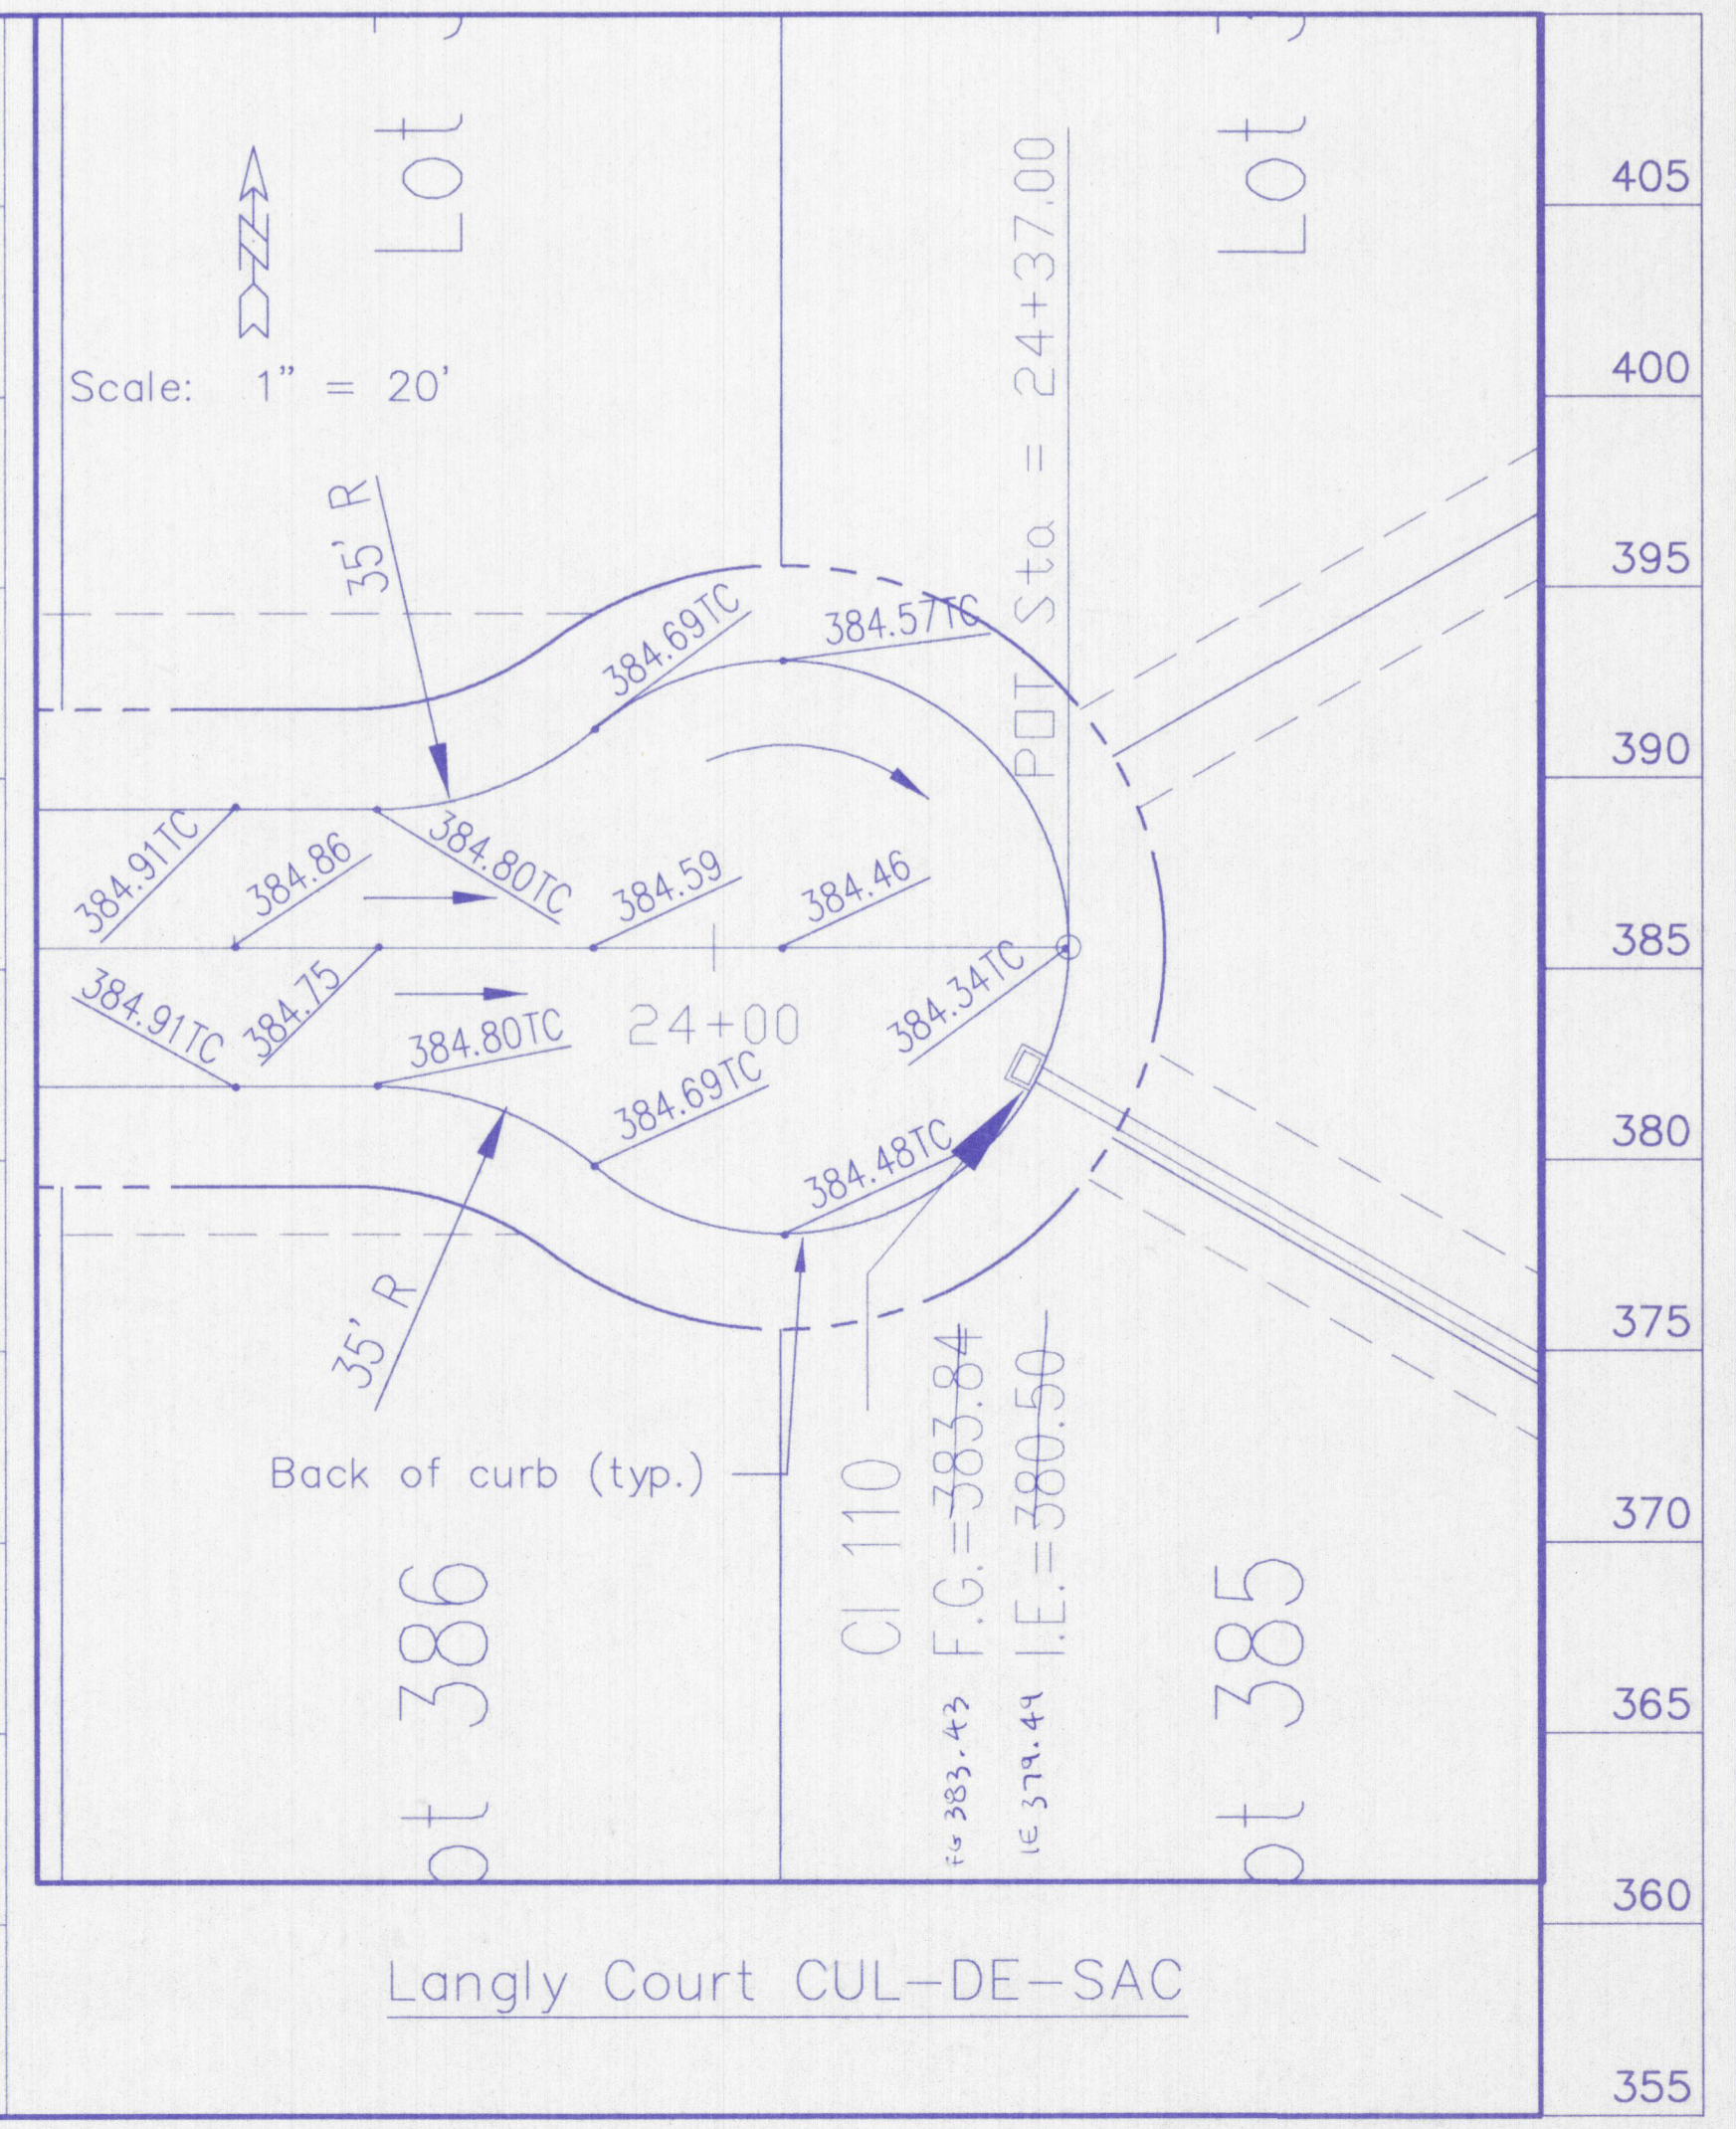

Revisions

No.	By	Date	Description
1	GH	5-13	5" x 11" 3/4" Tr. AS-BUILTS, SEE VIA
2			
3			
4			

Project: Keystone Section VII
 Keystone Development, LLC

Scale: As Shown

Designed By: DWS Job Number: 3998-4
 Drawn By: GAM Date: 9-19-00
 Checked By: Farnsworth/RCp01002.dwg

Sheet Number: C-5 of 18

Professional Engineer
 David W. Schick
 No. 19600175
 STATE OF INDIANA

Morley and Associates, Inc.
 Consulting Engineers/Surveyors/Architects
 600 S.E. Sixth Street
 Evansville, Indiana 47713
 (812) 464-9585