


Saybrook Dr. - Porterfield Dr. Intersection

Scale: 1" = 20'
 SCALES:
 1" = 50' HOR
 1" = 5' VER

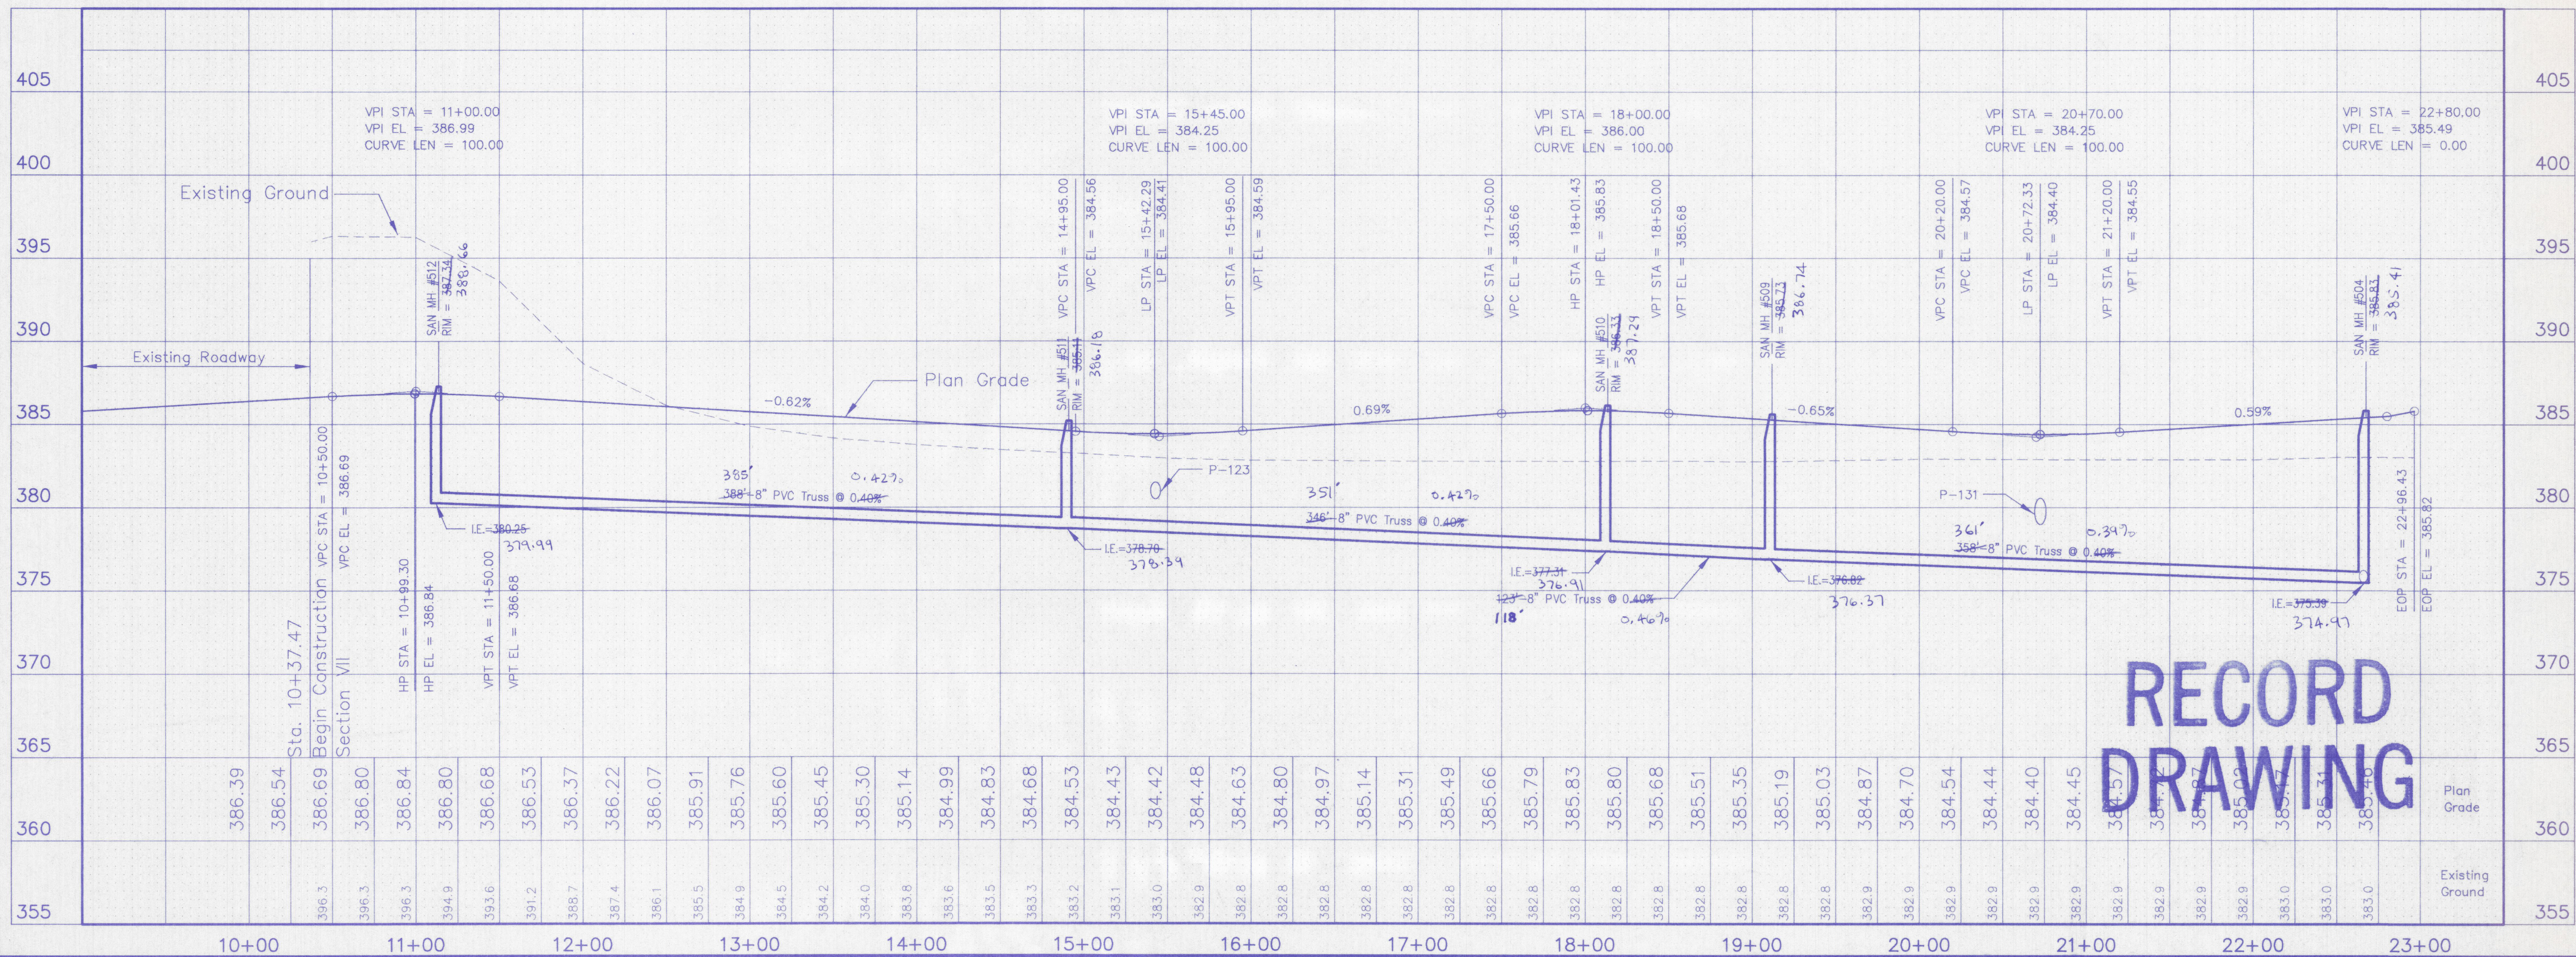


**RECORD
DRAWING**

Morley and Associates, Inc.
 Consulting Engineers/Surveyors/Architects
 600 S.E. Sixth Street
 Evansville, Indiana 47713
 (812) 464-9585

All lines, design, calculations, and arrangements indicated or represented by this drawing are owned by and the property of Morley and Associates, Inc. and were created for the use of and for the benefit of the project and shall not be used, copied, or reproduced in any form, or for any purpose, without the written permission of Morley and Associates, Inc. The contractor shall verify and be responsible for all dimensions and conditions on the job and Morley and Associates, Inc. shall not be held responsible for any errors or omissions on the drawings shown by these drawings.

No.	By	Date	Description
1	GR	6-1-01	Final 50% & 50% BUILTS - SEE V.I.A.

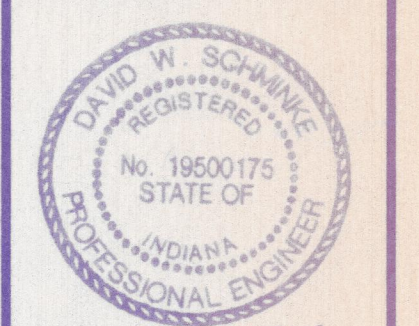

David W. Schwanke

Project: Keystone Section VII
 Keystone Development, LLC
 Sheet Title: Saybrook Drive
 Plan and Profile

Scale: As Shown
Designed By: DWS Job Number: 3998-4
Drawn By: GAM Date: 9-19-00
Checked By: File name: RCP01006.dwg
Sheet Number: C-8 of 18