


# RECORD DRAWING

SECTION ONE  
4-4-95  
SECTION TWO  
9-12-95

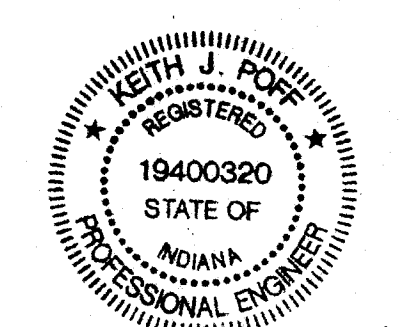

Keith J. Poff