

SANITARY SEWER LATERAL INDEX

Table with columns: LATERAL NUMBER, DOWNSTREAM MANHOLE, DISTANCE TO MANHOLE, LATERAL LN. FEET, LATERAL NUMBER, DOWNSTREAM MANHOLE, DISTANCE TO MANHOLE, LATERAL LN. FEET. Lists various lateral connections and distances.

DRAINAGE SWALE DATA TABLE

Table with columns: SWALE NUMBER, LENGTH, SLOPE, UP STREAM, DOWN STREAM, CONCRETE RIBBON. Lists swale details for various lots.

100 YEAR FLOOD ZONE TABLE

Table with columns: LOTS LOCATED WITHIN 100 YEAR FLOOD ZONE, FLOOD PROTECTION GRADE (FPG). Lists flood protection grades for numerous lots.

1. THE LOWEST FLOOR ELEVATIONS OF ANY ENCLOSED SPACE... 2. ANY GRASSY SPACE LOCATED ON A LOT WITH FPO DESIGNATION...

STORM STRUCTURE DATA TABLE


Large table with columns: STRUCTURE NUMBER, LOCATION, LEFT, RIGHT, CROSS, SIZE, DESCRIPTION, LENGTH, FLOW LINE, SLOPE, AD or Rim or Elev., Cl = FG. Lists storm structure details for various lots and roads.

Table with columns: STRUCTURE NUMBER, LOCATION, LEFT, RIGHT, CROSS, SIZE, DESCRIPTION, LENGTH, FLOW LINE, SLOPE, AD or Rim or Elev., Cl = FG. Lists storm structure details for various lots and roads.

Morley and Associates, Inc. Consulting Engineers/Surveyors/Architects 600 S.E. Sixth Street Evansville, Indiana 47713 (812) 464-9866

All items, designs, calculations, and arrangements indicated by this drawing... are the property of Morley and Associates, Inc.

Revisions table with columns: No., By, Date, Description. Lists revision history.

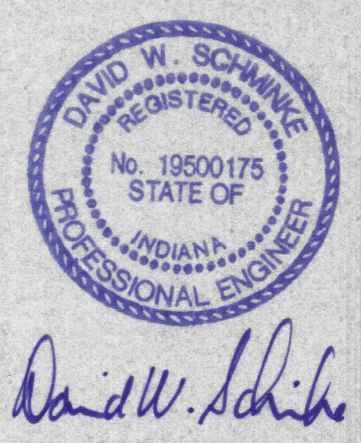

Project: Stonecreek Subdivision - Section Utility/Drainage Plan Data Tables Scale: 1"=50'