

STRUCTURE DATA TABLE

STRUCTURE NUMBER	SIZE	LENGTH	FLOW LINE		SLOPE	Rim = AD Rim = MH FG = CI IE = FES
			UP STREAM	DOWN STREAM		
	in.	ft.	Elev.	Elev.	%	Elev.
Chatteris Road						
C.I. 1025						421.20
P 1026	12	27.65	418.80	418.71	0.33	
C.I. 1027						421.20
P 1028	12	122.94	418.71	417.89	0.67	
FES 1029	12	6.15	417.89	417.85	0.67	417.85


DRAINAGE SWALE DATA TABLE

SWALE NUMBER	LENGTH	SLOPE	FLOW LINE		16"x8" CONCRETE RIBBON
			UP STREAM	DOWN STREAM	
	ft.	%	Elev.	Elev.	
24	133	1.17	422.04	420.48	NO
25	532	2.49	422.04	408.80	NO
26	125	3.56	416.25	411.80	NO
27	131	3.11	411.30	407.72	NO
Seib Rd. Ditch	785	2.05	428.25	412.13	NO

I, James E. Morley, certify and affirm that the completed storm water drainage system for this project generally complies with the Final Drainage Plan as approved by the Vanderburgh County Drainage Board with the following exceptions:
 1) The 2 curb inlets and pipes and the FES are more or less 2.0' lower than designed.

Signature: *[Signature]*
 PE 10100250
 Indiana Registration Number


Engineering
 Surveying
 Architecture
 Construction Management

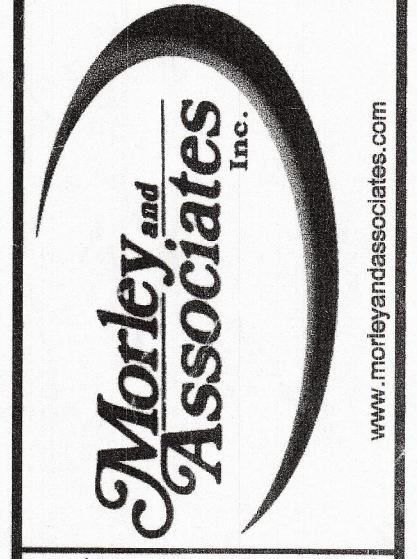

All ideas, designs, calculations, and arrangements indicated or represented by this drawing are the property of Morley and Associates, Inc. and are not to be used for any other project without the written consent of Morley and Associates, Inc. The user of this drawing assumes all liability for any errors or omissions in this drawing. The user of this drawing shall be held responsible for any damages or losses resulting from the use of this drawing. The user of this drawing shall be held responsible for any damages or losses resulting from the use of this drawing.

Revisions

No.	By	Date	Description

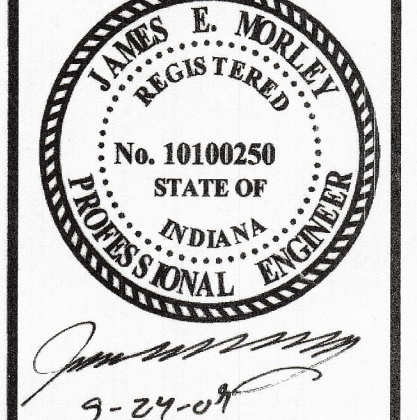

Project Name: Stonecreek Subdivision - Section 8
 Sheet No: 1
Utility/Drainage Plan
 Record Storm Drawing

Scale: 1" = 40'
 Designed By: JEM Job Number: 4255.4.001 H
 Drawn By: BSH Date: 9-24-2009
 Filename: J:\4255\BASERECORDSec8 7-6-2009.dwg
 Sheet Number: 1