

# STONEGATE ESTATES

## RECORD INFORMATION

12-18-07

STONEGATE ESTATES  
(AS BUILTS) Box 17 B-4

### APPROVALS


#### DRAINAGE PLANS

RECOMMENDED BY: Bill Jeffers, Vanderburgh County Surveyor DATE: \_\_\_\_\_  
 VANDERBURGH COUNTY DRAINAGE BOARD

APPROVED BY: Bill Nix DATE: \_\_\_\_\_

APPROVED BY: Cheryl Musgrave DATE: \_\_\_\_\_

APPROVED BY: \_\_\_\_\_ DATE: \_\_\_\_\_

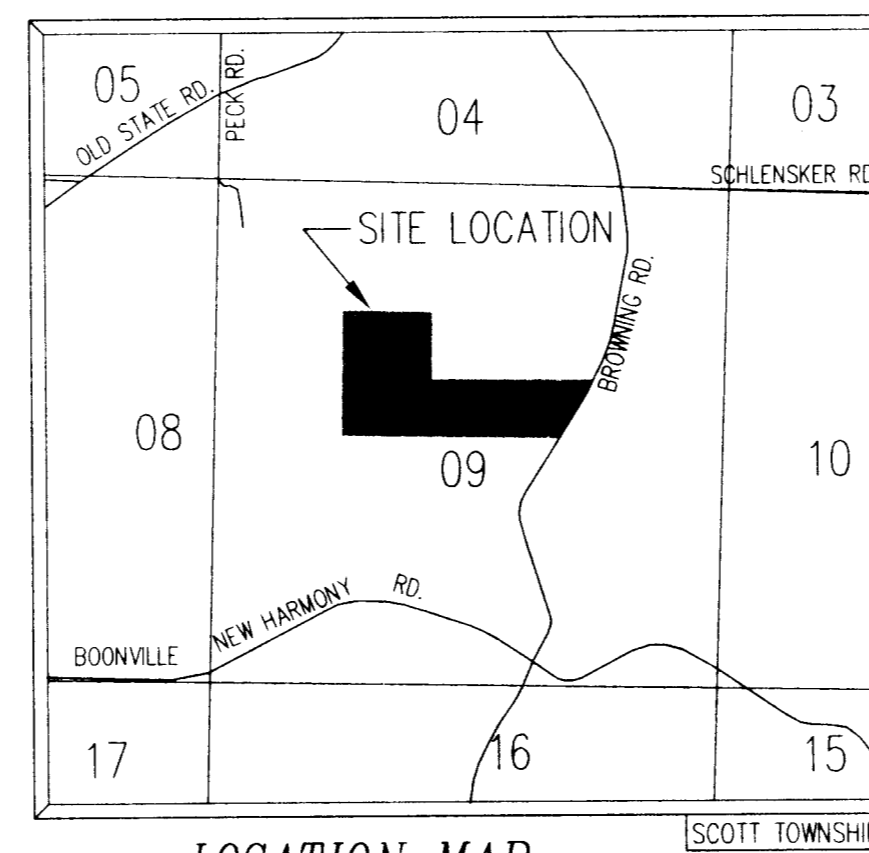

LOCATION MAP  
1"=2000'

### SHEET INDEX

COVER SHEET	PLAT
INDEX	INDEX
DRAINAGE PLAN	DR-1
WATERLINE EXTENSION PLAN	WE-1
PLAN & PROFILE-STREET ONE	RP-1
PLAN & PROFILE-STREET ONE	RP-2
PLAN & PROFILE-STREET TWO	RP-3
STORM WATER POLLUTION PREVENTION PLAN	SWP3
PAVEMENT, ENTRANCE, & INTERSECTION DETAILS	DE-1
STORM SEWER DETAILS	DE-2

#### ROADWAY PLANS

RECOMMENDED BY: John Hall DATE: 12/11/06  
 John Hall, P.E., Vanderburgh County Engineer  
 VANDERBURGH COUNTY COMMISSIONERS

APPROVED BY: Cheryl Musgrave DATE: \_\_\_\_\_

APPROVED BY: Bill Nix DATE: \_\_\_\_\_

APPROVED BY: \_\_\_\_\_ DATE: \_\_\_\_\_

### NOTIFICATION REQUIREMENTS

THE CONTRACTORS SHALL NOTIFY ALL UTILITIES 48 HOURS BEFORE BEGINNING WORK FOR FIELD LOCATIONS. THE UTILITIES TO BE NOTIFIED INCLUDE THE FOLLOWING:

- VECTREN
  - EVANSVILLE WATER & SEWER UTILITY
  - SBC
  - TCI OF EVANSVILLE
- 1-800-382-5544

THE FOLLOWING GOVERNMENTAL AGENCIES SHALL BE NOTIFIED 24 HOURS PRIOR TO BEGINNING WORK AND ON A DAILY BASIS THEREAFTER WHEN PERFORMING THE WORK LISTED BELOW:

- STORM SEWERS, STREET SUBGRADE, & STREETS  
 VANDERBURGH COUNTY ENGINEER 435-5773
- SANITARY SEWERS  
 EVANSVILLE WATER & SEWER UTILITY OPERATIONS DEPT.  
 421-2130

## SITECON, Inc.

Engineers-Surveyors  
 10335 Hedden Road, Suite 2  
 Evansville, Indiana 47725  
 (812) 868-0877

*Ken J. Riff*

RECEIVED

DEC 18 2007

Vanderburgh County Engineering