


FEDERAL ROAD REGION NO.	STATE	PROJECT NO.	FISCAL YEAR	SHEET NO.	TOTAL SHEETS
5	IND.			4	13

PLAN	DATE
BY: S. NOBLE, G. DYLLAWORTH, G. YETTING, B. HENDERSON	
CHECKED BY: S. NOBLE, G. DYLLAWORTH, G. YETTING, B. HENDERSON	
NO. OF WAY CHECKED	
NO. OF WAY CHECKED	

PROFILE	DATE
BY: S. NOBLE, G. DYLLAWORTH, G. YETTING, B. HENDERSON	
CHECKED BY: S. NOBLE, G. DYLLAWORTH, G. YETTING, B. HENDERSON	
STRUCTURE NOTATIONS CHECKED	

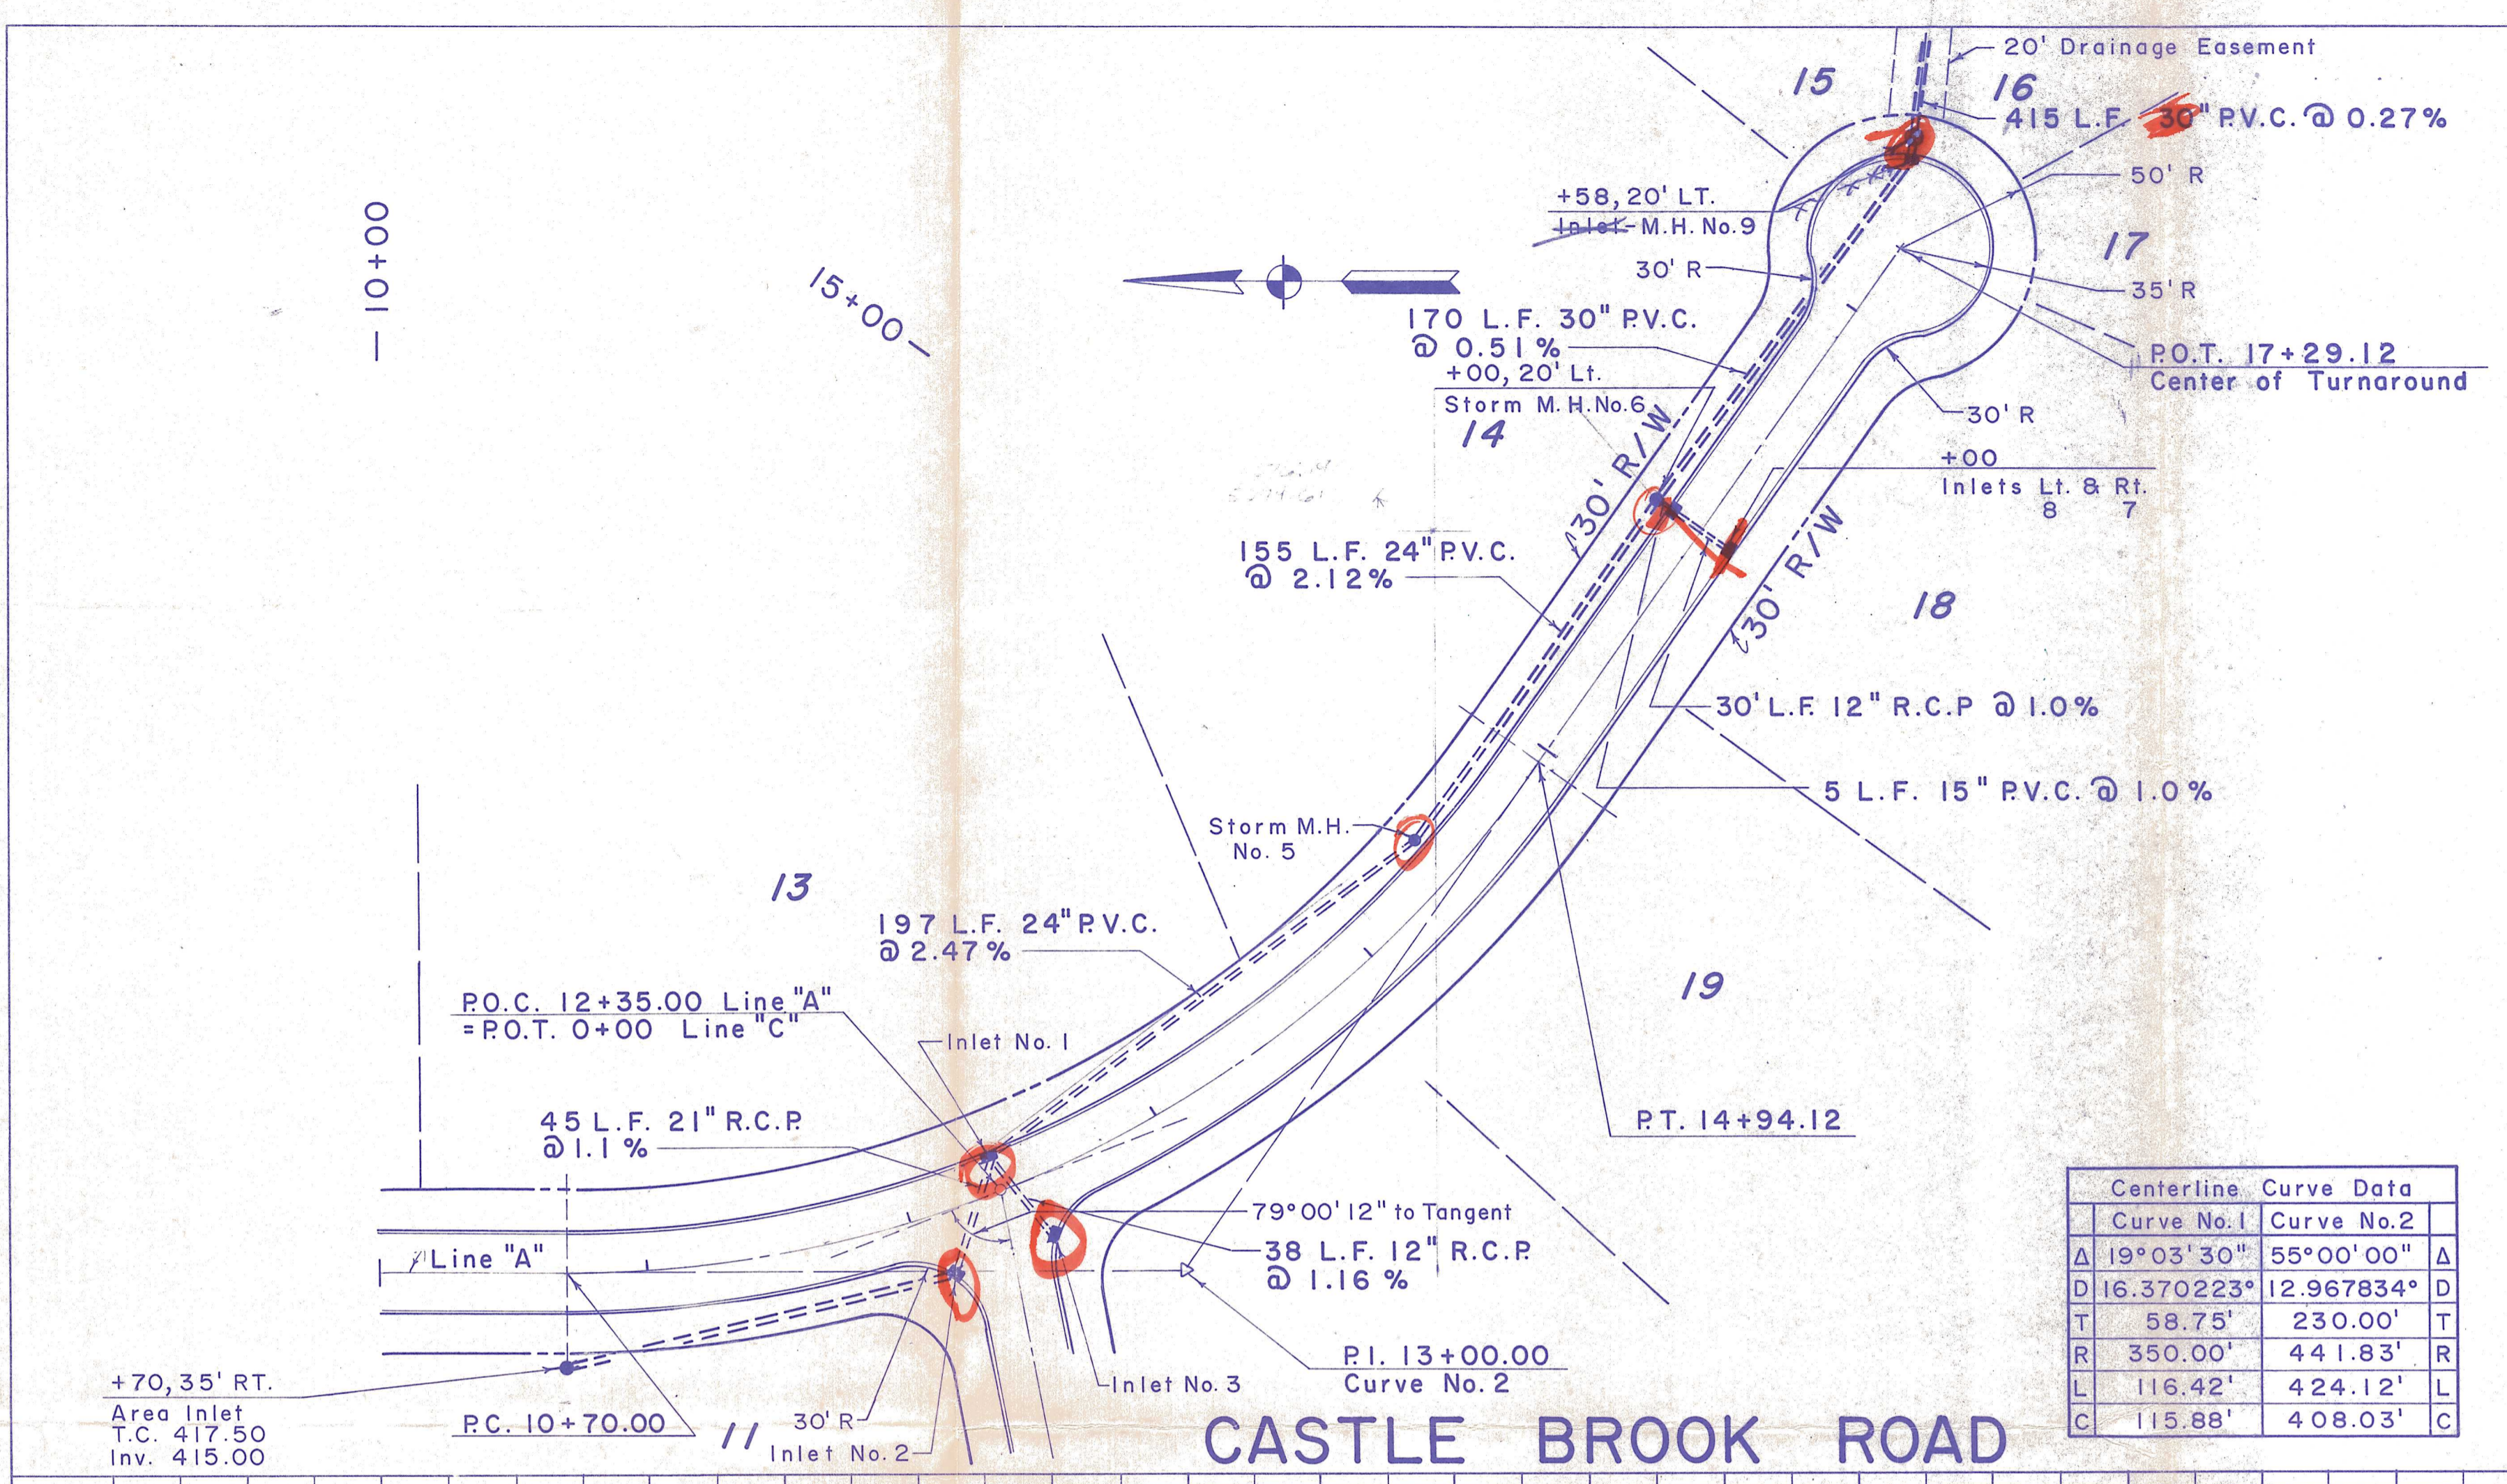

Curve No. 1	Curve No. 2
Δ 19°03'30"	55°00'00"
D 16.370223°	12.967834°
T 58.75'	230.00'
R 350.00'	441.83'
L 116.42'	424.12'
C 115.88'	408.03'

THESE PLANS AS-BUILT

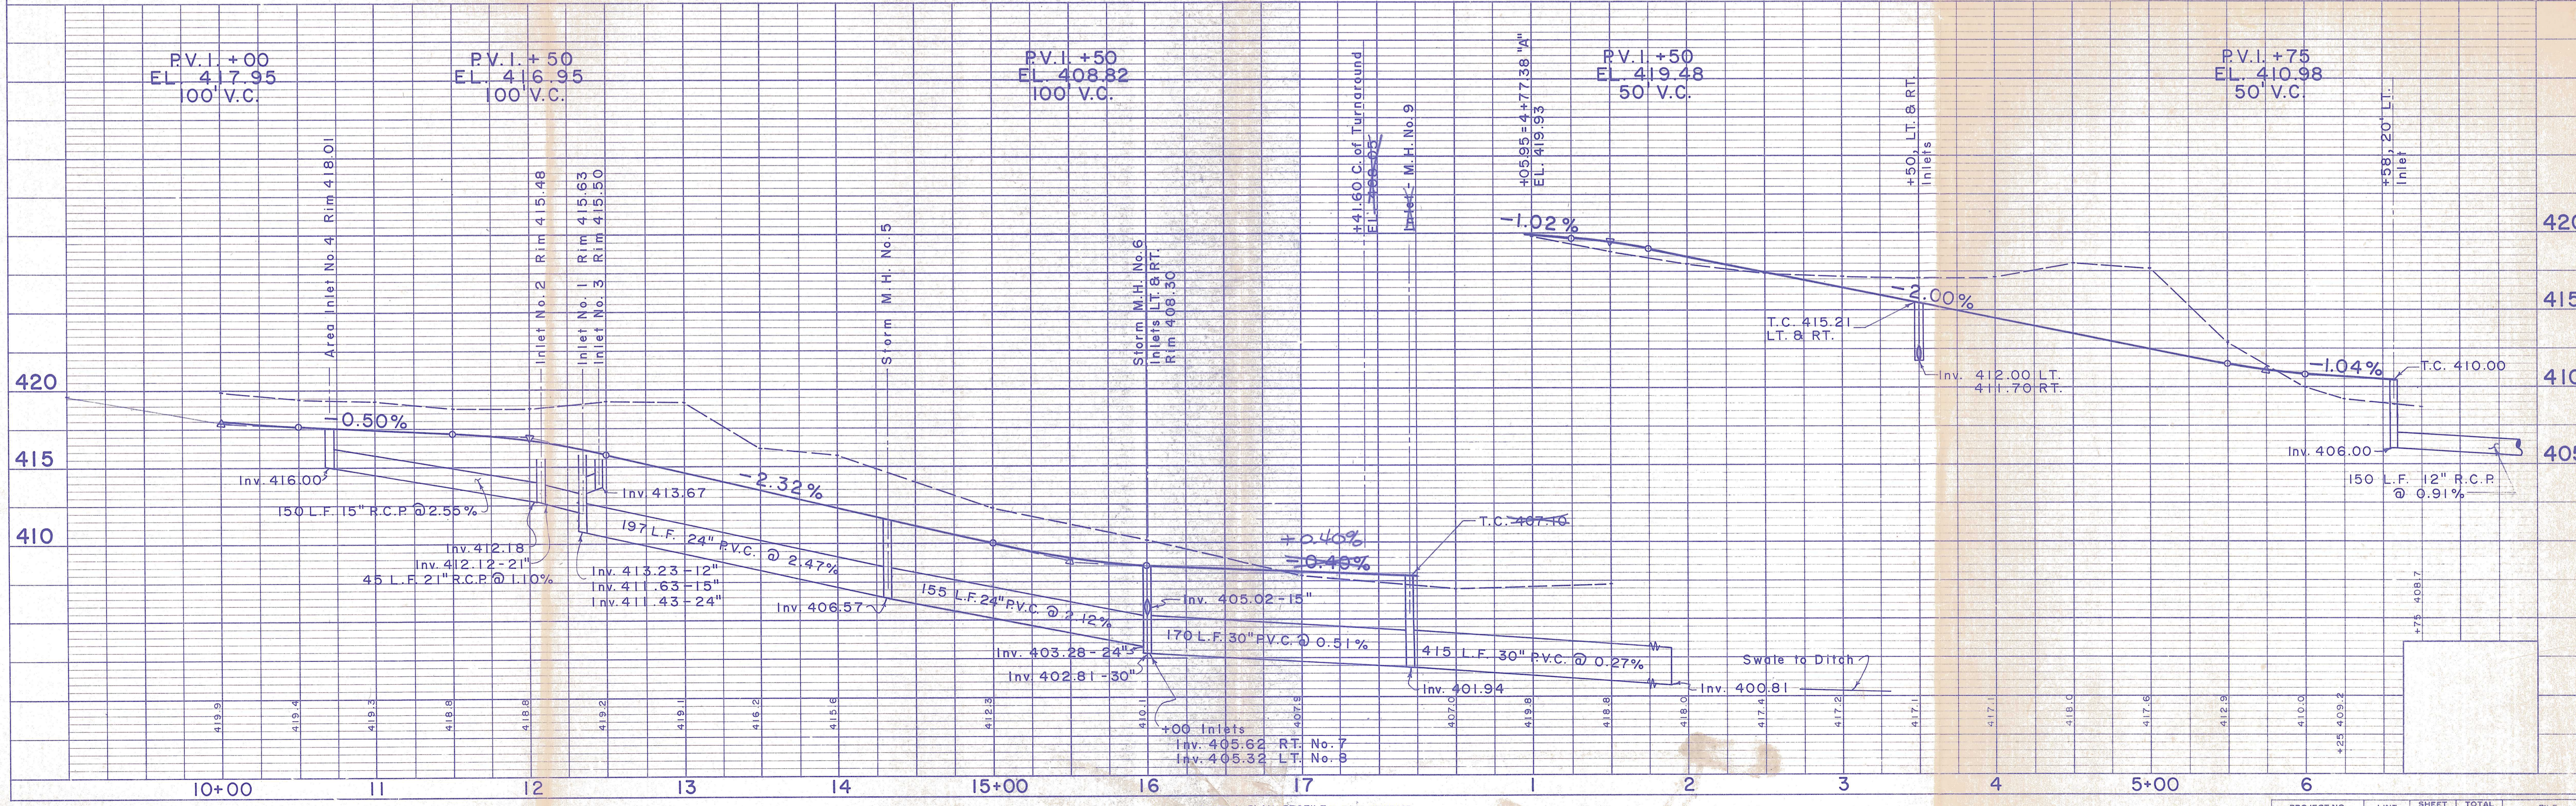
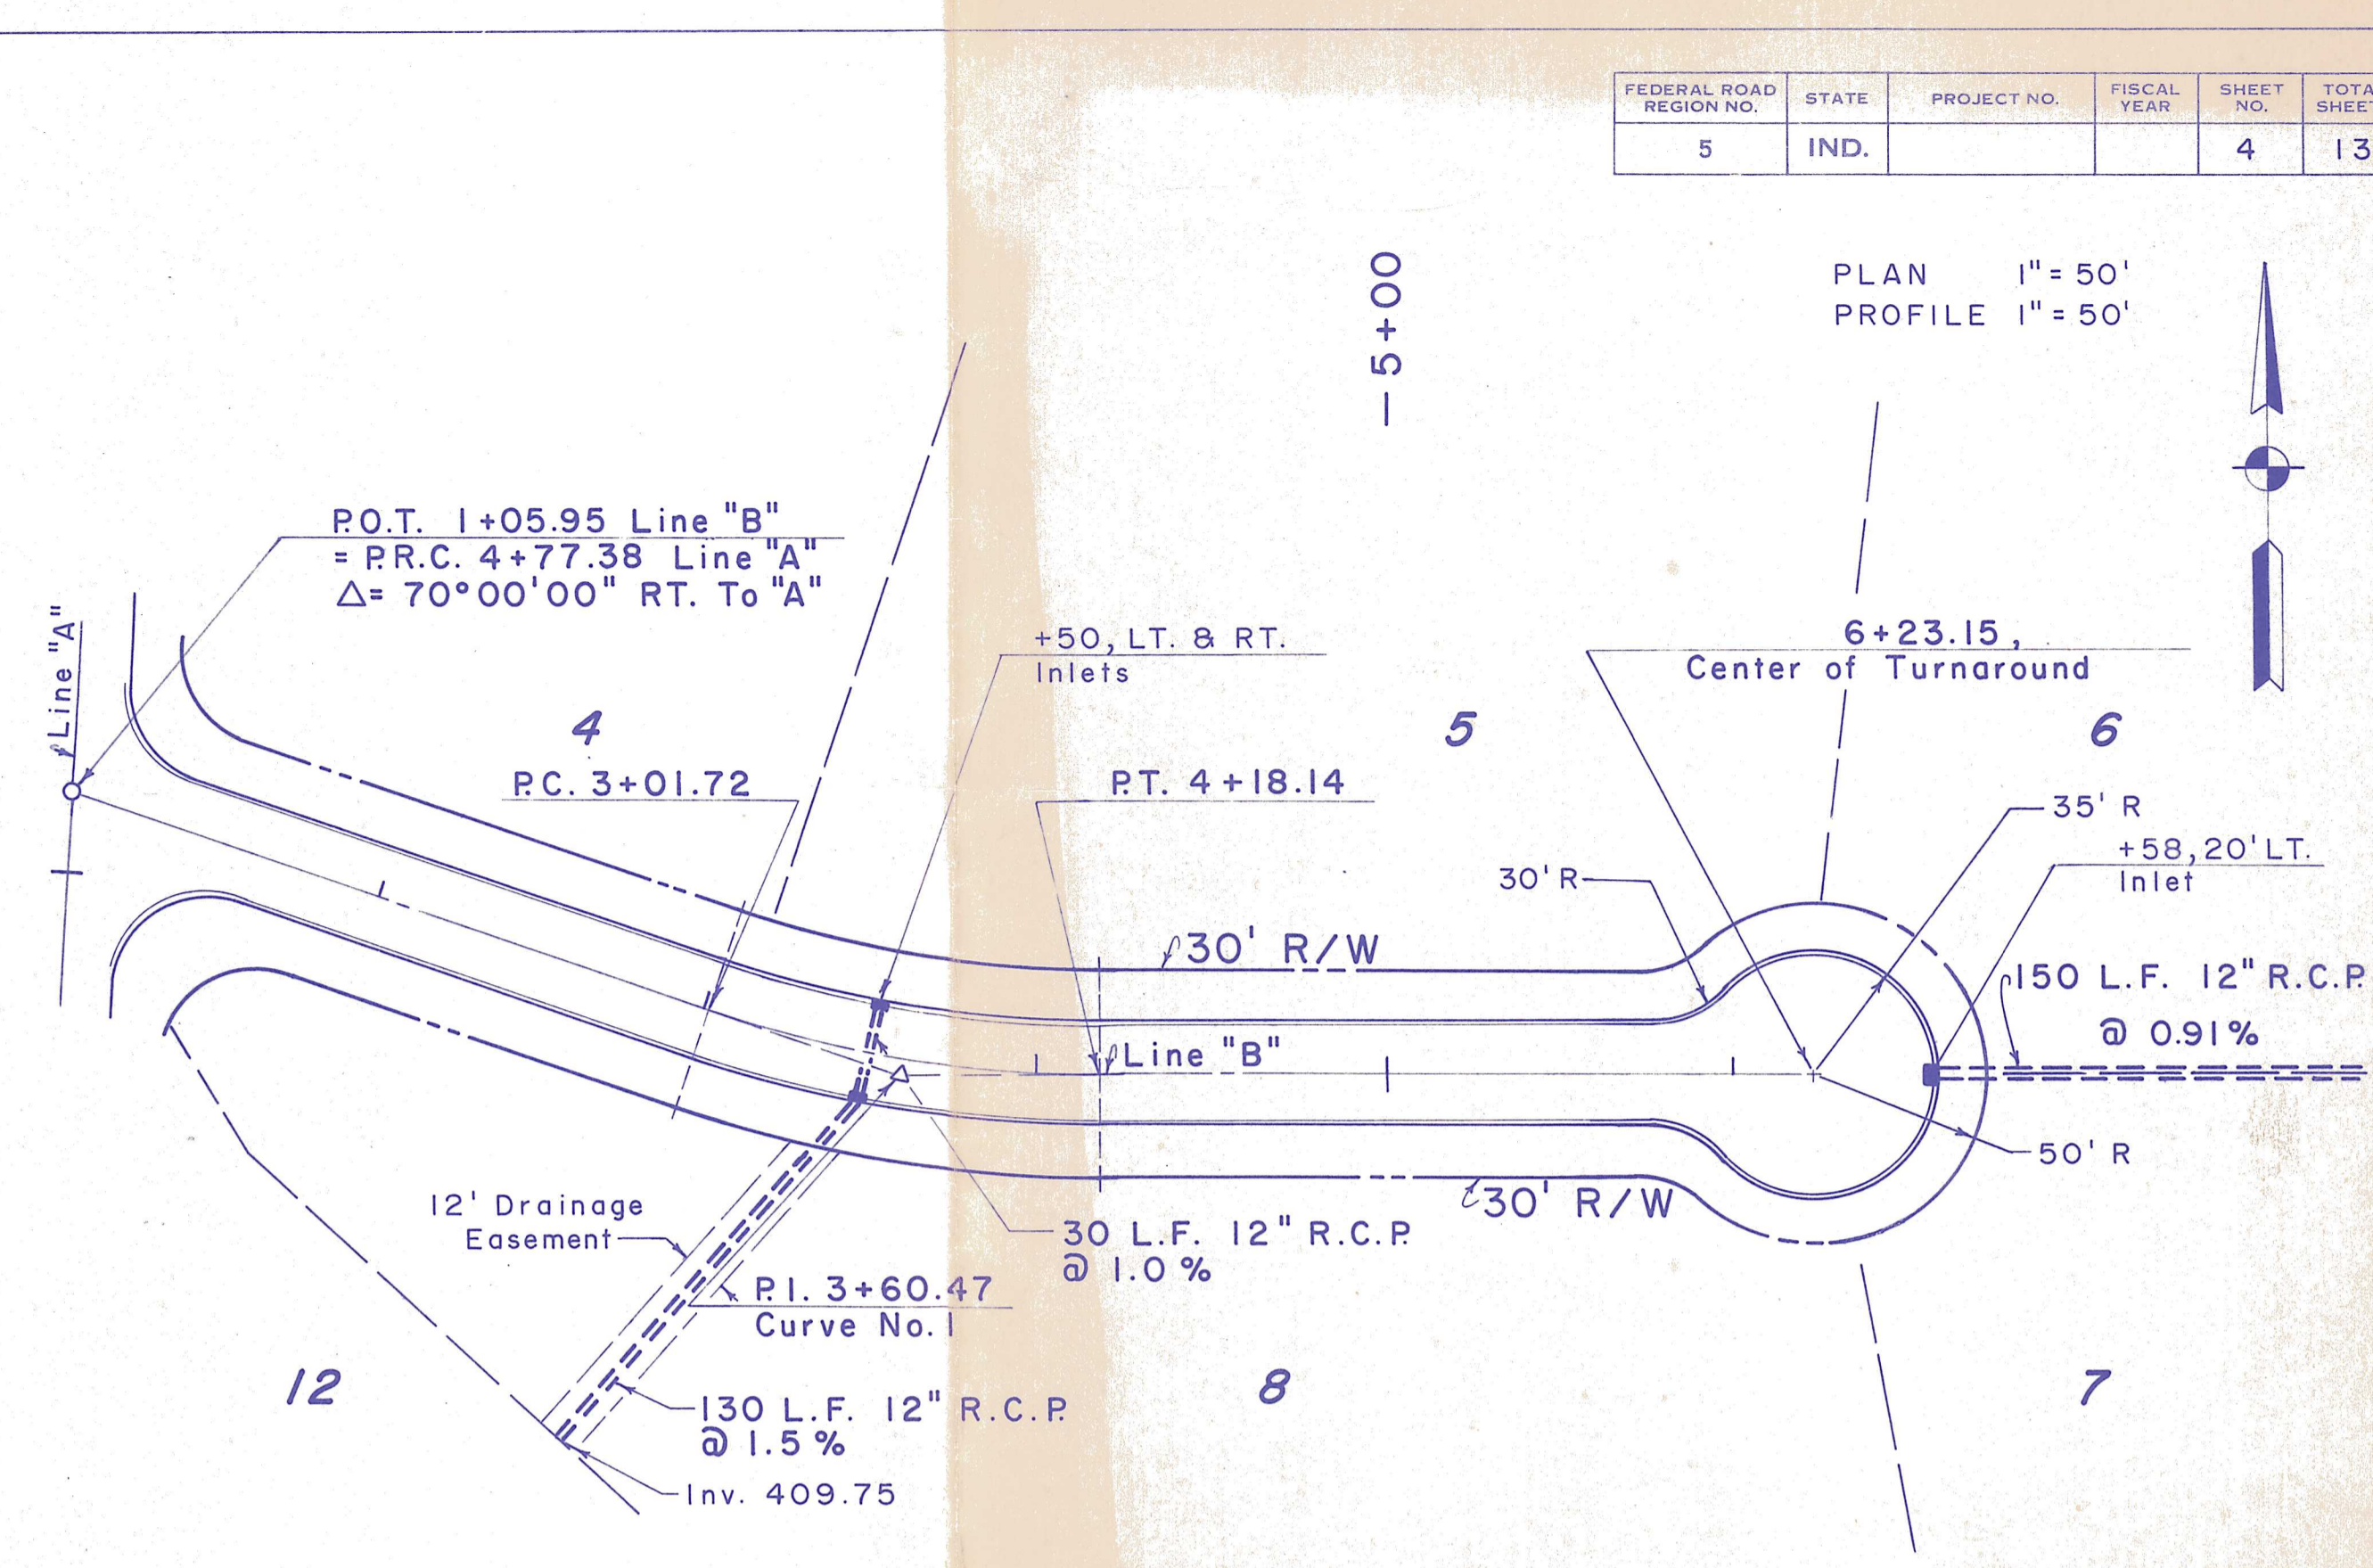


PLATE 1 - PLAN - PROFILE S. R. R. STANDARD 1975

PROJECT NO.	LINE	SHEET NO.	TOTAL SHEETS	FILE
		4	13	