

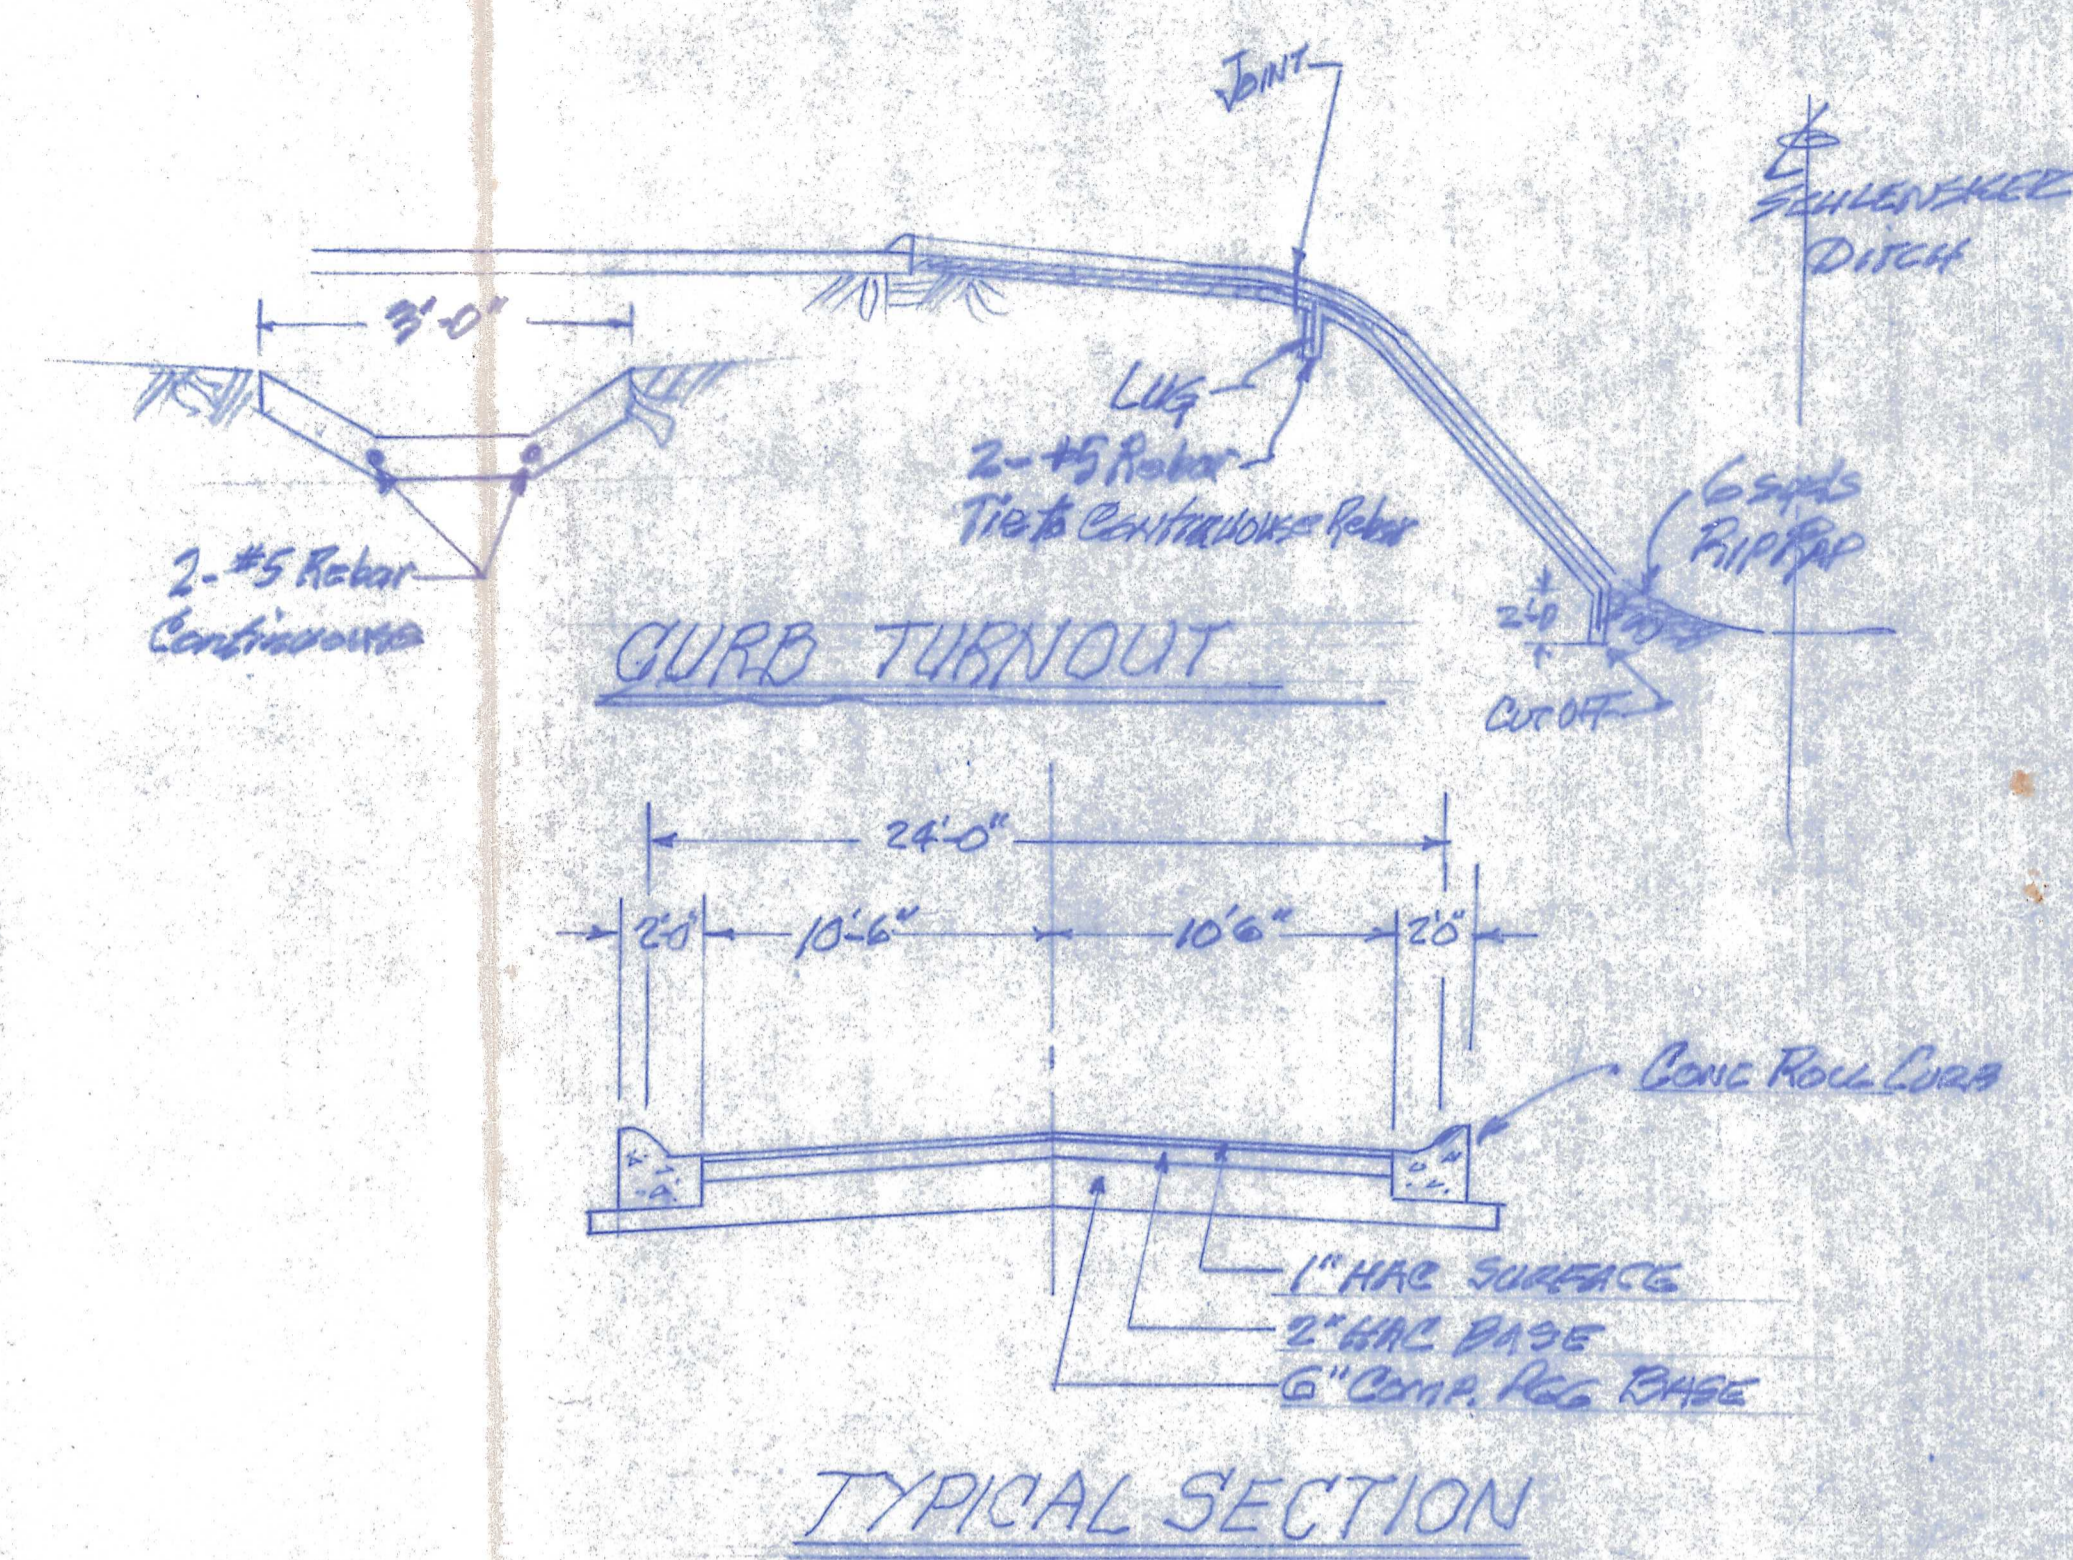


PLAN  
 SURVEYED  
 PLOTTED  
 NOTE BOOK  
 ALIGNED  
 CHECKED  
 NO. OF WKS. CHANGED  
 No.

PROFILE  
 SURVEYED  
 PLOTTED  
 NOTE BOOK  
 GRADES  
 CHECKED  
 STRUCTURE NOTATIONS  
 CHECKED  
 No.

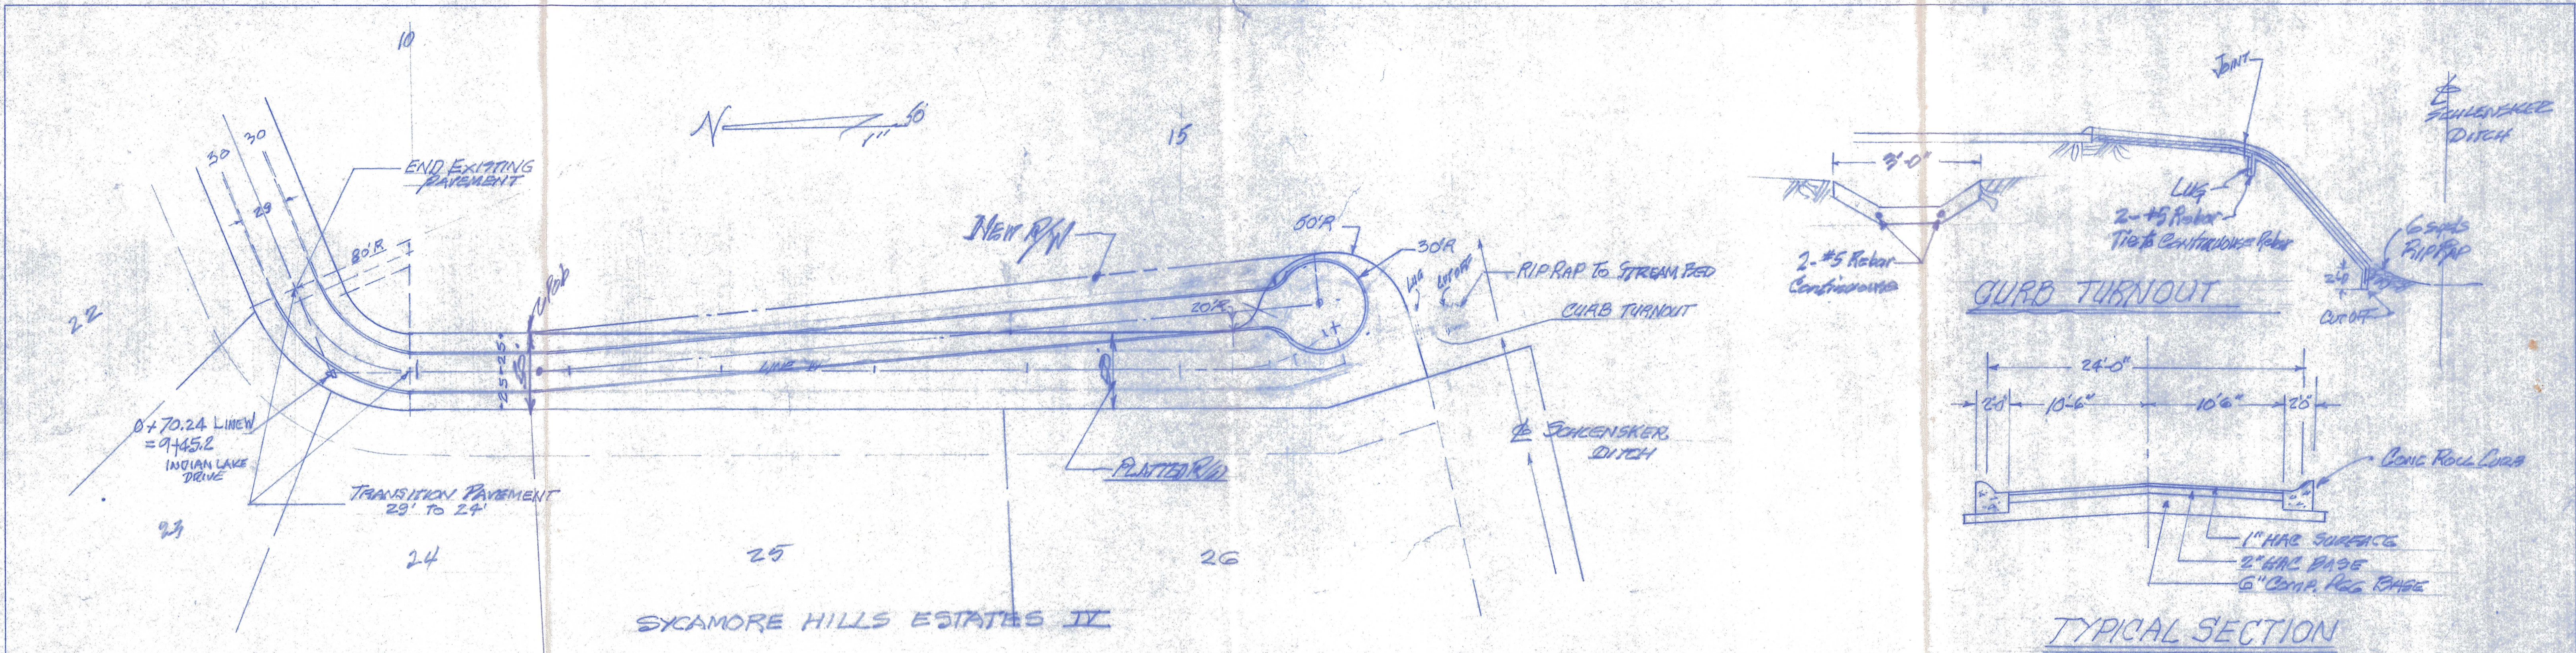

"AS BUILT" 100% PLAN  
 SADDLE BROOK ROAD

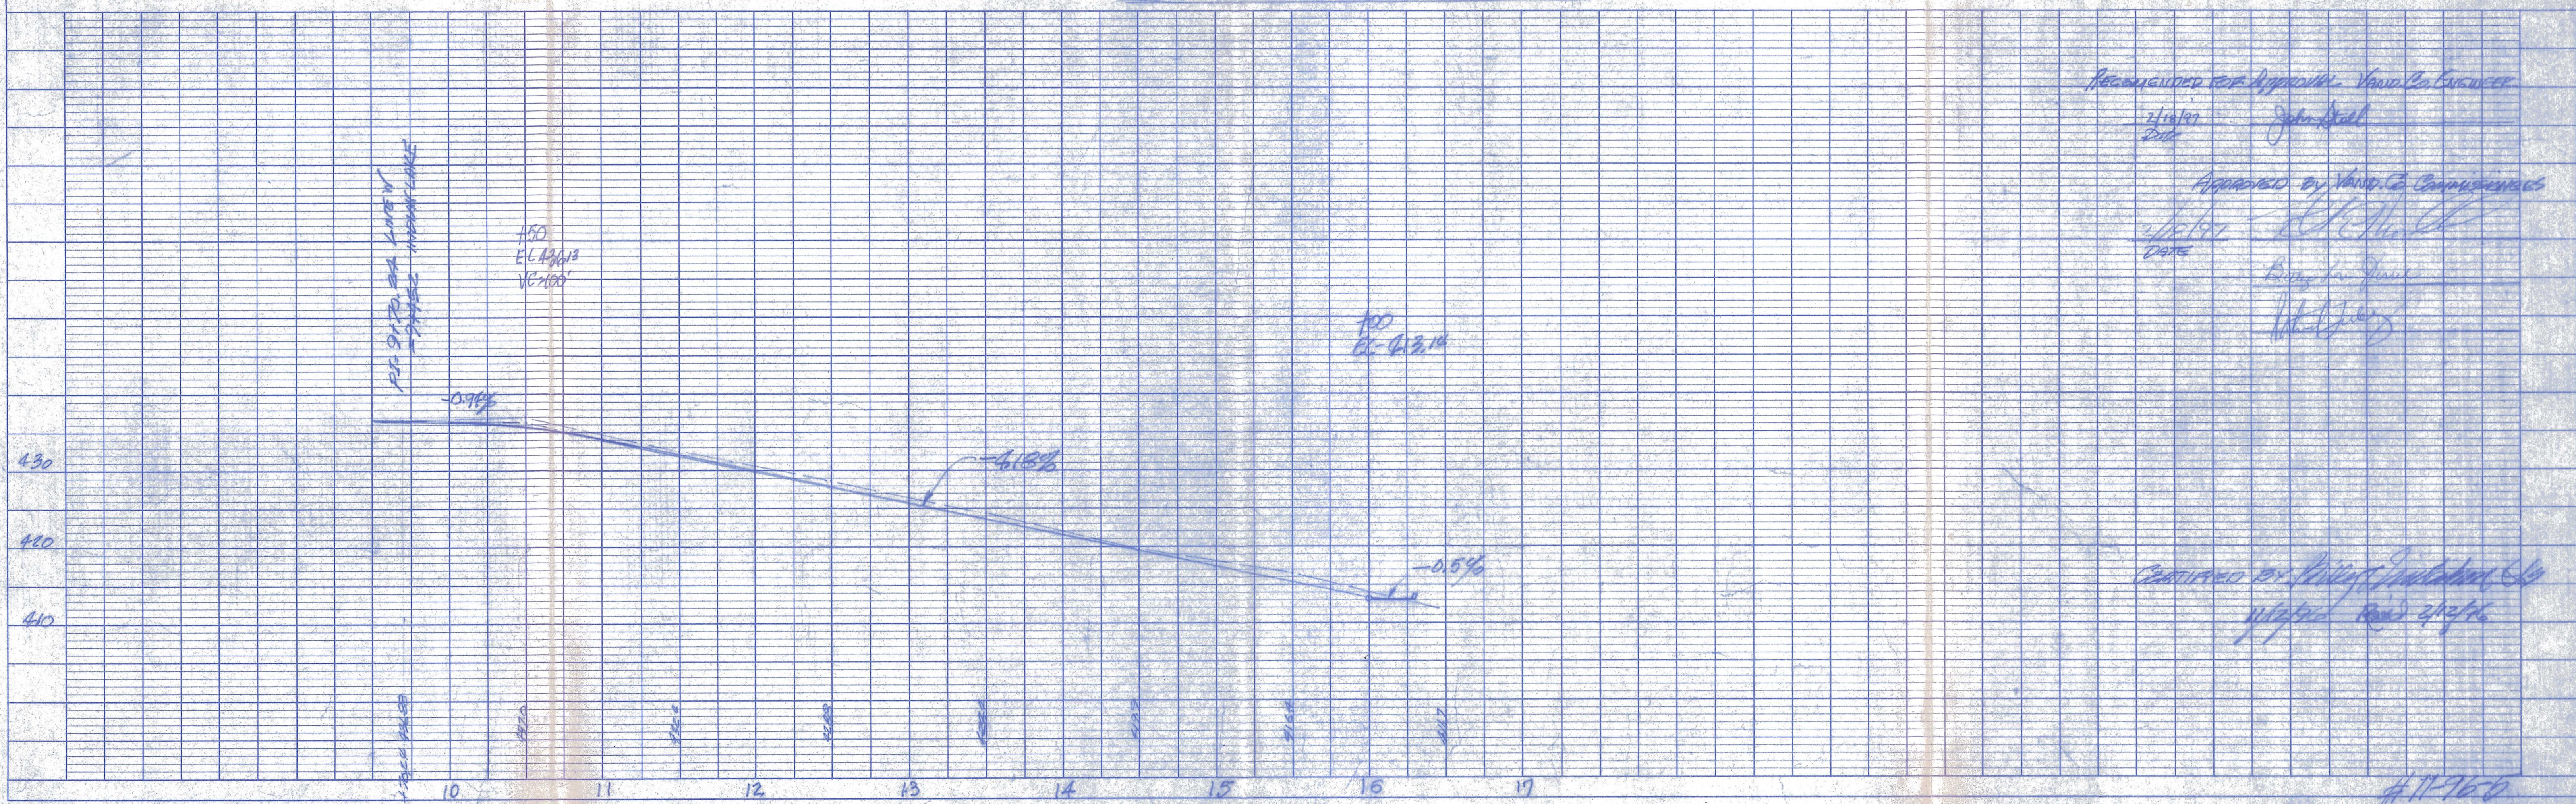

Recommended for Approval: *Veronica G. Cummings*  
 Date: *John D. Hill*  
 Approved by: *Veronica G. Cummings*  
 Date: *John D. Hill*  
 Checked by: *John D. Hill*  
 Date: *John D. Hill*  
 Checked by: *John D. Hill*  
 Date: *John D. Hill*

#11960