


**CURVE DATA TABLE**

NO.	RADIUS	DELTA	LENGTH	CHORD	TANGENT
4	99.14'	53°31'36"	92.62'	N08°44'40"W 89.29'	50.00'
5	139.60'	56°29'32"	137.65'	N61°45'15"W 132.14'	75.00'

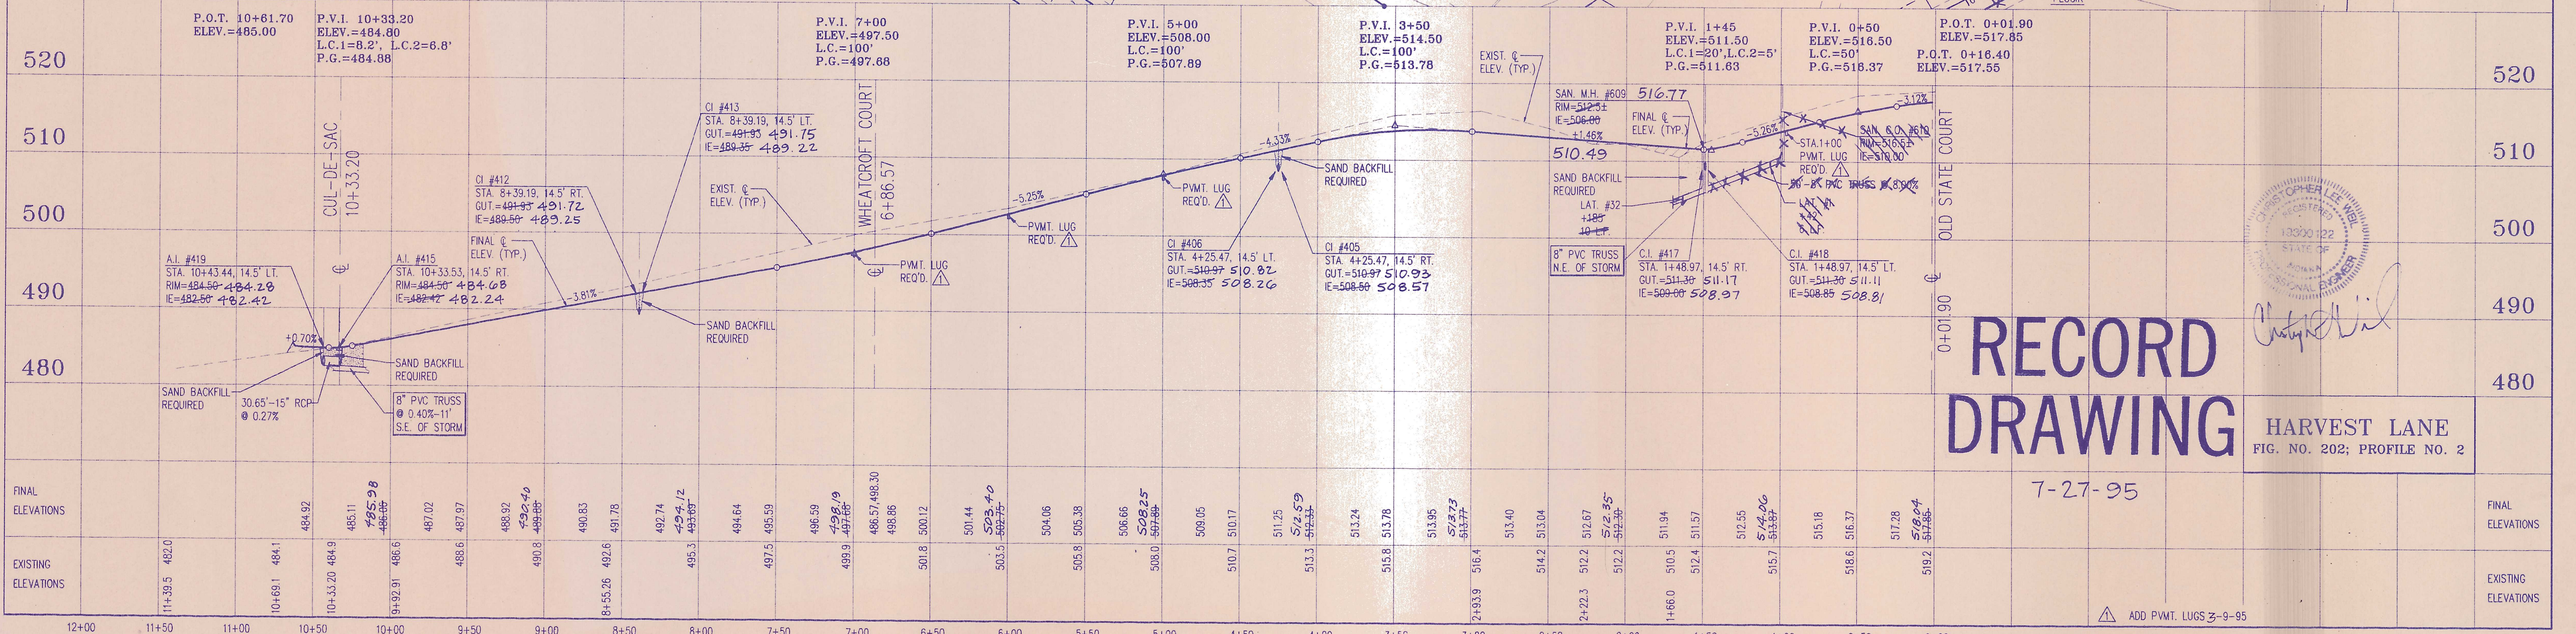

**RECORD DRAWING**  
 HARVEST LANE  
 FIG. NO. 202; PROFILE NO. 2

7-27-95

