

**AFFIRMATION STATEMENT**  
I AFFIRM, UNDER THE PENALTIES OF PERJURY, THAT I HAVE TAKEN REASONABLE CARE TO REDACT EACH SOCIAL SECURITY NUMBER IN THIS DOCUMENT, UNLESS REQUIRED BY LAW.


SIGNATURE: *Scott D. Buedel*  
PRINTED NAME: **Scott D. Buedel**

**CASH WAGGNER & ASSOCIATES, P.C.**  
CONSULTING ENGINEERS - LAND SURVEYORS  
WWW.CASHWAGGNER.COM

414 CITADEL CIRCLE SUITE B  
EVANSVILLE, IN 47715  
PH: 812.401.5561



332 THIRD AVENUE SUITE 13  
JASPER, IN 47546  
PH: 812.634.5015

**T-167**  
Apc # 3-5-2011  
\* CORRECTED STREET NAME FOR WATERSHIP DRIVE  
RE: T-166

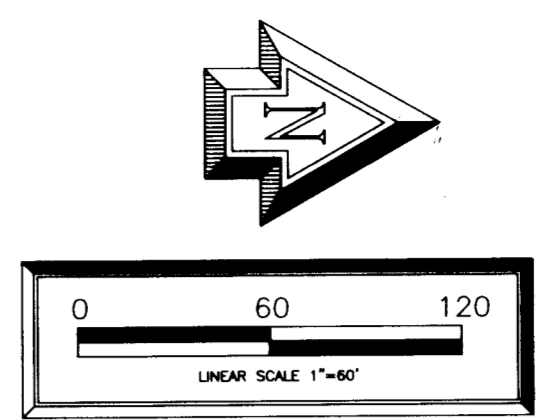

DULY ENTERED FOR TAXATION SUBJECT TO FINAL ACCEPTANCE FOR TRANSFER  
DATE **03.17.15** 3:43p  
PLAT BOOK **T**  
PAGE **167**  
INSTR# **2015R000589**  
Z TULEY RECORDER  
VANDERBURGH COUNTY

**POET SQUARE SECTION 3**  
CORRECTED PLAT

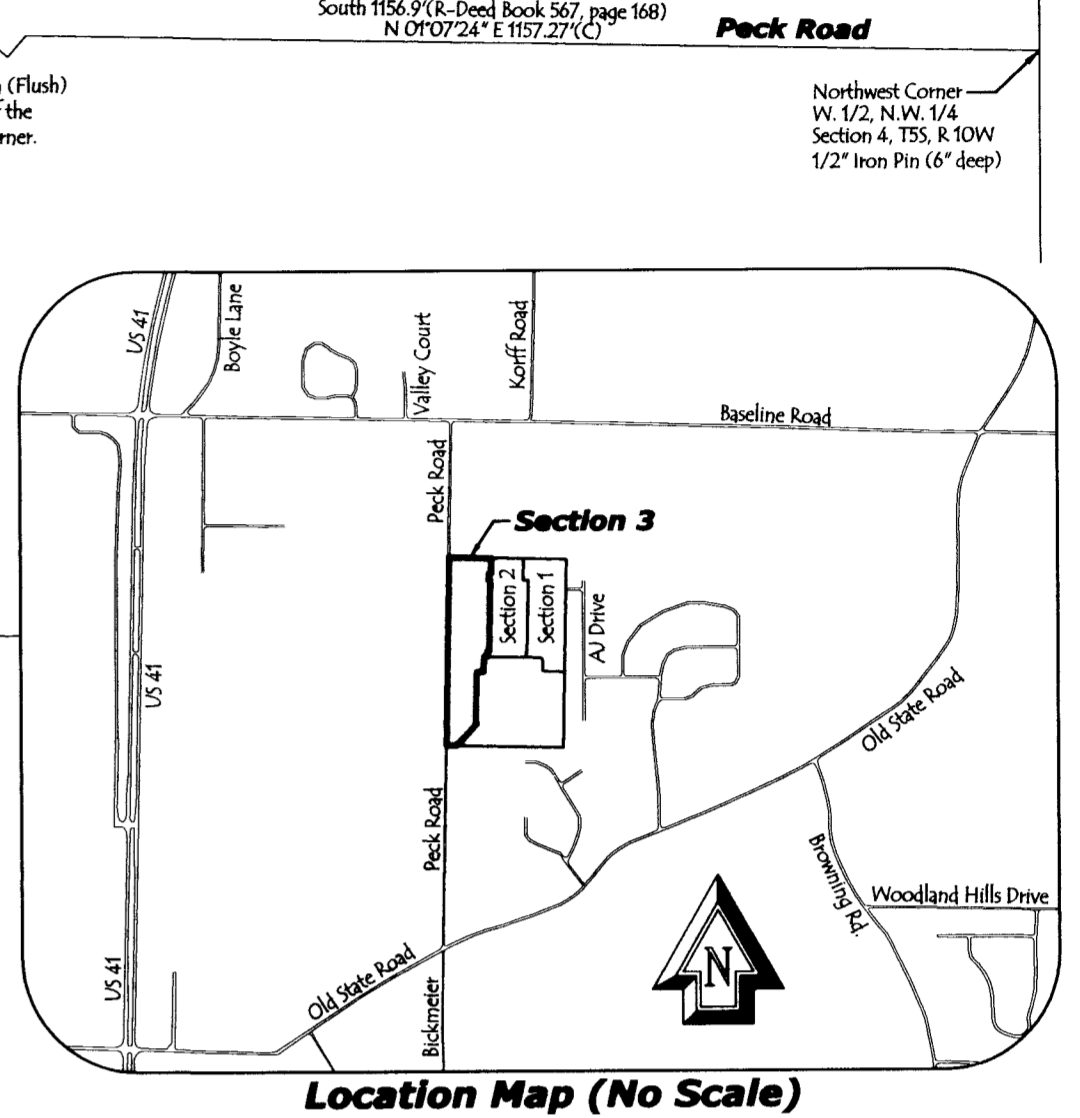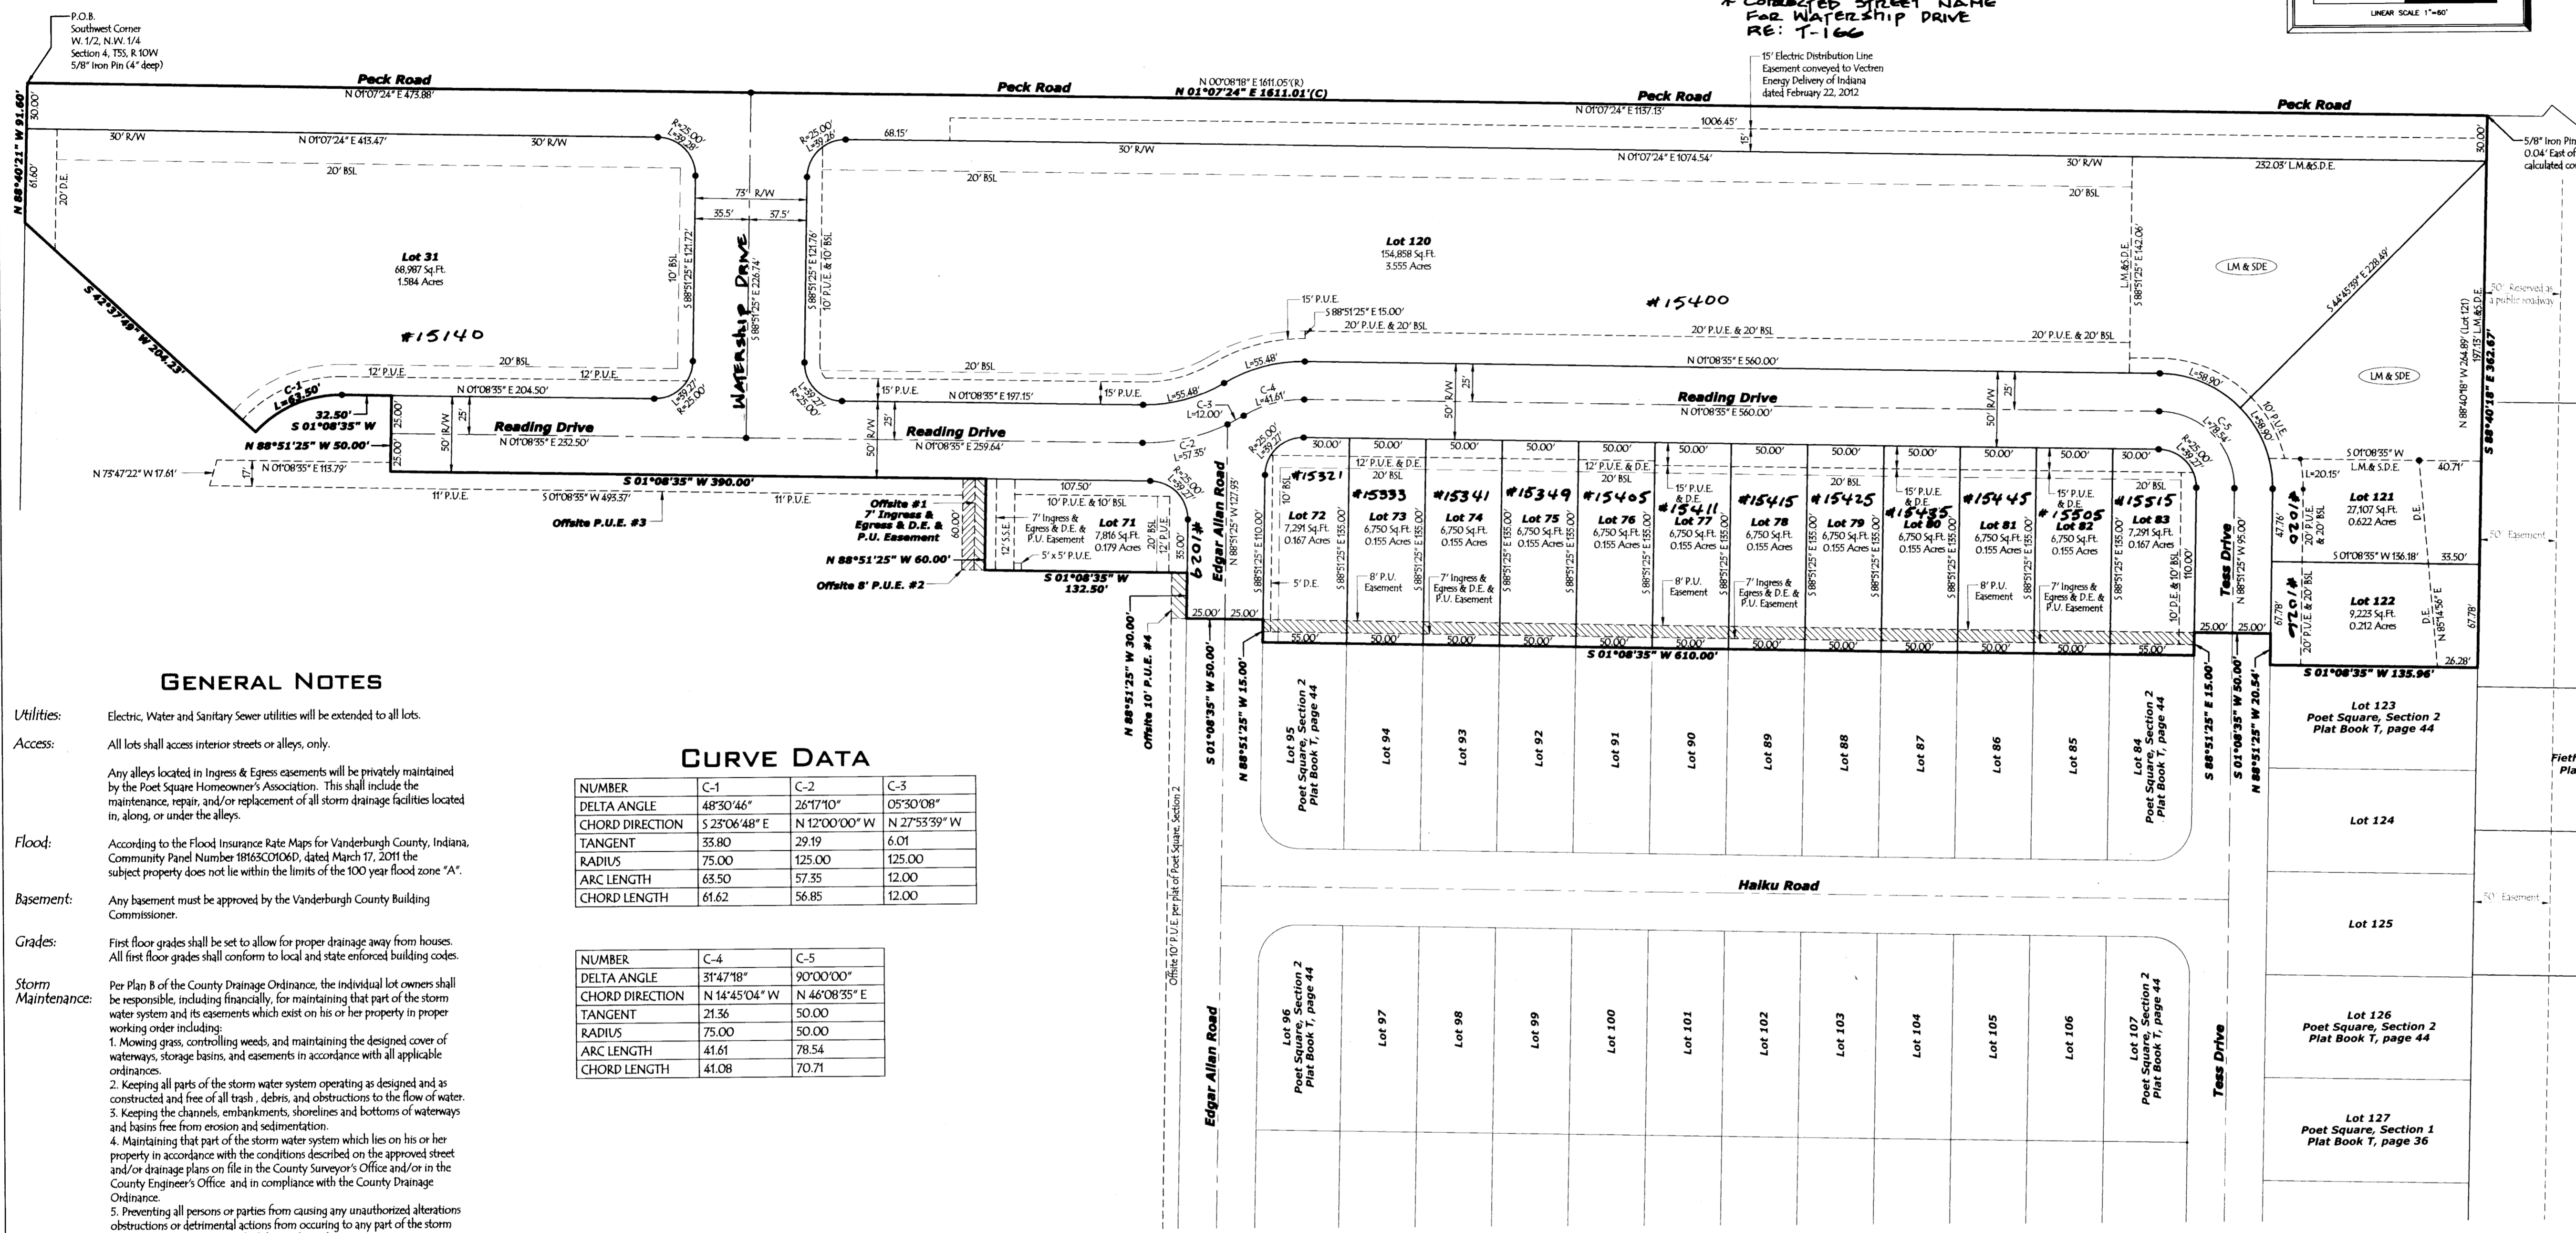

**GENERAL NOTES**

**Utilities:** Electric, Water and Sanitary Sewer utilities will be extended to all lots.

**Access:** All lots shall access interior streets or alleys, only.

**Flood:** According to the Flood Insurance Rate Maps for Vanderburgh County, Indiana, Community Panel Number 08155C(0106), dated March 17, 2011 the subject property does not lie within the limits of the 100 year flood zone "A".

**Basement:** Any basement must be approved by the Vanderburgh County Building Commissioner.

**Grades:** First floor grades shall be set to allow for proper drainage away from houses. All first floor grades shall conform to local and state enforced building codes.

**Storm Maintenance:** Per Plan B of the County Drainage Ordinance, the individual lot owners shall be responsible, including financially, for maintaining that part of the storm water system and its appurtenances which exist on his or her property in proper working order including:

- Mowing grass, controlling weeds, and maintaining the designed cover of waterways, storage basins, and easements in accordance with all applicable ordinances.
- Keeping all parts of the storm water system operating as designed and as constructed and free of all trash, debris, and obstructions to the flow of water.
- Keeping the channels, embankments, shorelines and bottoms of waterways and basins free from erosion and sedimentation.
- Maintaining that part of the storm water system which lies on his or her property in accordance with the conditions described on the approved street and/or drainage plans on file in the County Surveyor's Office and/or in the County Engineer's Office and in compliance with the County Drainage Ordinance.
- Preventing all persons or parties from causing any unauthorized alterations or obstructions or detrimental actions from occurring to any part of the storm water system and easement which lies on his or her property.
- The Repair Fund established for this project will pay the costs of repairing structural failures in the storm sewer pipes, pipe collars, drop boxes, aprons, inlets, manholes, junction boxes and the piped or paved outlet structures of the storm water control basins, all of which are parts of the approved and constructed storm water drainage system shown on the as-built plans for this subdivision and which are in drainage easements, combined drainage and public utility easements or lake maintenance and storm drainage easements and outside of the county accepted road right-of-way as shown on the plat of this subdivision. The Repair Fund will not pay for any of the cost to repair or replace any storm drainage facilities located in, along or under the alleys located in the combined Ingress & Egress & D.E. & P.U. Easements.

**CURVE DATA**

NUMBER	C-1	C-2	C-3
DELTA ANGLE	48°50'48"	26°17'10"	05°30'08"
CHORD DIRECTION	S 2°30'48" E	N 12°00'00" W	N 27°53'39" W
TANGENT	33.80	29.19	6.01
RADIUS	75.00	125.00	125.00
ARC LENGTH	63.50	57.35	12.00
CHORD LENGTH	61.62	56.85	12.00

NUMBER	C-4	C-5
DELTA ANGLE	31°47'19"	90°00'00"
CHORD DIRECTION	N 14°45'04" W	N 46°08'35" E
TANGENT	21.56	50.00
RADIUS	75.00	50.00
ARC LENGTH	41.61	78.54
CHORD LENGTH	41.08	70.71

**Temporary Erosion Control:** For subdivisions where the land disturbance is in excess of one acre, a Storm Water Pollution Prevention Plan must be submitted in accordance with Vanderburgh County Code Title 15.05 "Construction Site Storm Water Runoff Control". All temporary and permanent erosion control measures must be implemented as described in the Storm Water Pollution Prevention Plan for the project site. For subdivisions where the land disturbance is less than one acre, temporary stabilization as described in section 15.05.11.C.16 of the Vanderburgh County Code must be provided if unvegetated areas are scheduled or likely to be left inactive for 15 days or more. When land disturbance activities have been completed, final stabilization shall be completed as described in section 15.05.11.C.20 of the Vanderburgh County Code.

**Survey:** Bearings shown on this plat are based on Indiana State Plane Coordinates, NAD 1983. The overall boundary of this subdivision is based on a Parcelization Plat prepared by Kuester on May 17, 2005 and last revised on June 6, 2005. Minor modifications were made to the Parcelization plat to match found monuments as noted.

**Monuments:** Monuments either exist as noted or have been set at all exterior boundary corners and interior lot corners. Monuments set are 5/8" Rebar with plastic cap stamped "Cash Waggoner & Associates #0096".

**Approval Dates:** Road Plans approved by the Vanderburgh County Commissioners on 10/11/11. Drainage Plans approved by the Vanderburgh County Commissioners on 10/10/11. Sewer Plans approved by the Evansville Water and Sewer Utility on 12/11/12. Water Plans approved by the Evansville Water and Sewer Utility on 9/3/15.

**OWNER'S CERTIFICATE**

The undersigned owners of the real estate shown and described herein do hereby plat and subdivide said real estate as shown and designate the same as **Poet Square, Section 3**. All road right-of-ways shown and not previously dedicated are hereby dedicated to public use.

Stips or areas of land, of the dimensions shown on this plat and marked "P.U.E." (Public Utility Easement), are hereby dedicated to public utilities for the installation, maintenance, operation, engagement and repair of utility facilities, whether above ground or below ground, with the right to trim or remove, at the discretion of the public utility, trees, overhanging branches, bushes, underbrush and obstructions. No buildings, fences or similar structures, other than such utility facilities, can be located within said areas of land. Any fence located within said areas of land is subject to removal by a public utility without liability in the use of said easements by said utility. Driveways are permitted to cross and lie within said easements. Any Public Utility Company or company installing public utility facilities, other than the Evansville Water and Sewer Utility and its successor or Vectren Energy Delivery and its successor, shall coordinate proposed locations, designs and installation methods with the developer or the Poet Square Homeowner's Association prior to the start of construction.

Stips or areas of land, of the dimensions shown on this plat and marked "D.E." (Drainage Easement) are dedicated for conveyance of surface water and/or subsurface water; provided however, that public utilities are hereby permitted to cross such Drainage Easements with utility facilities provided, that such facilities are not placed in such a manner as to impede the flow of water; the property owner is responsible for maintenance and erosion control of said easements and shall not place landscaping, earth berms, fences or other obstructions that impede or reduce the flow of water. Driveways are permitted to cross and lie within said easements.

**NOTARY CERTIFICATE**

State of INDIANA ss.  
County of VANDERBURGH

Before me, the undersigned, a Notary Public in and for the said County and State, personally appeared the said Owner and Subdivisor Brian N. Murphy (New Urban Investments, LLC) who acknowledged the execution of the foregoing plat with the dedications and restrictions thereon, express to be his voluntary act and deed for the uses and purposes therein set forth.

Witness my hand and seal this 15<sup>th</sup> day of SEPTEMBER, 2014.

9-26-2015  
My Commission expires: SEPTEMBER 26, 2015  
Notary Public: SCOTT D. BUDEL  
County, Indiana: INDIANA

**OWNER & DEVELOPER:** New Urban Investments, LLC  
19501 Haiku Road  
Evansville, IN 47725  
Brian N. Murphy  
Brian N. Murphy, Member  
Sept 15, 2014  
date

**AREA PLAN COMMISSION CERTIFICATE**

Under the authority provided by the Acts of 1981, Public Law #509, and enacted by the General Assembly of the State of Indiana, proper notice was given and this plat has been given Primary Approval by the Area Plan Commission of Evansville and Vanderburgh County at a meeting held on August 11, 2011.

Scott D. Buedel  
President:  
Scott D. Buedel  
Attest Executive Director

The Secondary plat complies with the Ordinance and is released for recording.  
Scott D. Buedel  
Executive Director  
March 17, 2015  
Plat Release Date

**OFFICIAL SEAL**  
COUNTY OF EVANSVILLE AND VANDERBURGH  
STATE OF INDIANA  
LAND SURVEYOR

**BOUNDARY DESCRIPTION**

Part of the West Half of the Northwest Quarter of Section 4, Township 5 North, Range 10 West in Scott Township, Vanderburgh County, Indiana, being more particularly described as follows:

Beginning at the Southwest Corner of the West Half of the Northwest Quarter of said Section 4; thence along the west line of said Quarter Section, North 01 degree 07 minutes 24 seconds East 1611.01 feet; thence South 88 degrees 40 minutes 18 seconds East 362.67 feet to the northwest corner of Poet Square, Section 2, as per plat thereof, recorded in Plat Book T, page 44 in the Office of the Recorder of Vanderburgh County Indiana; thence along the west side of said subdivision the following seven (7) calls:

South 01 degree 08 minutes 35 seconds West 135.96 feet; thence North 88 degrees 51 minutes 25 seconds West 20.54 feet; thence South 01 degree 08 minutes 35 seconds West 50.00 feet; thence South 88 degrees 51 minutes 25 seconds East 15.00 feet; thence South 01 degree 08 minutes 35 seconds West 610.00 feet; thence North 88 degrees 51 minutes 25 seconds West 15.00 feet; thence South 01 degree 08 minutes 35 seconds West 50.00 feet; thence leaving the boundary of said subdivision, North 88 degrees 51 minutes 25 seconds West 30.00 feet; thence South 01 degree 08 minutes 35 seconds West 152.50 feet; thence North 88 degrees 51 minutes 25 seconds West 60.00 feet; thence South 01 degree 08 minutes 35 seconds West 390.00 feet; thence North 88 degrees 51 minutes 25 seconds West 50.00 feet; thence South 01 degree 08 minutes 35 seconds West 50.00 feet to the beginning of a curve to the left having a central angle of 48 degrees 30 minutes 46 seconds, a radius of 75.00 feet and a chord dimension of south 23 degrees 06 minutes 48 seconds East 61.62 feet; thence along the arc of said curve 65.50 feet; thence South 42 degrees 37 minutes 49 seconds West 204.25 feet to a point on the south line of the West Half of the Quarter Section, North 88 degrees 40 minutes 21 seconds West 91.60 feet to the point of beginning and containing 11.105 Acres.

Also, the following offsite easements which are to remain in full force and effect until such a time that the next section of this subdivision or a new subdivision affecting all or a portion of these easements, is approved by Vanderburgh County and recorded in the Vanderburgh County Recorder's office.

**Offsite Easement #1**  
A 7-foot Ingress and Egress Easement, Drainage Easement and Public Utility Easement that lies south of and adjacent to Lot 71. The limits of this easement are defined by the dimensions shown on this plat.

**Offsite Easement #2**  
An 8-foot Public Utility Easement that lies south of and adjacent to the 7-foot Ingress and Egress Easement, Drainage Easement and Public Utility Easement (Offsite Easement #1). The limits of this easement are defined by the dimensions shown on this plat.

**Offsite Easement #3**  
A variable width Public Utility Easement that lies south of and adjacent to the south line of the 8-foot public utility easement to the south of Lot 71 (Offsite Easement #2) and east of and adjacent to the right-of-way of Reading Drive. The limits of this easement are defined by the dimensions shown on this plat.

**Offsite Easement #4**  
A 10-foot Public Utility Easement that lies east of and adjacent to the east line of Lot 71, south of and adjacent to the south right-of-way line of Edgar Allan Road and west of and adjacent to an Offsite 10-foot easement as shown on the plat of Poet Square, Section 2, recorded in Plat Book T, page 44 in the Office of the Recorder of Vanderburgh County, Indiana. The limits of this easement are defined by the dimensions shown on this plat.

Subject to all easements, rights-of-ways, reservations and restrictions of record.

Witness my hand and seal this 10th day of September, 2014.

Scott D. Buedel  
Scott D. Buedel, PLS  
Indiana Registration Number 29900031  
Cash Waggoner & Associates, PC  
414 Citadel Circle, Suite B  
Evansville, IN 47715