


**Morley and Associates, Inc.**  
 Consulting Engineers/Surveyors/Architects  
 605 S.E. Martin Luther King Jr. Blvd.  
 Evansville, Indiana 47713  
 (812) 464-9586

No.	Date	Description
1	4/14/97	Revise roads and sewers.

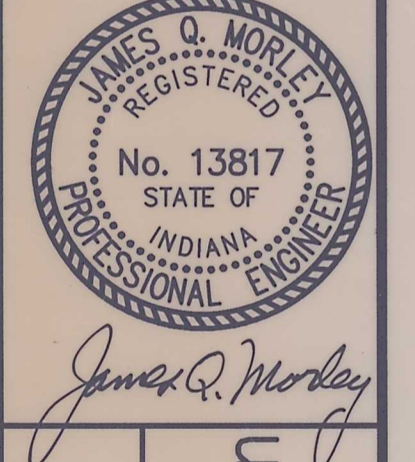

Project: Clear Creek Village - Section 1  
 Sheet Title: Drainage and Utility Plan  
 Scale: 1" = 50'  
 Designed By: JEM Job Number: 3309-1  
 Drawn By: GAH Date: 10/08/96  
 Checked By: BASE1.DWG  
 Sheet Number: 3A of 16

SEE SHEET 3B