


**Morley and Associates, Inc.**  
 Consulting Engineers/Surveyors/Architects  
 805 S.E. Martin Luther King Jr. Blvd.  
 Evansville, Indiana 47713  
 (812) 464-9585

All ideas, designs, conditions, and measurements indicated on this drawing are the property of Morley and Associates, Inc. and were created for the use on and in connection with the specified project. None of such ideas, designs, conditions, or measurements shall be used, copied, or reproduced in any form, or for any purpose whatsoever without the written permission of Morley and Associates, Inc. While drawings on these designs shall show procedures over all dimensions and conditions on the job and Morley and Associates, Inc. must be notified of any variation from the dimensions and conditions shown by these drawings.

No.	By	Date	Description
1	J.E.M.	4/14/03	Issue road grades and sewer elevations.
2	J.E.M.	5/21/03	Sanitary Sewer As Built Phase 1
3	J.E.M.	5/21/03	STORM SEWER AS BUILT'S

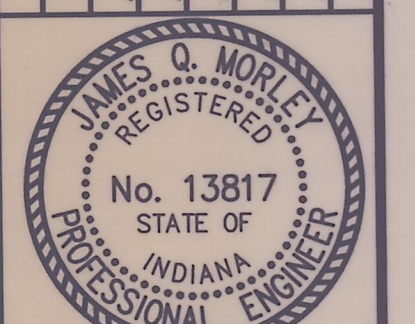

*James Q. Morley*

Project: Clear Creek Village - Section 1  
 Sheet Title: Clear Creek Drive Plan and Profile  
 Hor. Scale: 1"=50'  
 Ver. Scale: 1"=5'  
 Designed By: J.E.M. Job Number: 96-3309-1(A)(A2)  
 Drawn By: G.A.H. Date: 09-27-96  
 Checked By: File Name: RCP01001.DWG  
 Sheet Number: 5 of 16