
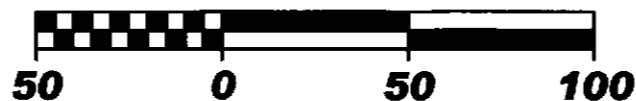


# Basin 2 Section B2 Alignment Profile

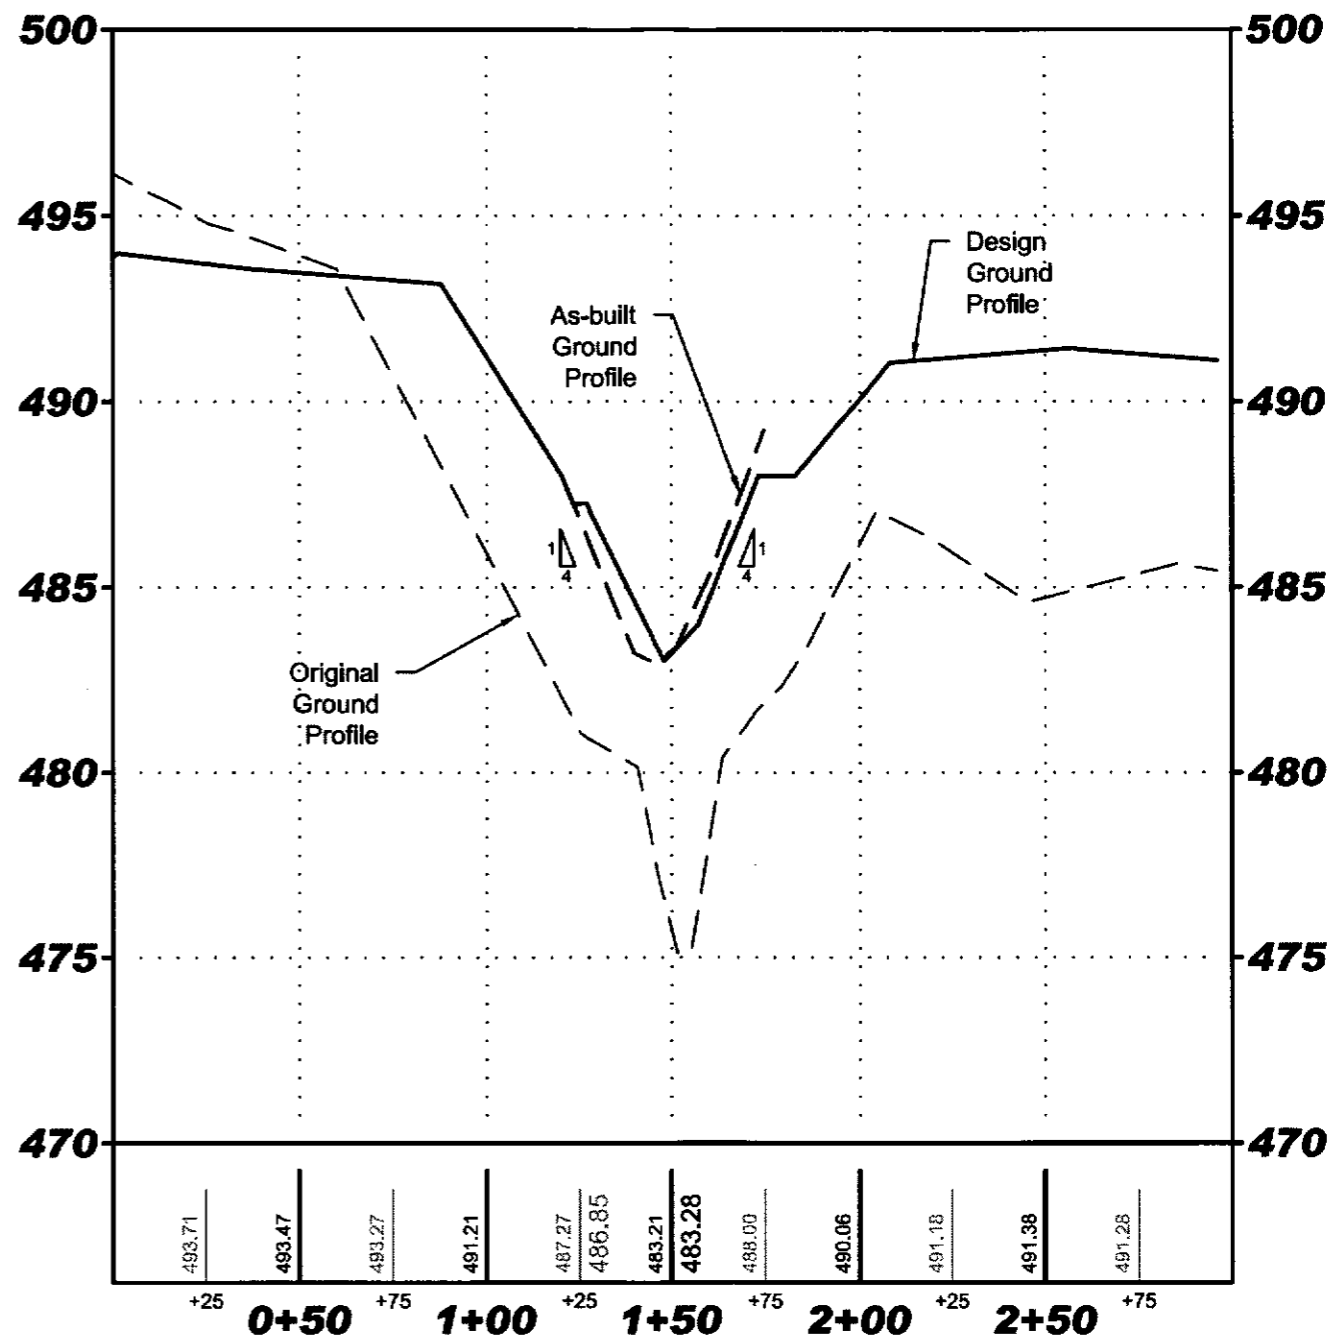

**APPROVED**

OCT 28 2014

VANDERBURGH COUNTY  
DRAINAGE BOARD

RECEIVED BY THE  
VANDERBURGH COUNTY  
SURVEYOR'S OFFICE

10/13/2014 JEM

Profile Scales:  
Horiz. 1" = 50'  
Vert. 1" = 5'

**Morley and Associates Inc.**  
Engineering  
Surveying  
Architecture  
Construction Management


Evansville, In (812) 464-9585  
Henderson, Ky (270) 830-0300  
Jasper, In (812) 634-9990

www.morleyandassociates.com

Record Drawing  
Basin 2 Additional  
Cross Sections

Designed By: JEM	Job Number: 8699.4.001 A
Drawn By: BSH	Date: 10-13-14
Filename: 8699\Civil\Civil 3D\8699 Base.dwg	

# Basn 2 Section B3 Alignment Profile

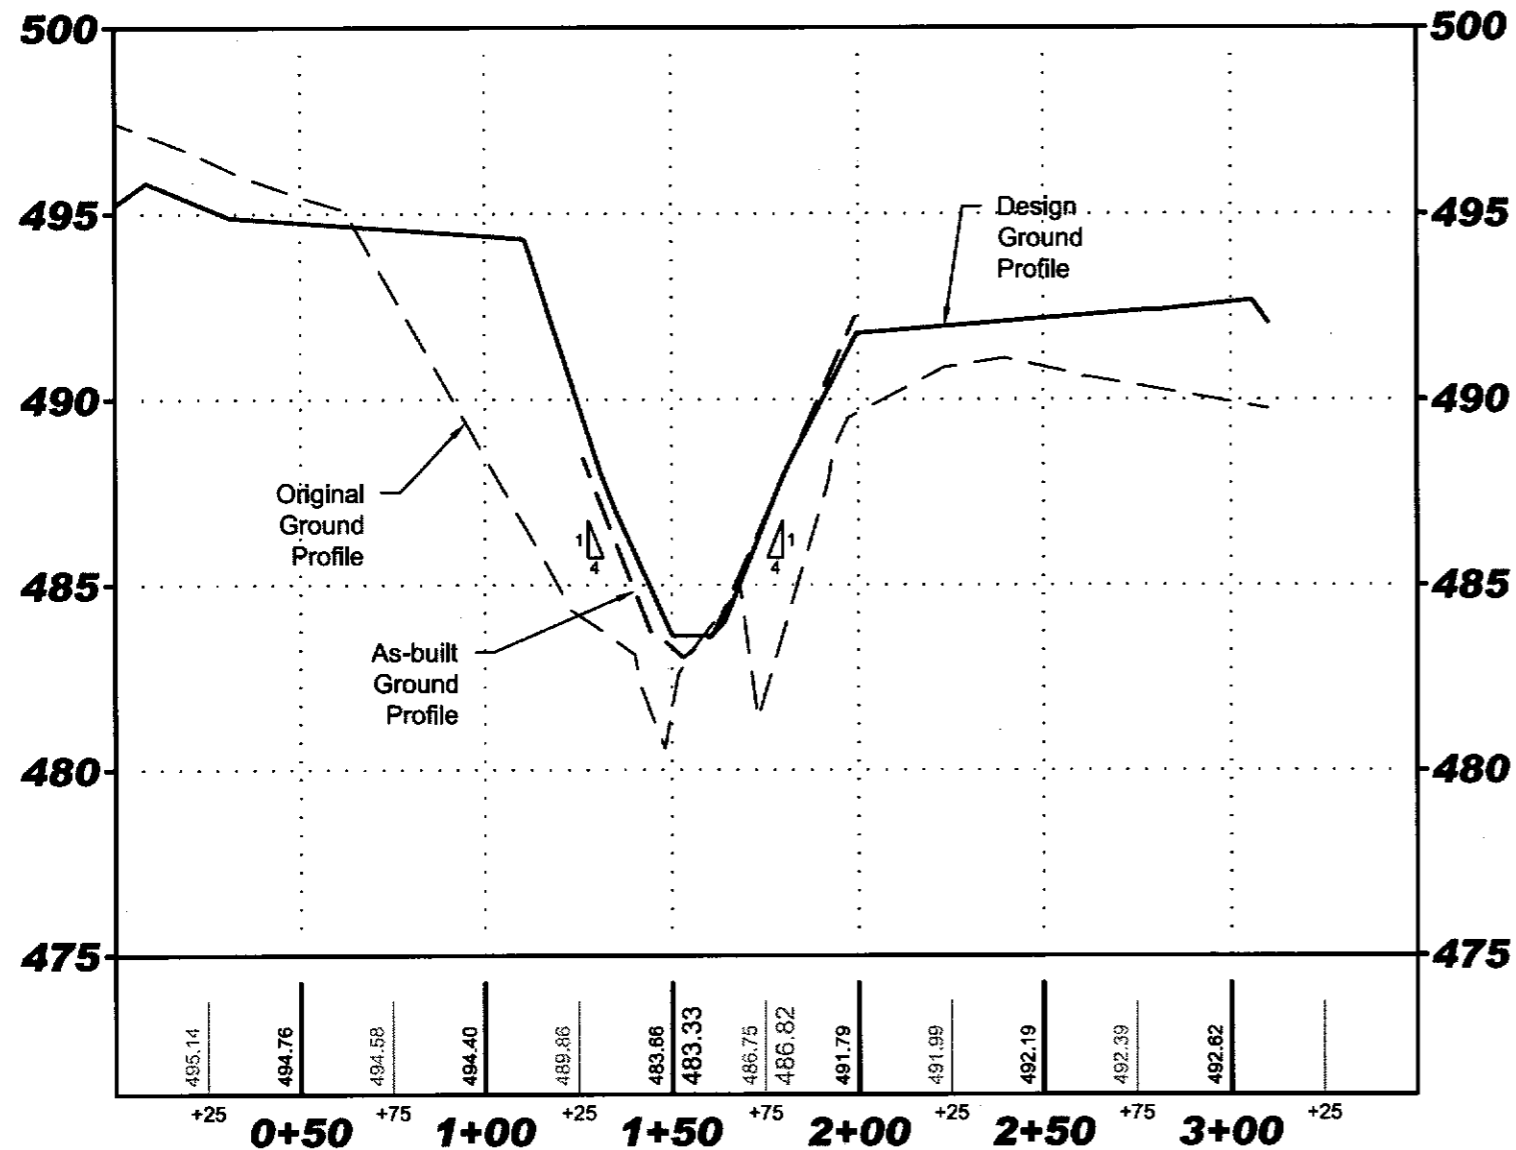

Profile Scales:  
 Horiz. 1" = 50'  
 Vert. 1" = 5'



*James E. Morley*  
 10-13-14

**APPROVED**  
 OCT 28 2014  
 VANDERBURGH COUNTY  
 DRAINAGE BOARD

RECEIVED BY THE  
 VANDERBURGH COUNTY  
 SURVEYOR'S OFFICE  
 EMM 10/13/2014

**Morley and Associates Inc.**  
 Engineering  
 Surveying  
 Architecture  
 Construction Management

Evansville, In (812) 464-9585  
 Henderson, Ky (270) 830-0300  
 Jasper, In (812) 634-9990

www.morleyandassociates.com

Record Drawing  
 Basin 2 Additional  
 Cross Sections

Designed By: JEM	Job Number: 8699.4.001 A
Drawn By: BSH	Date: 10-13-14
Filename: 8699\Civil\Civil 3D\8699 Base.dwg	