
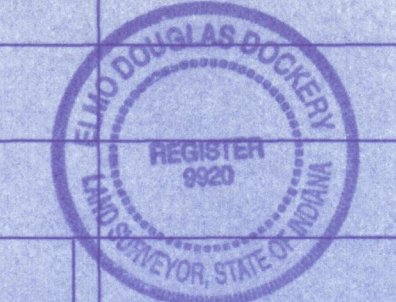


CURVE	DELTA ANGLE	RIGHT-OF-WAY RADIUS	CURVE DATD ARC	TANGENT	CHORD	CHORD BEARING
C 1	44° 58' 20"	218.27'	171.32'	90.35'	166.96'	N 31° 41' 08" W
C 2	25° 13' 02"	645.58'	284.14'	144.41'	281.85'	N 21° 48' 29" W
C 3	09° 14' 15"	1831.72'	295.32'	147.98'	295.00'	N 39° 02' 08" W
C 4	48° 11' 19"	25.00'	21.03'	11.18'	20.41'	N 67° 45' 06" W
C 5	276° 22' 40"	50.00'	241.19'			
C 6	48° 11' 19"	25.00'	21.03'	11.18'	20.41'	S 19° 33' 24" E
C 7	09° 14' 15"	1881.72'	303.38'	152.02'	303.05'	S 39° 02' 08" E
C 8	25° 13' 02"	695.58'	306.14'	155.59'	303.68'	S 21° 48' 29" E
C 9	44° 58' 20"	168.27'	132.08'	69.65'	128.71'	S 31° 41' 08" E

CURVE	DELTA ANGLE	RADIUS	ARC	TANGENT	CHORD	CHORD BEARING
C 1	44° 58' 20"	193.27'	151.70'	80.00'	147.84'	N 31° 41' 08" W
C 2	25° 13' 02"	670.58'	295.14'	150.00'	292.77'	N 21° 48' 29" W
C 3	09° 14' 15"	1856.72'	299.35'	150.00'	299.03'	N 39° 02' 08" W

LINE	BEARING	DISTANCE
L 1	N 43° 39' 15" W	80.65'
L 2	S 43° 39' 15" E	80.65'

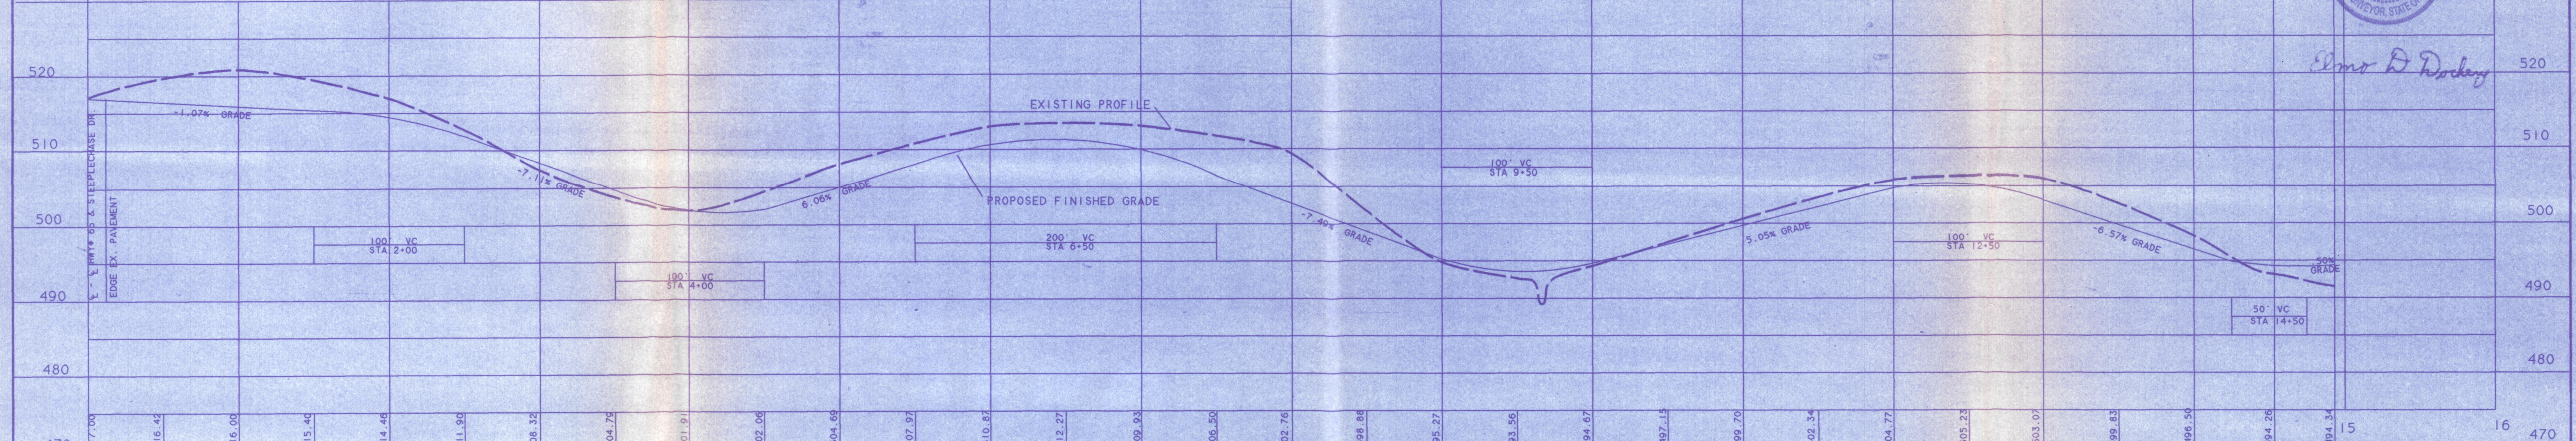

Elmo D. Dickey

UTILITIES CONSULTING INC.
P.O. BOX 99
NEWBURGH, IN. 47629

STREET PLAN STEEPLCHASE DRIVE
AS BUILT

HAHNI

DATE 9-28-98 SCALE 1"=50'
JOB# 97-3-2 SHEET 2 OF 3