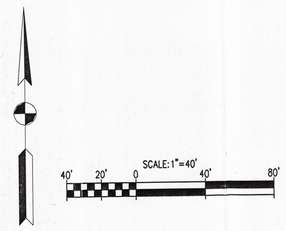

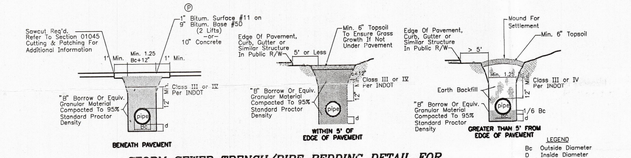

STORM SEWER TRENCH/PIPE BEDDING DETAIL FOR REINFORCED CONCRETE PIPE (RCP)

NOT TO SCALE

All Bedding & Initial Shall Be Installed In 8" To 12" Balanced Lifts
A Minimum 9" Of Clearance Shall Be Provided On Each Side Of Installed Pipe

LEGEND
Bc Outside Diameter
D Inside Diameter
d Depth of Bedding Material Below Pipe

Depth of Bedding Material Below Pipe	
D	d=
27" & Smaller	3"
30" to 60"	4"
66" & Larger	6"

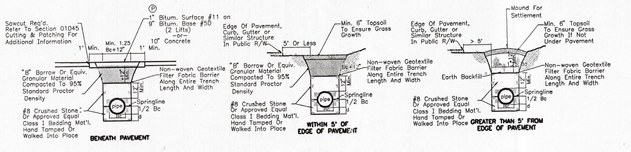

STORM SEWER TRENCH/PIPE BEDDING DETAIL FOR PLASTIC PIPE (PVC & HDPE)

NOT TO SCALE

* or per Manufacturer's Specifications

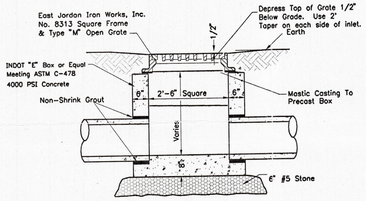

INLET TYPE E-5 DETAIL

Not To Scale

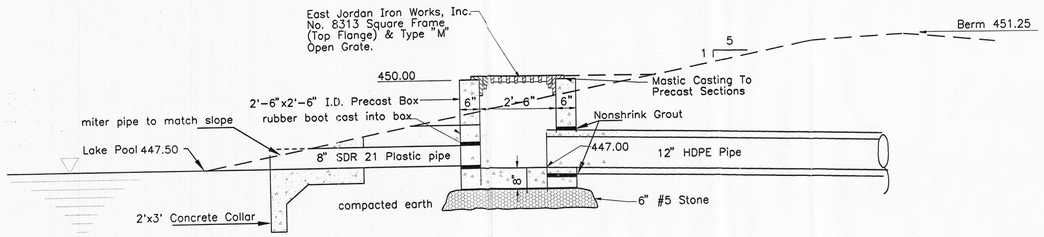

PRECAST OUTLET CONTROL STRUCTURE No. 103

Not To Scale

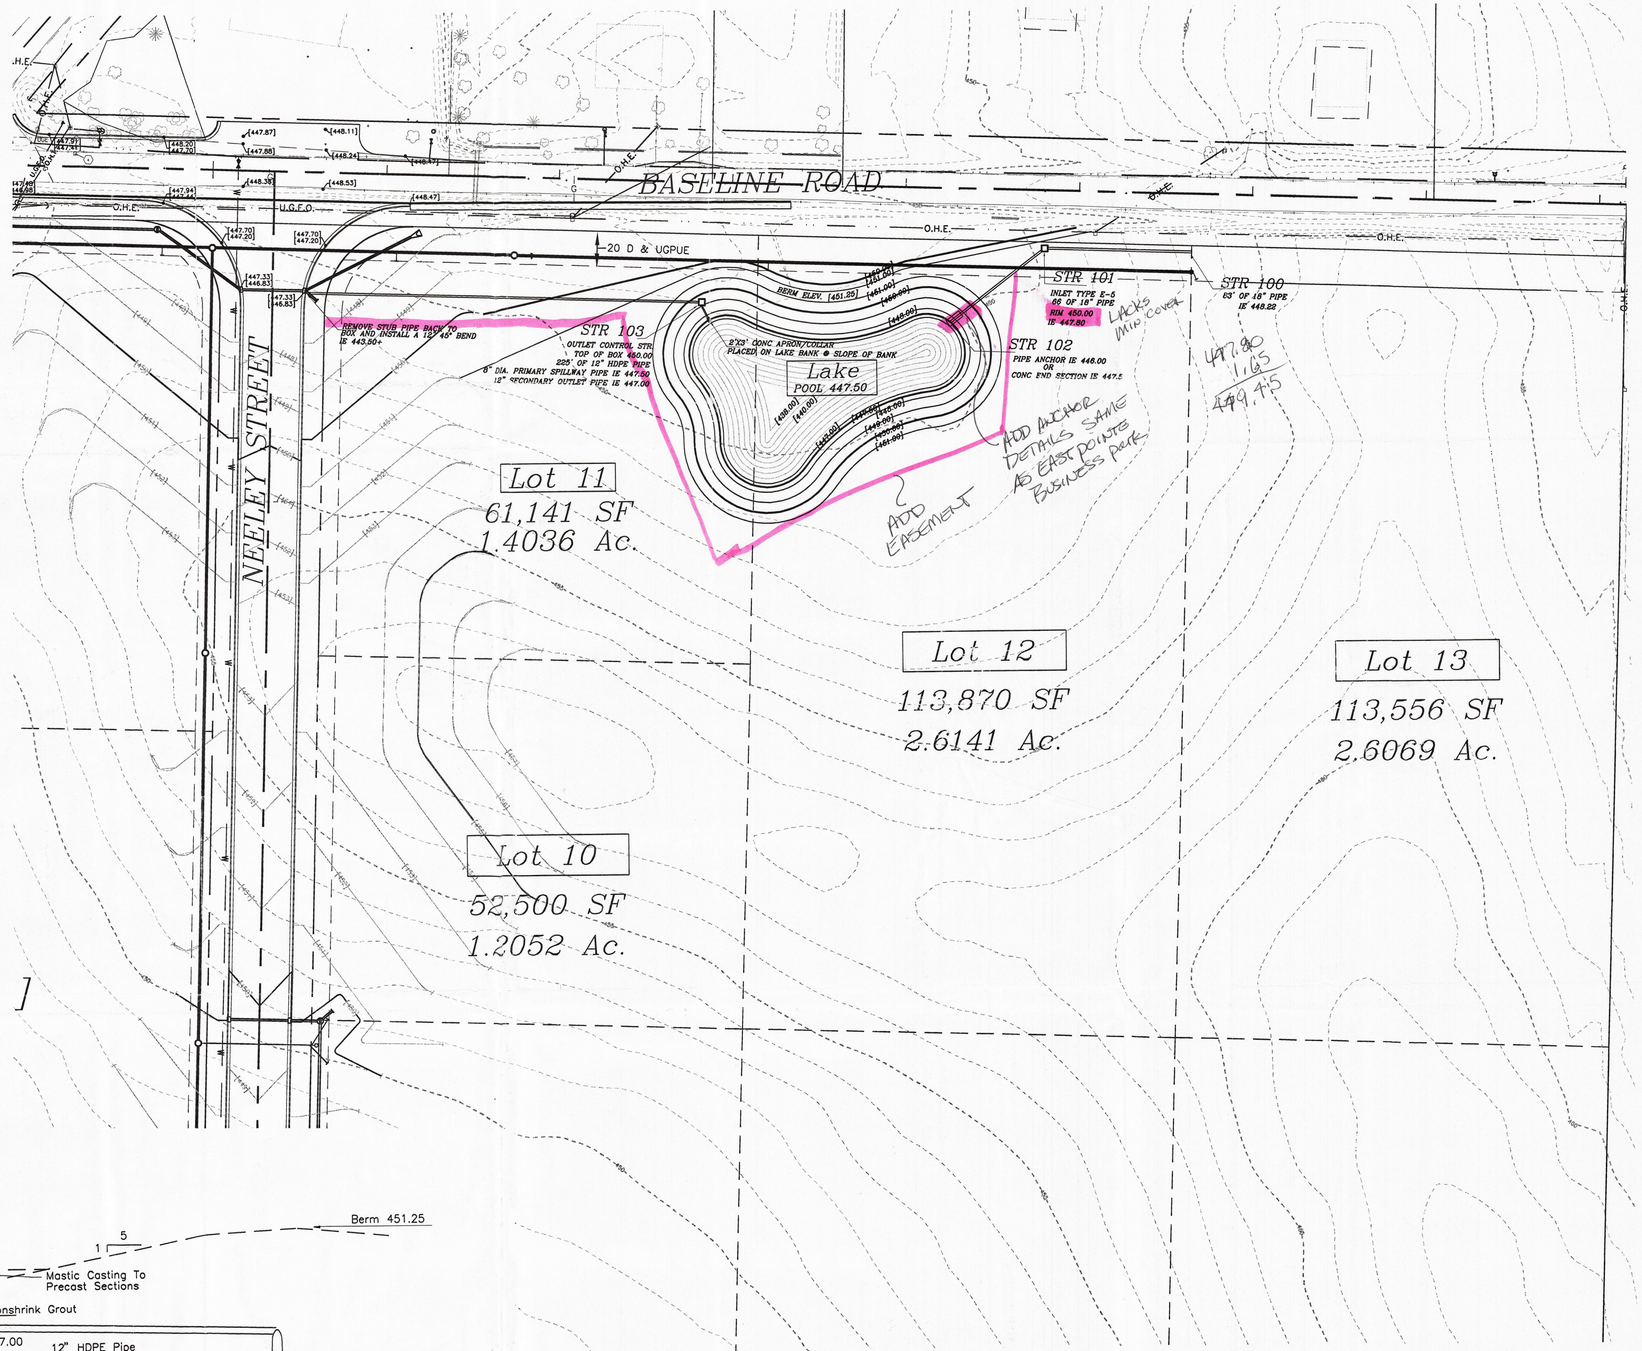

This drawing is the property of Bernardin Lochmueller & Associates. All layouts and designs were created for use on a specific project. No part of this design or drawing shall be disclosed to any person or organization without the express written permission of Bernardin Lochmueller & Associates. Contractors shall verify and be responsible for all dimensions and conditions on the site. Contractor shall notify Bernardin, Lochmueller & Associates of any variations from the design shown hereon.

Num.	Description	Date
1		

JAMES A. FARNY REGISTERED No. 20434 STATE OF INDIANA PROFESSIONAL ENGINEER

DRAINAGE PLAN

LOTS 11,12 &13

FOR

BASELINE PARK SUBDIVISION

VANDERBURGH COUNTY, INDIANA

Prepared By
BERNARDIN LOCHMUELLER & ASSOC., INC.
Planners · Engineers · Surveyors
(200 Vogel Road
Evansville, IN 47715 (812)479-6200

DATE:

PROJECT NO.:

ISSUED:

SHT. 1