


*Drainage OK
Bill Jeffrey
8/18/97*

*Dennis Higgs
453-1993*

PLANS BY
NEW TECH CONSTRUCTION INC.
4311 SUMMERCREEK LANE
NEWBURGH IN 47629

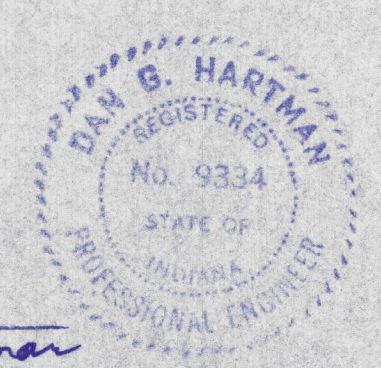

Dan G. Hartman

TRUCK PRO			
SCALE 1" = 20.0'	REVISIONS	BY	DATE
DATE 6-20-77			
DR. P.C.	CND.		
APP'D.			
TITLE	NO. S-1		

PLOT PLAN

ZONING M-2