


**RECORD
DRAWING**

SANITARY SEC. I 9-15-99
STORM SEC. I-12-2-99

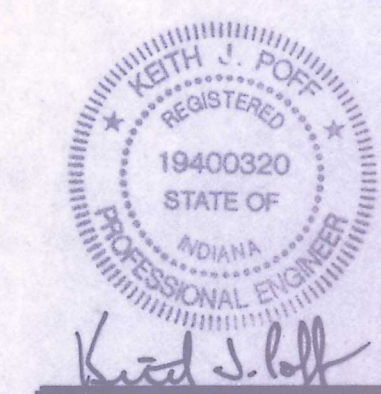

- △ UPDATE SAN. SEWER 8-5-99
- △ UPDATE SANITARY SEWER, BOX CULVERT & EASEMENTS 7-29-99
- △ REVISED C.I.#514 6-28-99
- △ UPDATE STORM SEWER 6-8-99

Scale: 1"=50'

Designed By: KJP Job Number: 109-97-7

Drawn By: RRB Date: 8-3-99

Checked By: RRB Filename: PROFILE3.DWG

Sheet Number: **RP-3**