


**RECORD
DRAWING**

SANITARY SEC. I 9-15-99
STORM SEC. I- 12-2-99

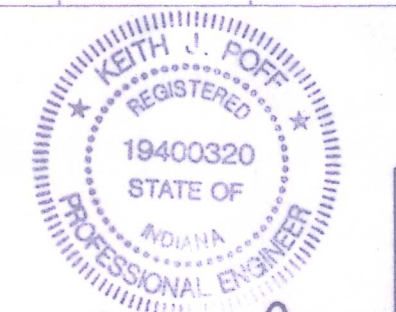

Keith J. Poff

- UPDATE SANITARY SEWER, BOX CULVERT & EASEMENTS 7-29-99
- UPDATE ROAD ELEV. 6-28-99
- UPDATE STORM SEWER. 6-9-99

Scale: 1"=50'	
Designed By: KJP	Job Number: 109-97-7
Drawn By: RRB	Date: 8-3-99
Checked By:	Filename: PROFILE.DWG
Sheet Number: SP-A&E	

△ UPDATE SAN. SEWER 8-5-99