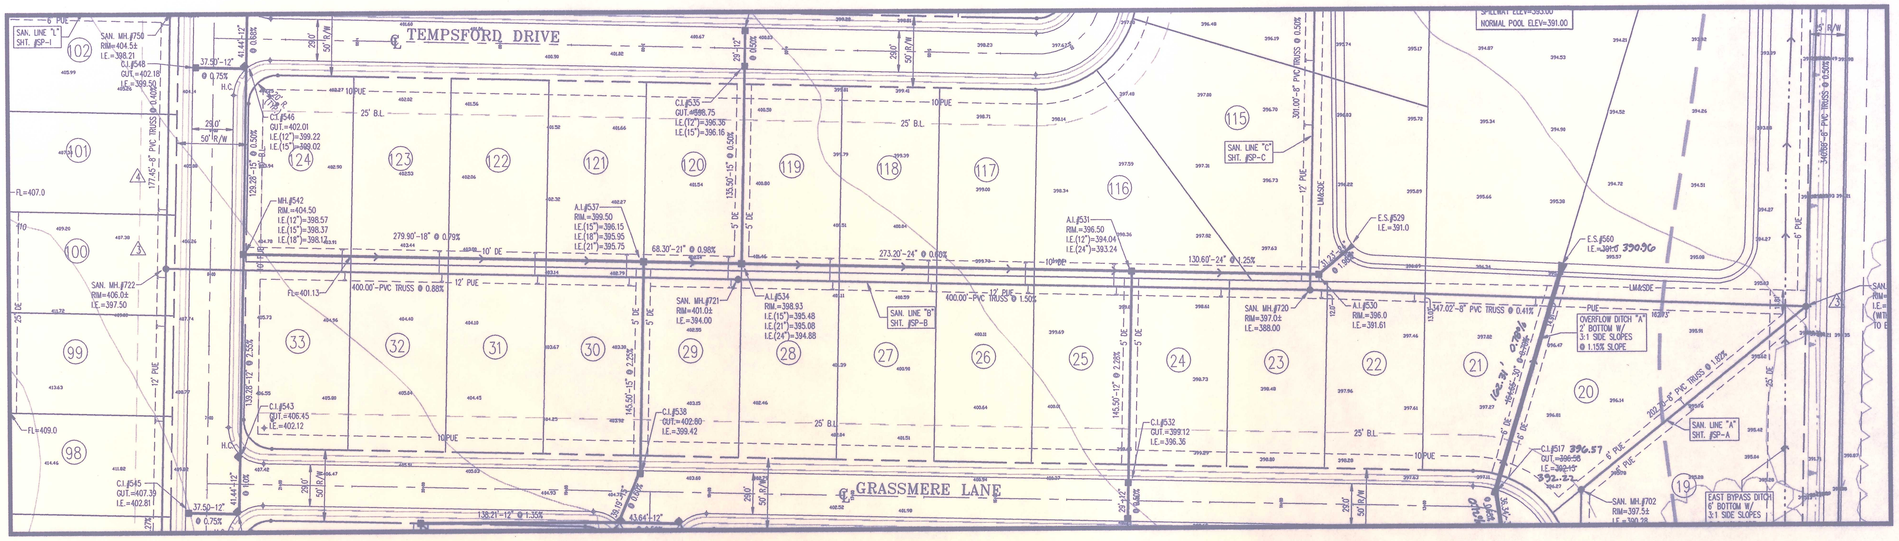

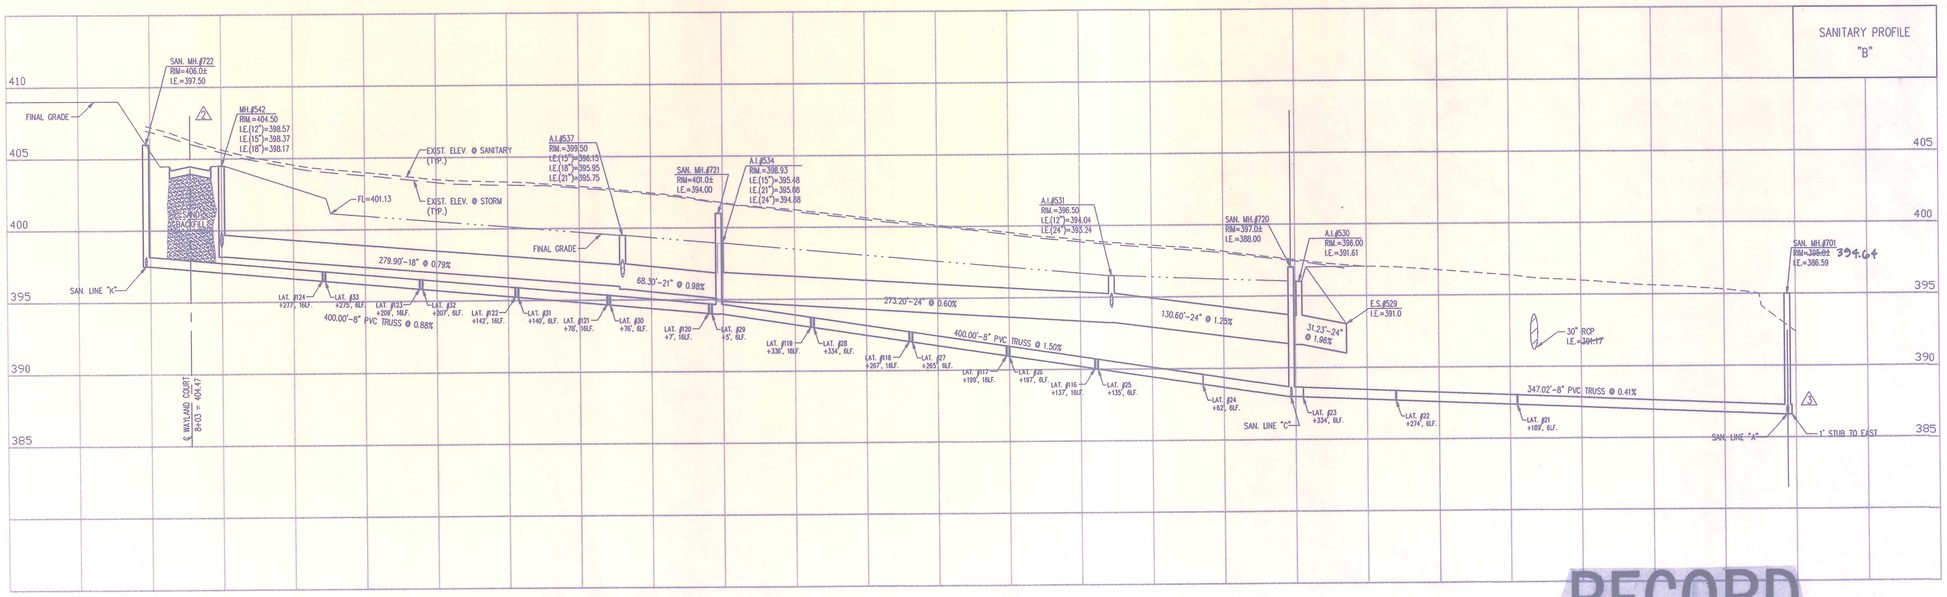

RECORD DRAWING
STORM SEC.I-12-2-99

KEITH J. POFF REGISTERED 19400320 STATE OF INDIANA PROFESSIONAL ENGINEER

Keith J Poff

Scale: 1"=50	
Designed By: KJP	Job Number: 109-97-7
Drawn By: RRB	Date: 6-3-99
Checked By:	Filename: PROFILEB.DWG
Sheet Number: SP-B	

⚠ UPDATE SANITARY SEWER 8-5-99
⚠ UPDATE SANITARY SEWER, BOX CULVERT & EASEMENTS 7-29-99
⚠ UPDATE ROAD ELEV. 6-28-99
⚠ UPDATE STORM SEWER 6-9-99