



P:\Jobs\96403\dwg\PP\CENTRAL\PP14C 9-17-97 8:29:50 am EST

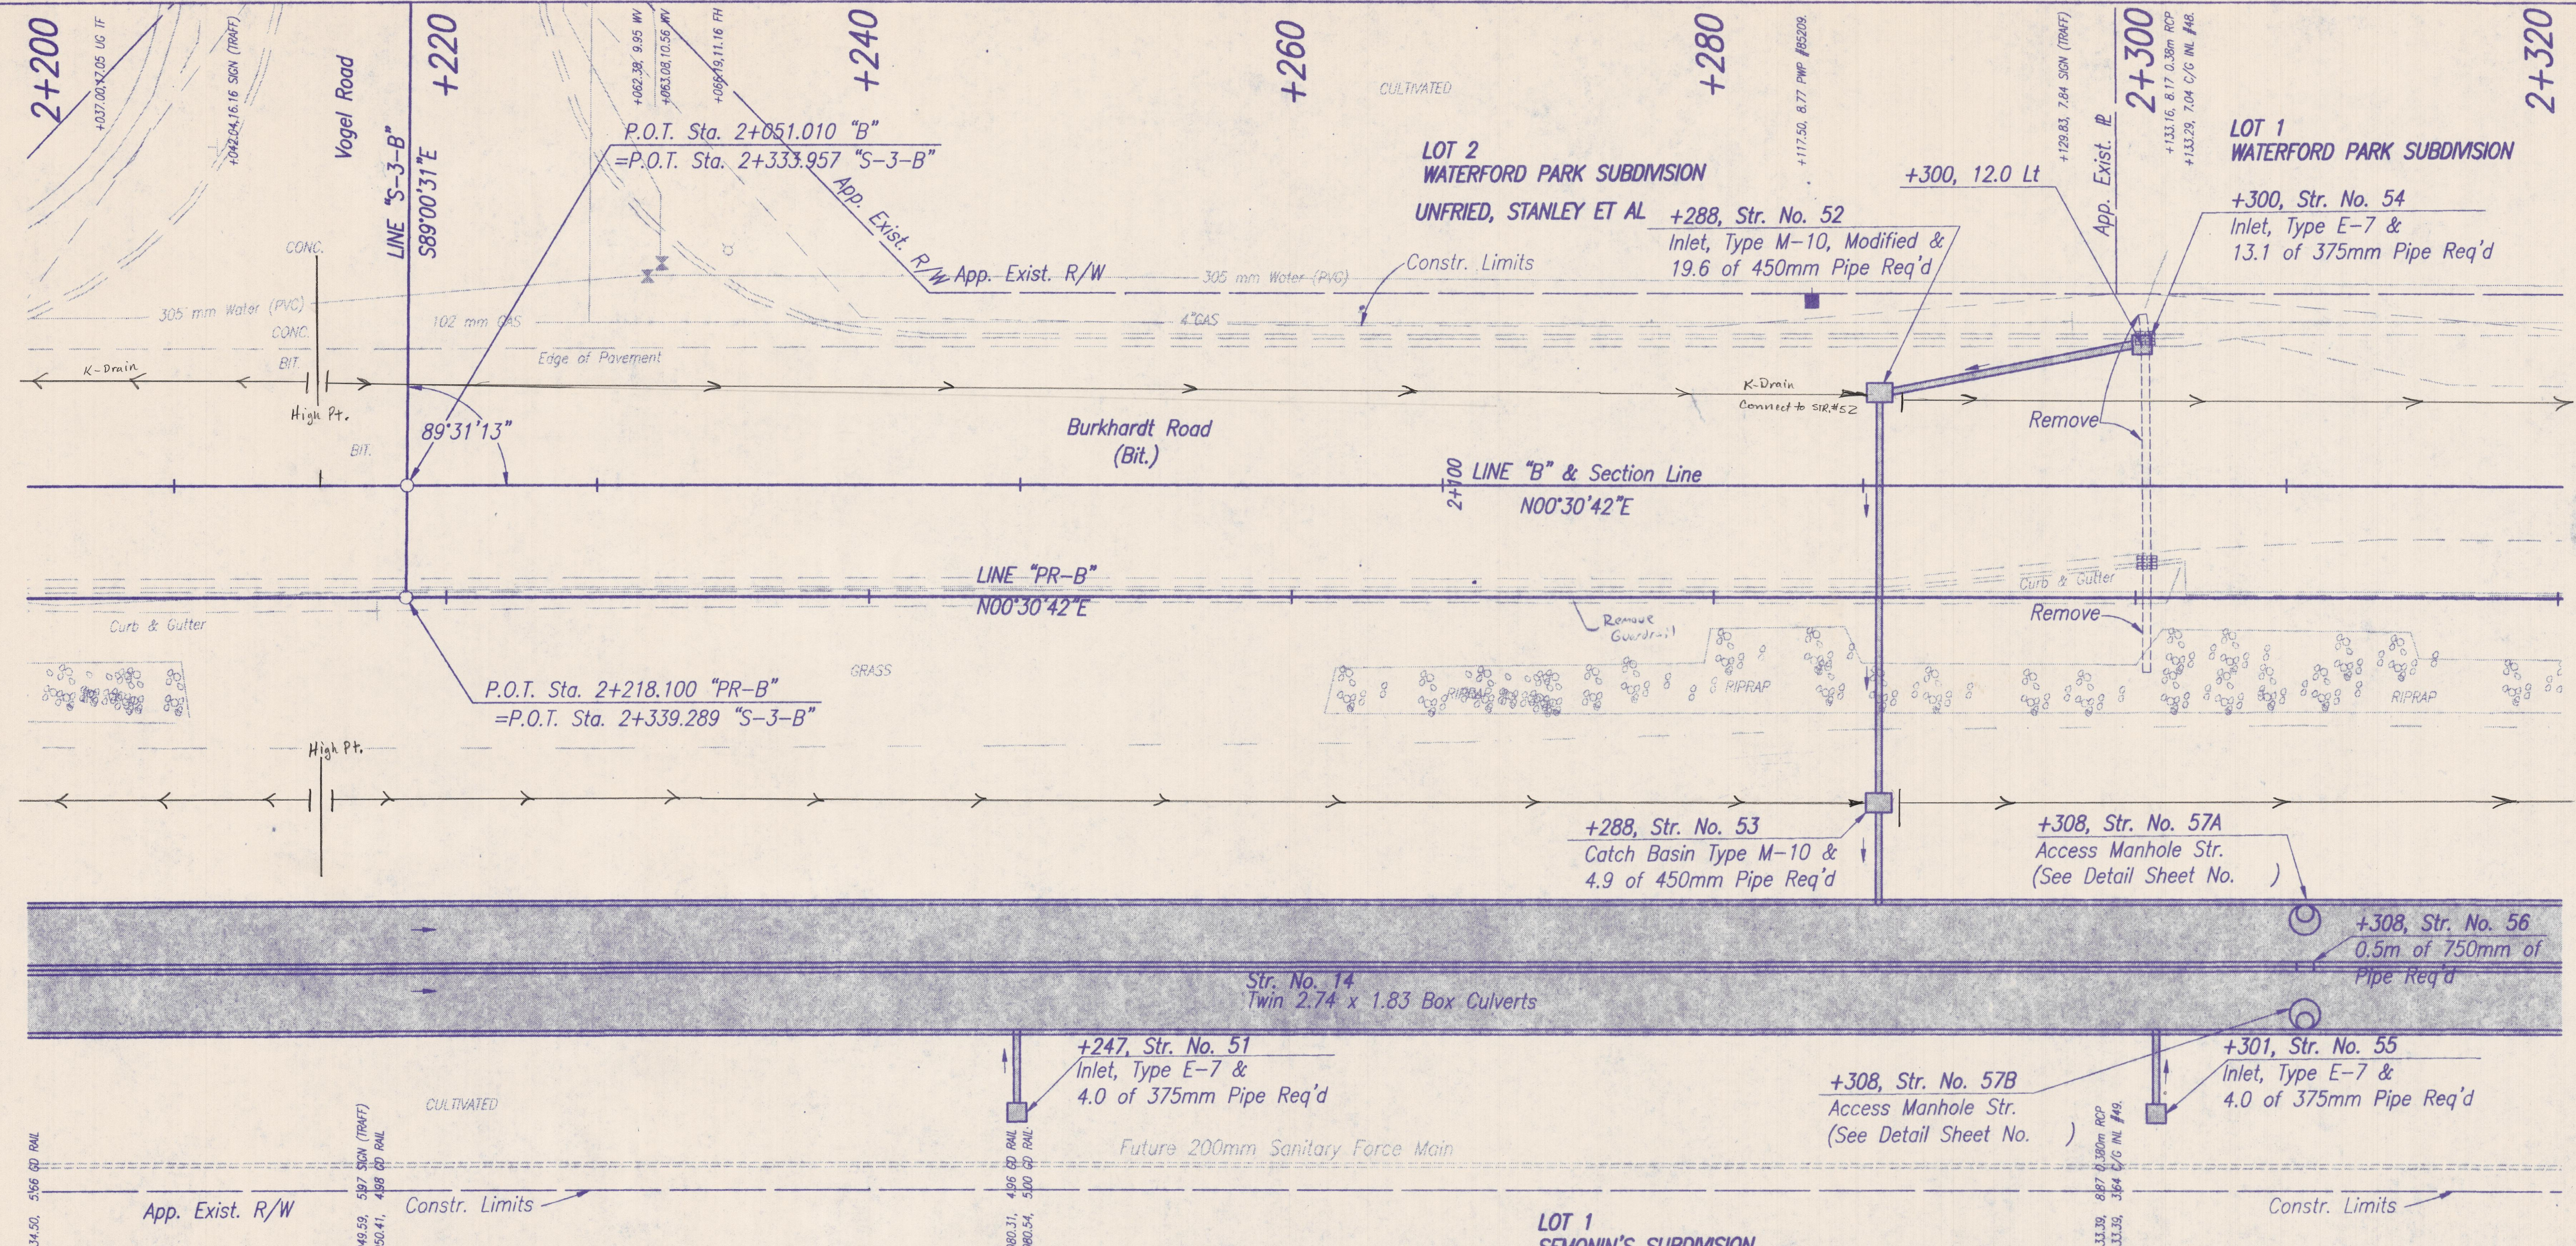

All topo taken from Line "B" unless otherwise noted.  
 All R/W taken from Line "PR-B" unless otherwise noted.  
 All R/W on this sheet to be as shown.

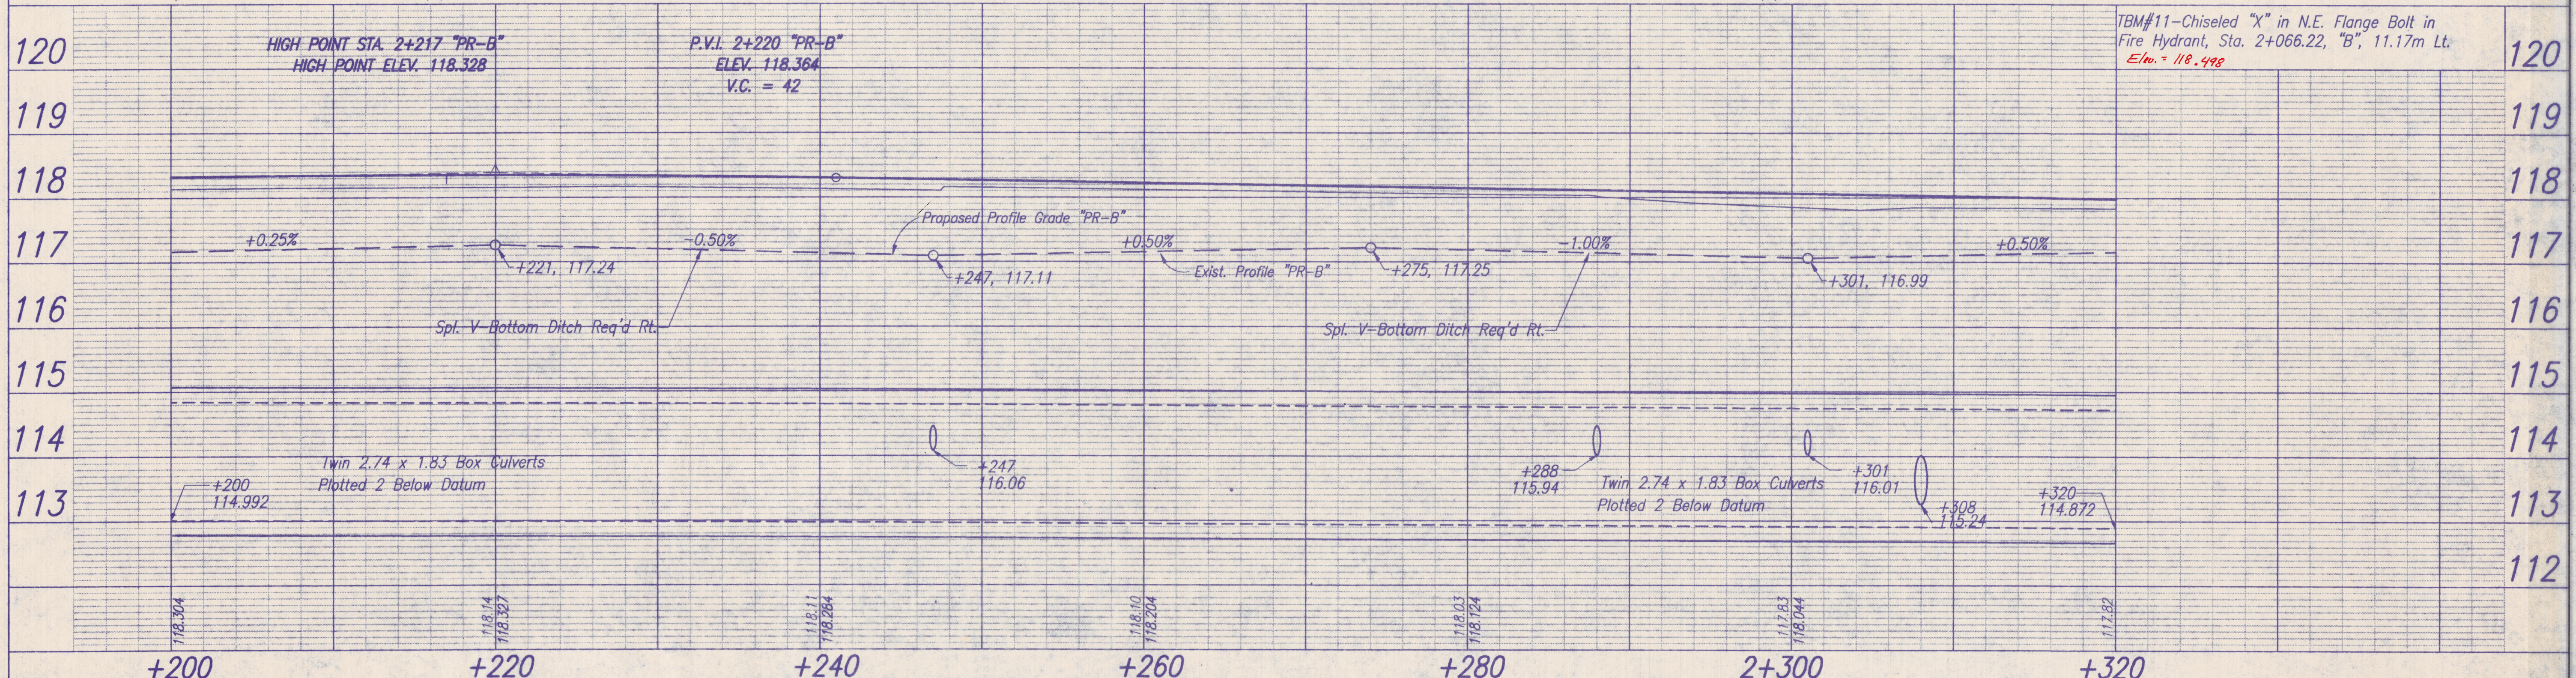

TBM#11-Chiseled "X" in N.E. Flange Bolt in Fire Hydrant, Sta. 2+066.22, "B", 11.17m Lt.  
 Elev. = 118.498

			RECOMMENDED FOR APPROVAL <i>Kent D. Downey</i> 9/19/97 DESIGN ENGINEER DATE	<b>INDIANA DEPARTMENT OF TRANSPORTATION</b>	HORIZONTAL SCALE 1:200 VERTICAL SCALE 1:50	BRIDGE FILE DESIGNATION
			DESIGNED: ATW, DAV CHECKED: GLR	DRAWN: ATW, DAV, JRF CHECKED: GLR	<b>PLAN &amp; PROFILE          BURKHARDT ROAD</b>	SURVEY BOOK CONTRACT