



P:\jobs\96403\dwg\PP\CENTRAL\PP15C 9-17-97 8:33:27 am EST

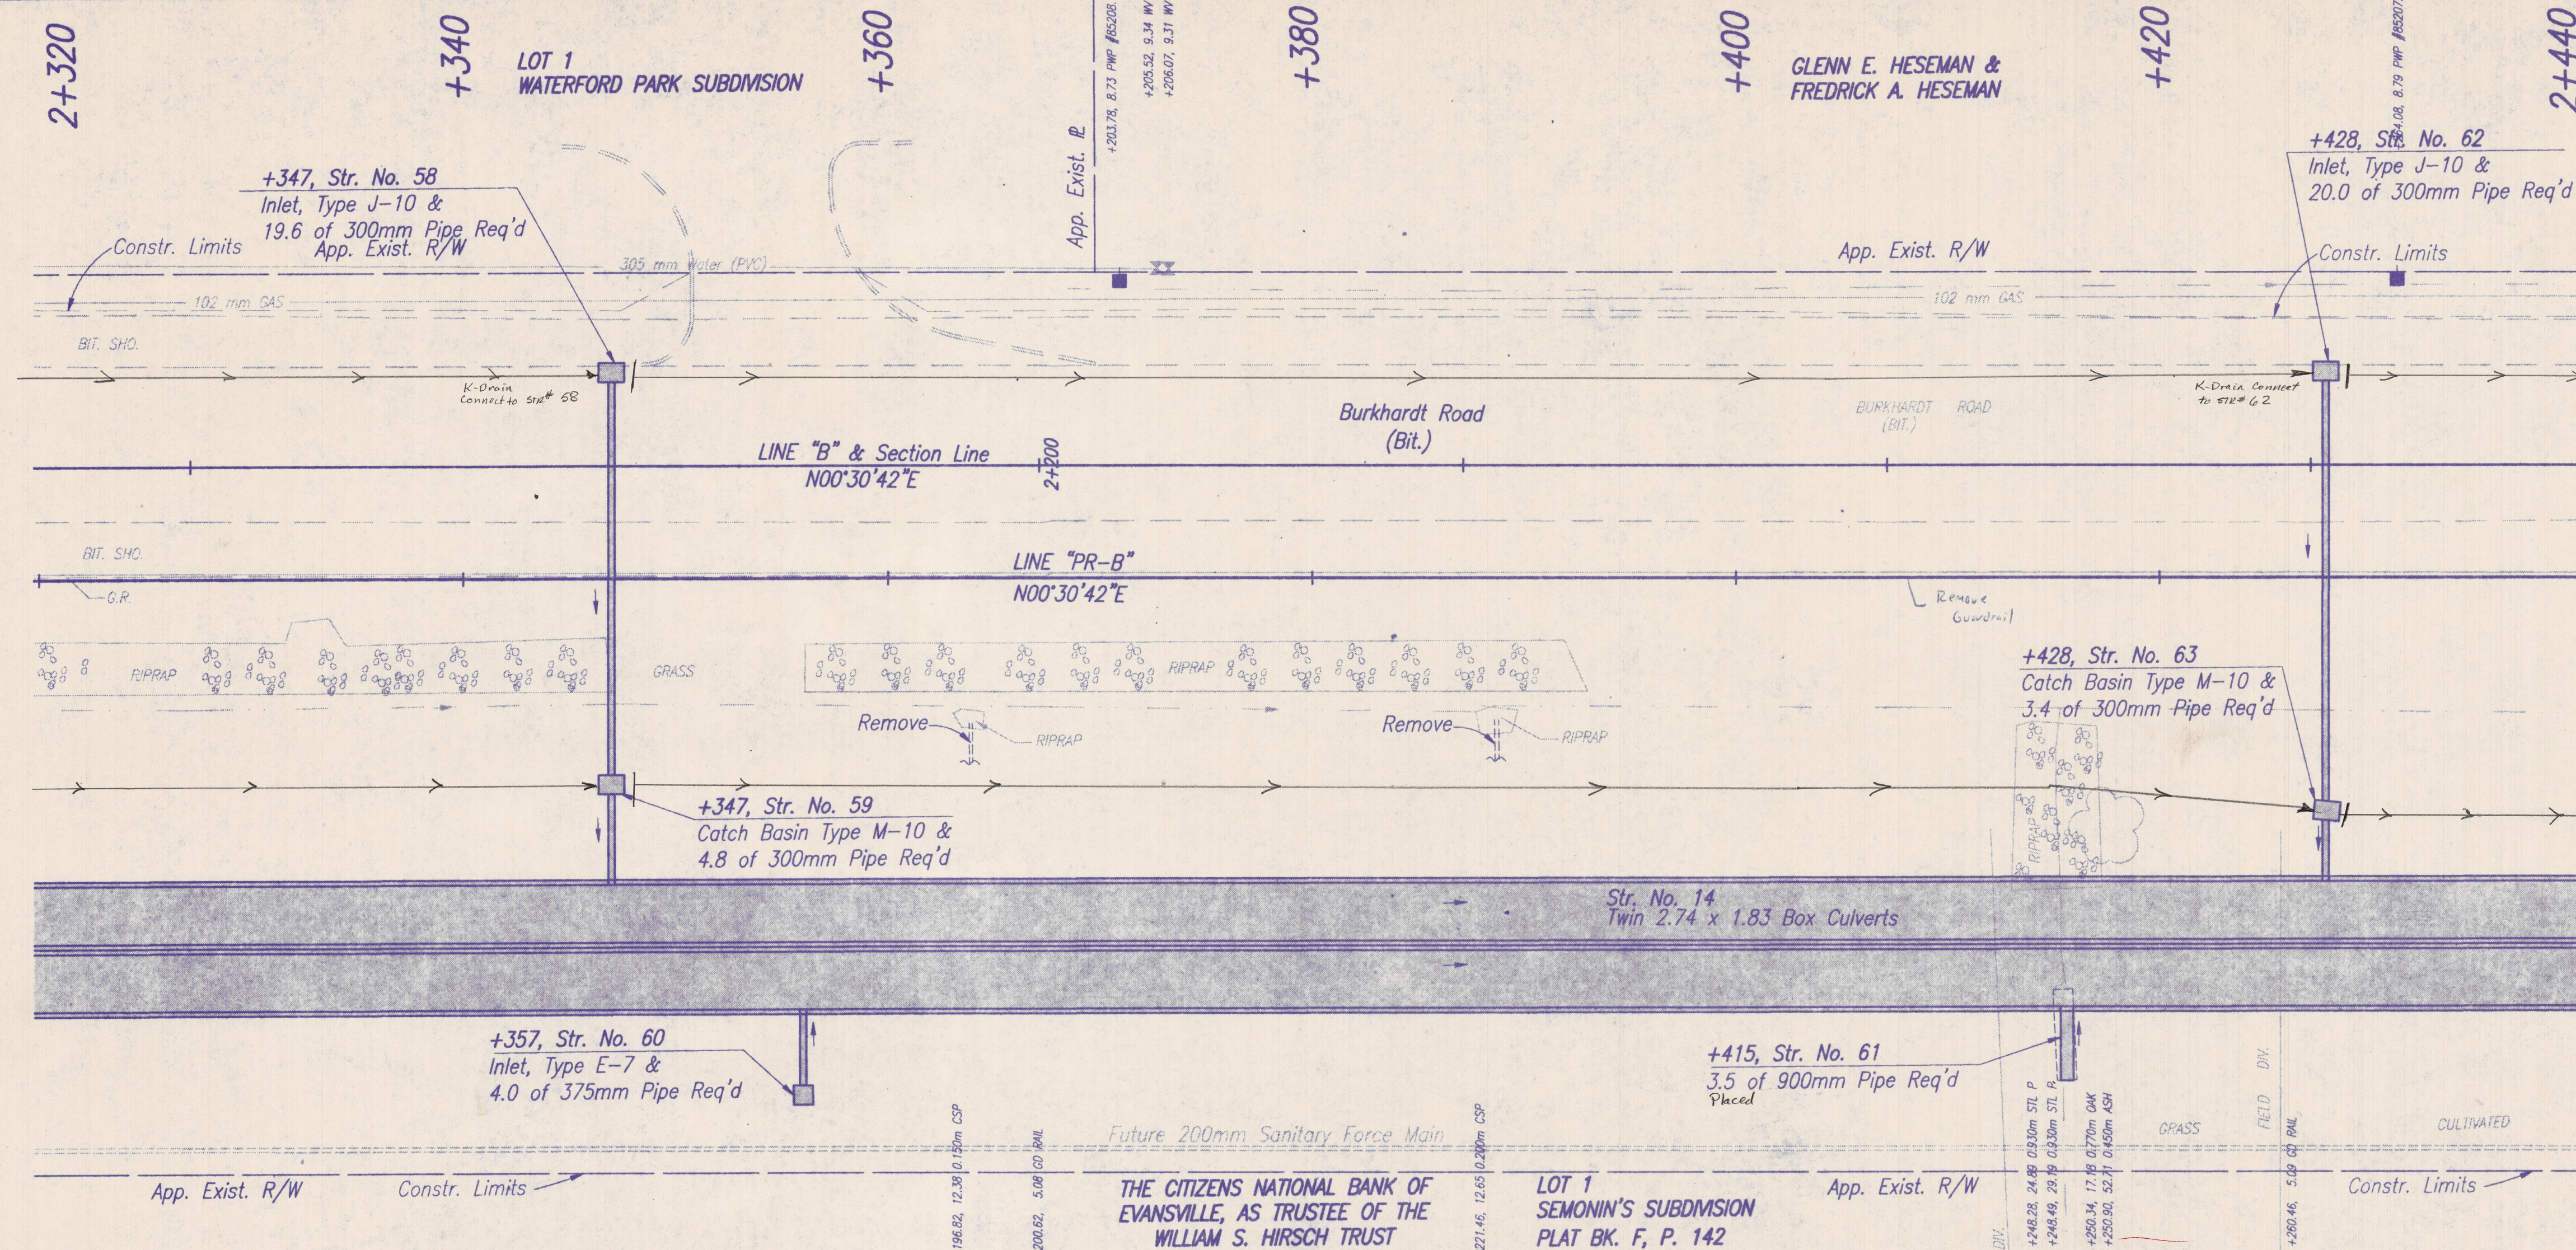

All topo taken from Line "B" unless otherwise noted.
All R/W taken from Line "PR-B" unless otherwise noted.
All R/W on this sheet to be as shown.

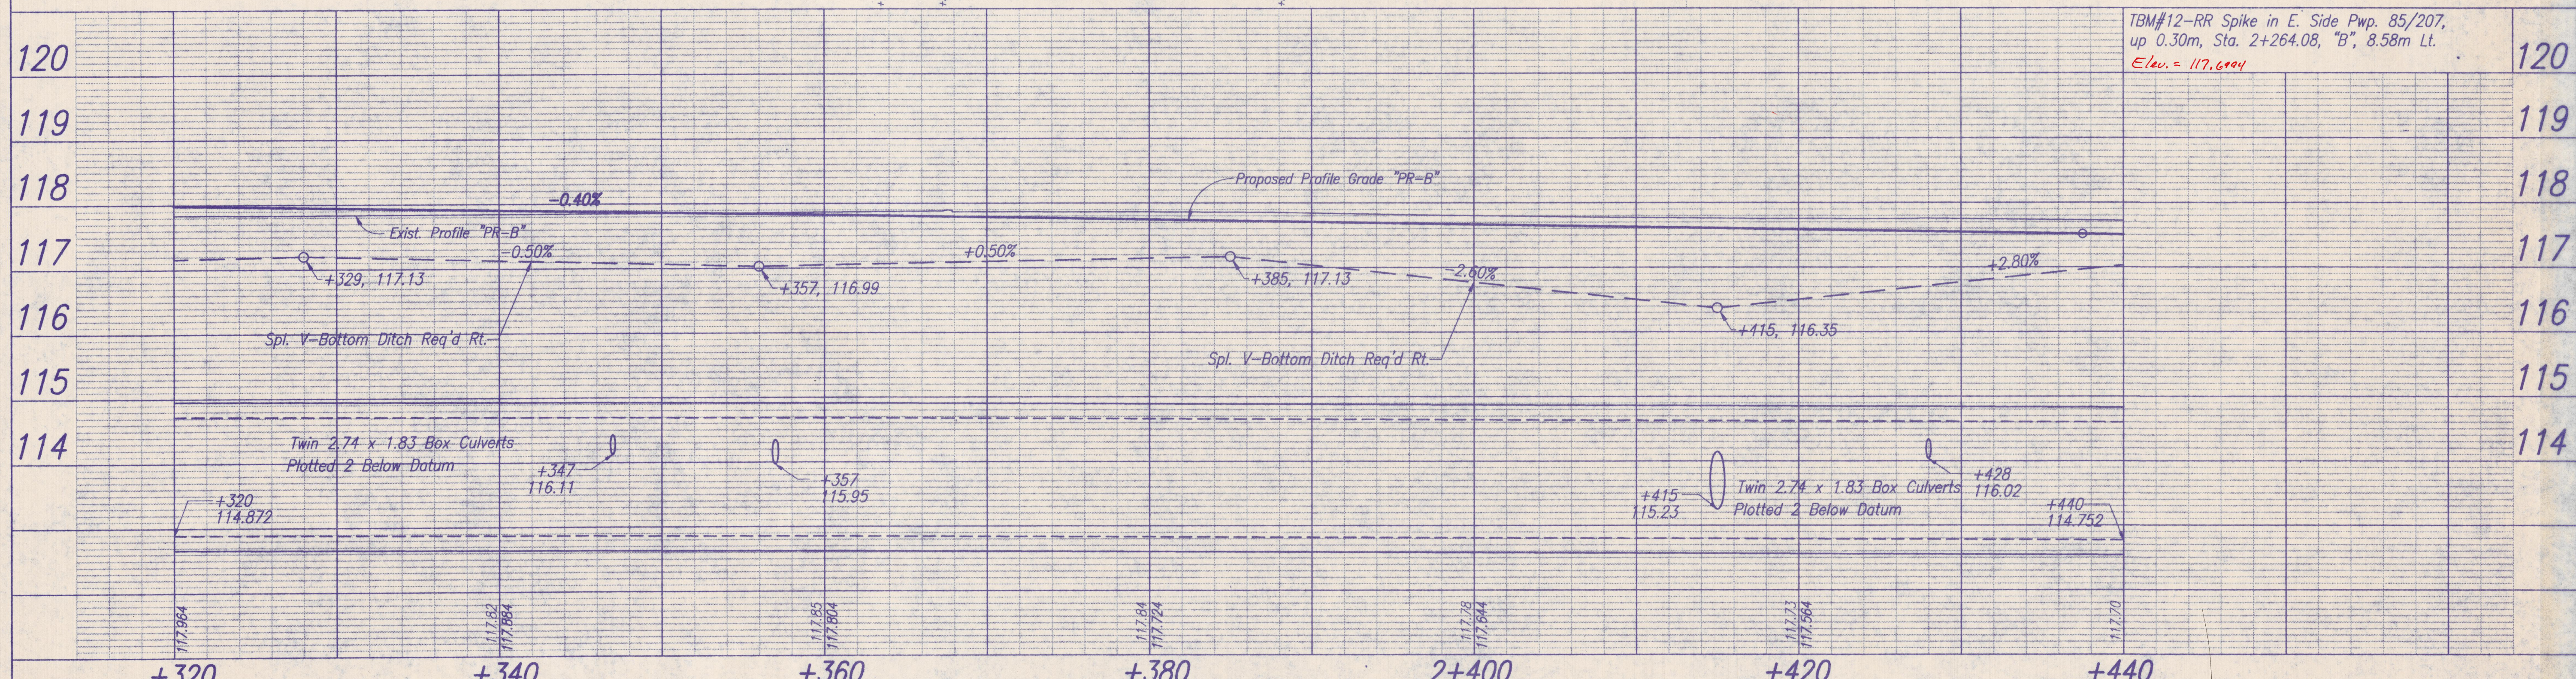

	RECOMMENDED FOR APPROVAL <i>Kent D. Downey 9/2/97</i> DESIGN ENGINEER DATE	INDIANA DEPARTMENT OF TRANSPORTATION PLAN & PROFILE BURKHARDT ROAD	HORIZONTAL SCALE 1:200 VERTICAL SCALE 1:50 SURVEY BOOK CONTRACT
DESIGNED: ATW, DAV CHECKED: GLR	DRAWN: ATW, DAV, JRF CHECKED: GLR	SHEETS 11 of 90 PROJECT VC97-09-01	BRIDGE FILE DESIGNATION SHEETS