



P:\jobs\96403\dwg\PP\CENTRAL\PP16C 9-17-97 8:36:42 am EST

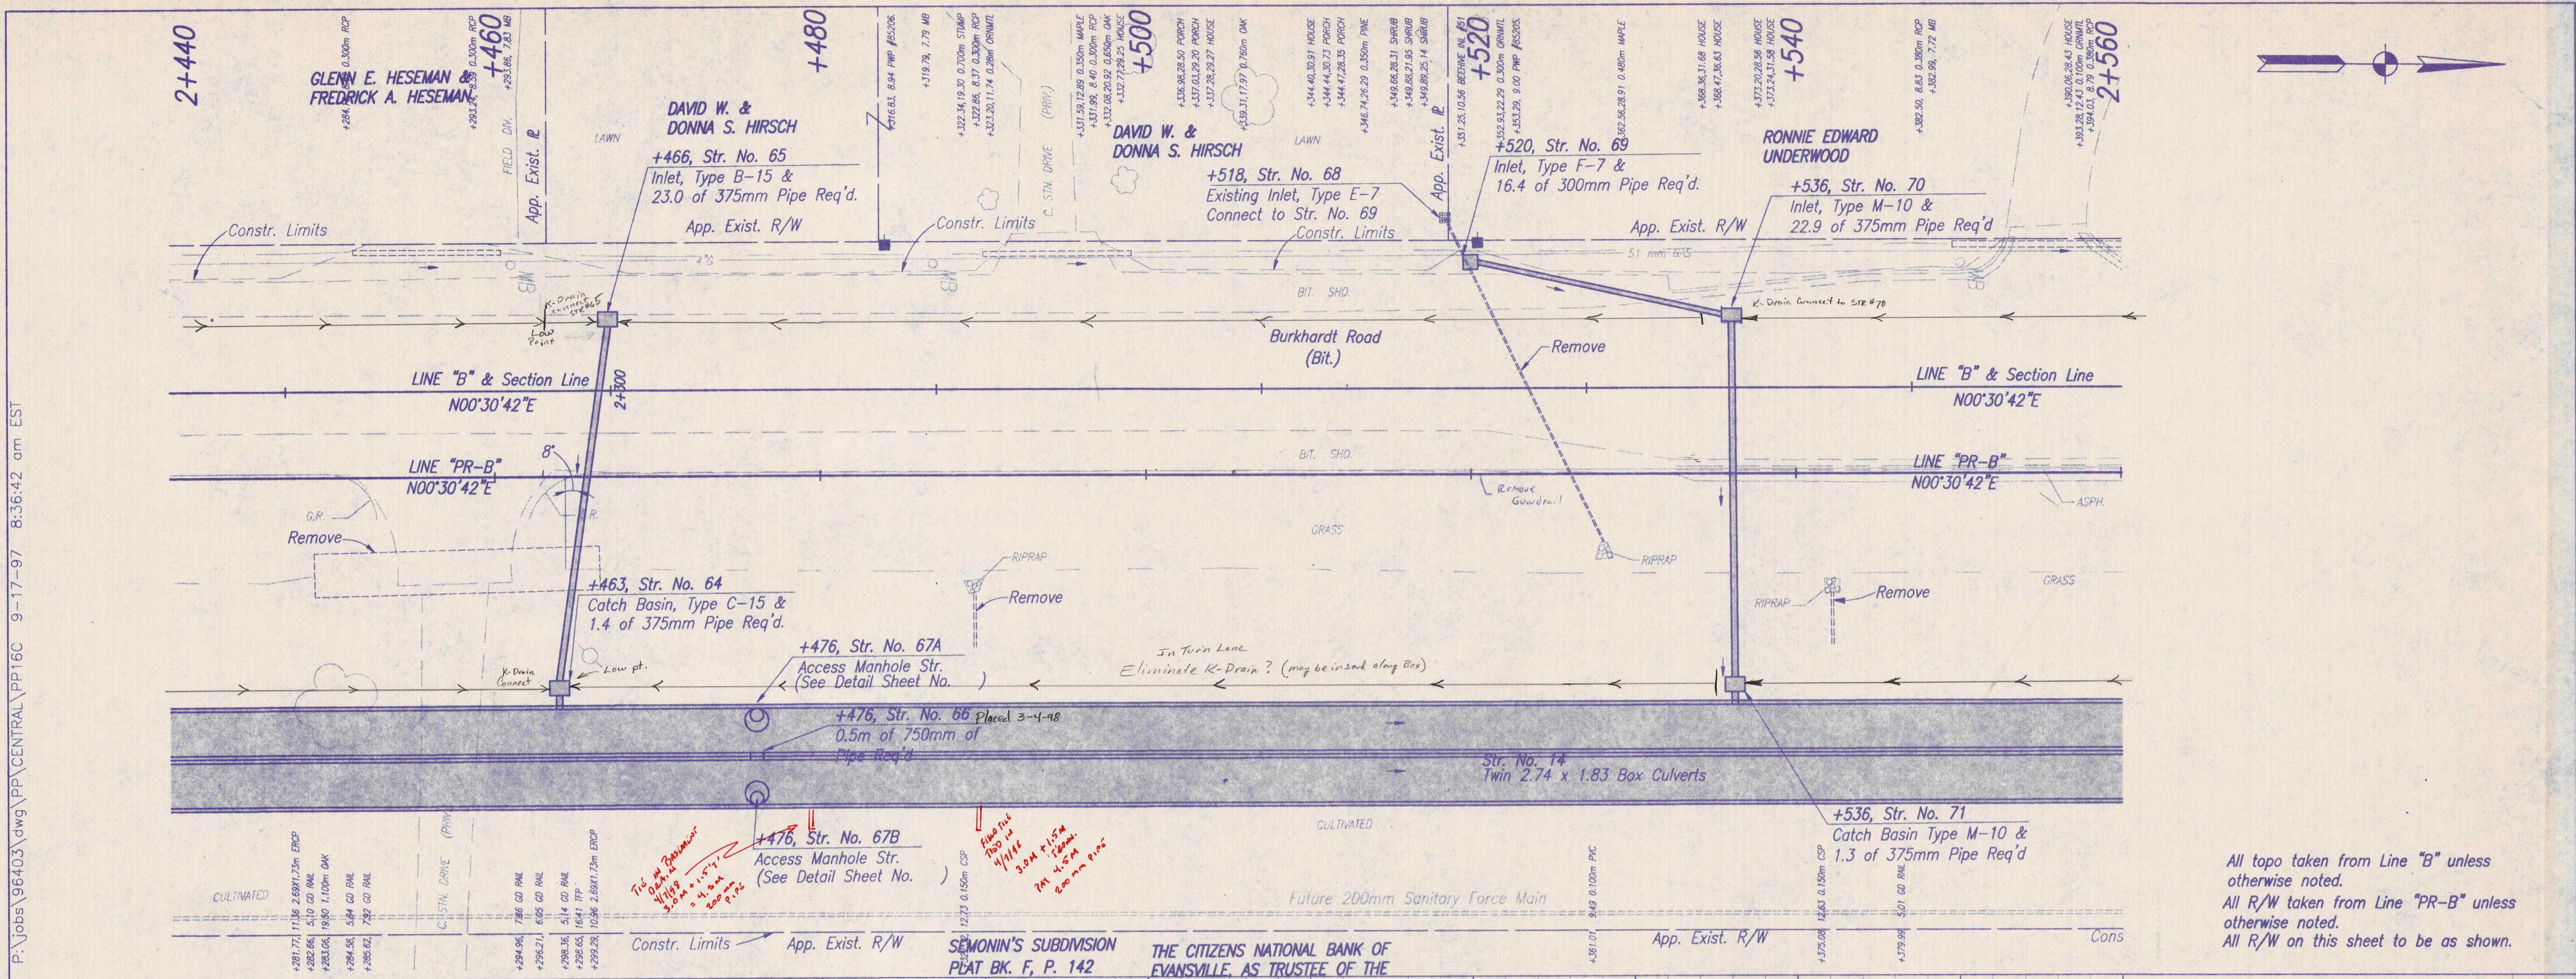

All topo taken from Line "B" unless otherwise noted.
All R/W taken from Line "PR-B" unless otherwise noted.
All R/W on this sheet to be as shown.

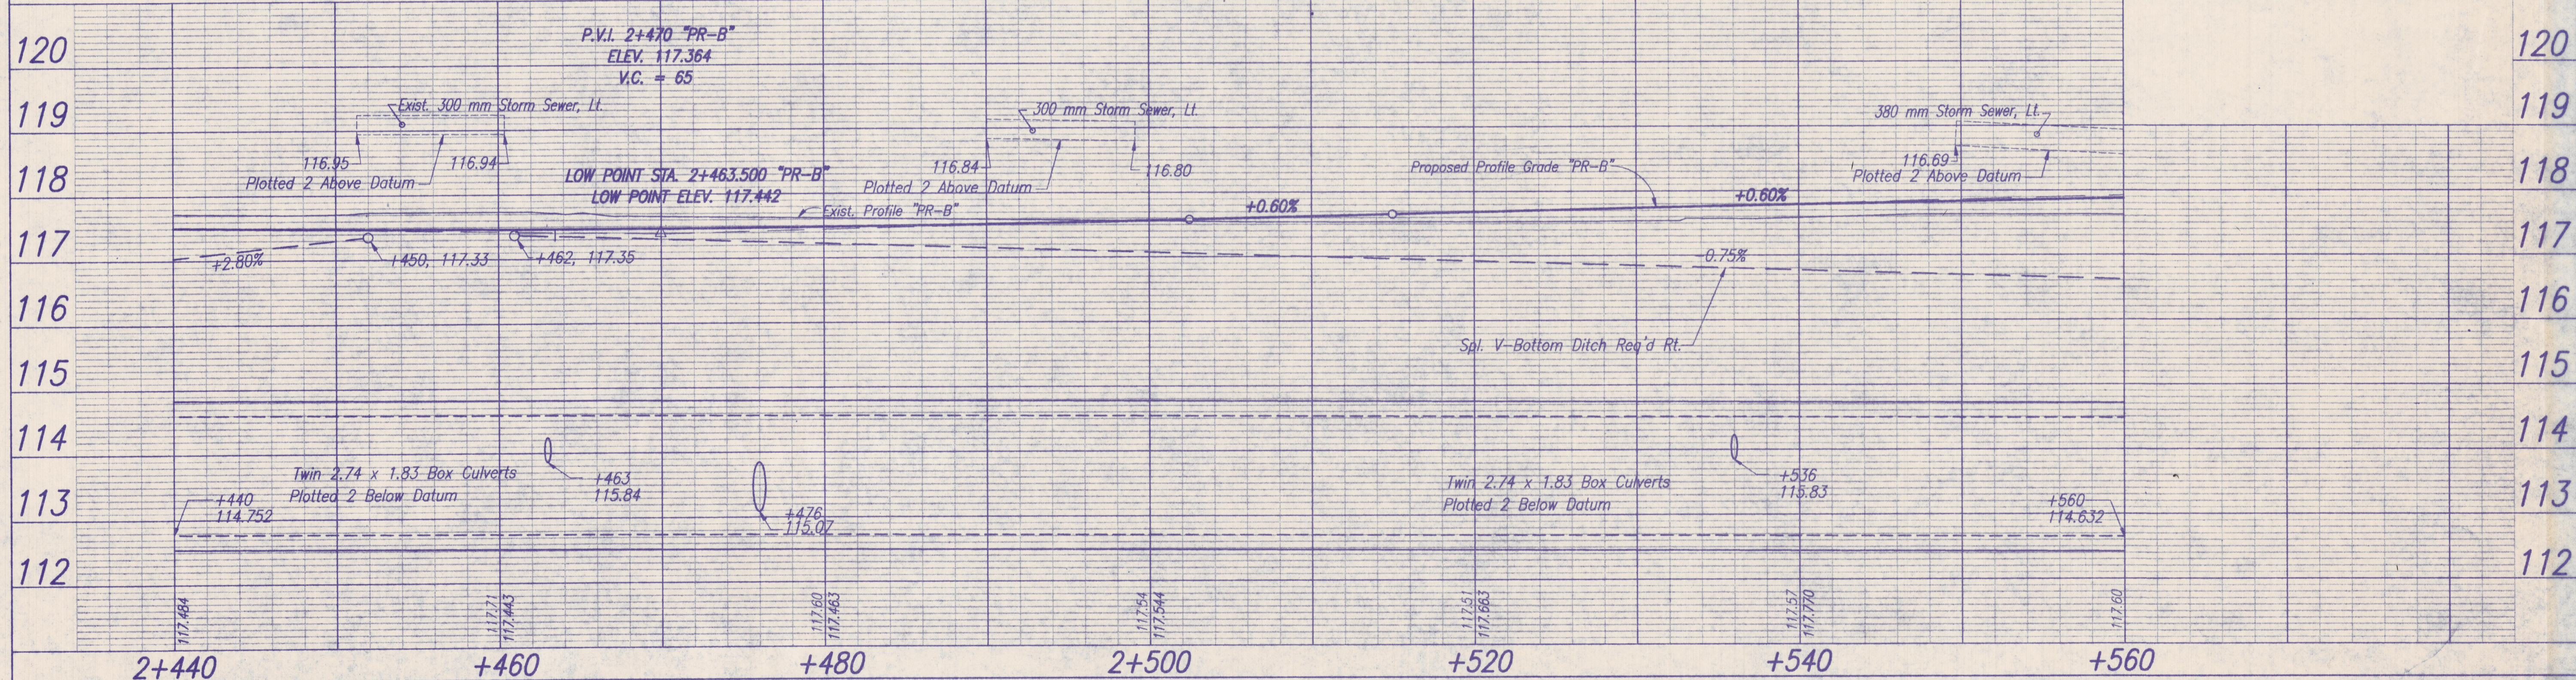

2+440	2+460	2+480	2+500	2+520	2+540	2+560
-------	-------	-------	-------	-------	-------	-------

	RECOMMENDED FOR APPROVAL	DESIGNED: ATW, DAV	DRAWN: ATW, DAV, JRF	INDIANA DEPARTMENT OF TRANSPORTATION PLAN & PROFILE BURKHARDT ROAD
	DATE: 9/19/97	CHECKED: GLR	CHECKED: GLR	

HORIZONTAL SCALE 1:200	BRIDGE FILE
VERTICAL SCALE 1:50	DESIGNATION
SURVEY BOOK	SHEETS 12 of 90
CONTRACT	PROJECT VC97-09-01