P:\Jobs\96403\dwg\PP\CENTRAL\PP18C 9-17-97 8:40:57 am EST

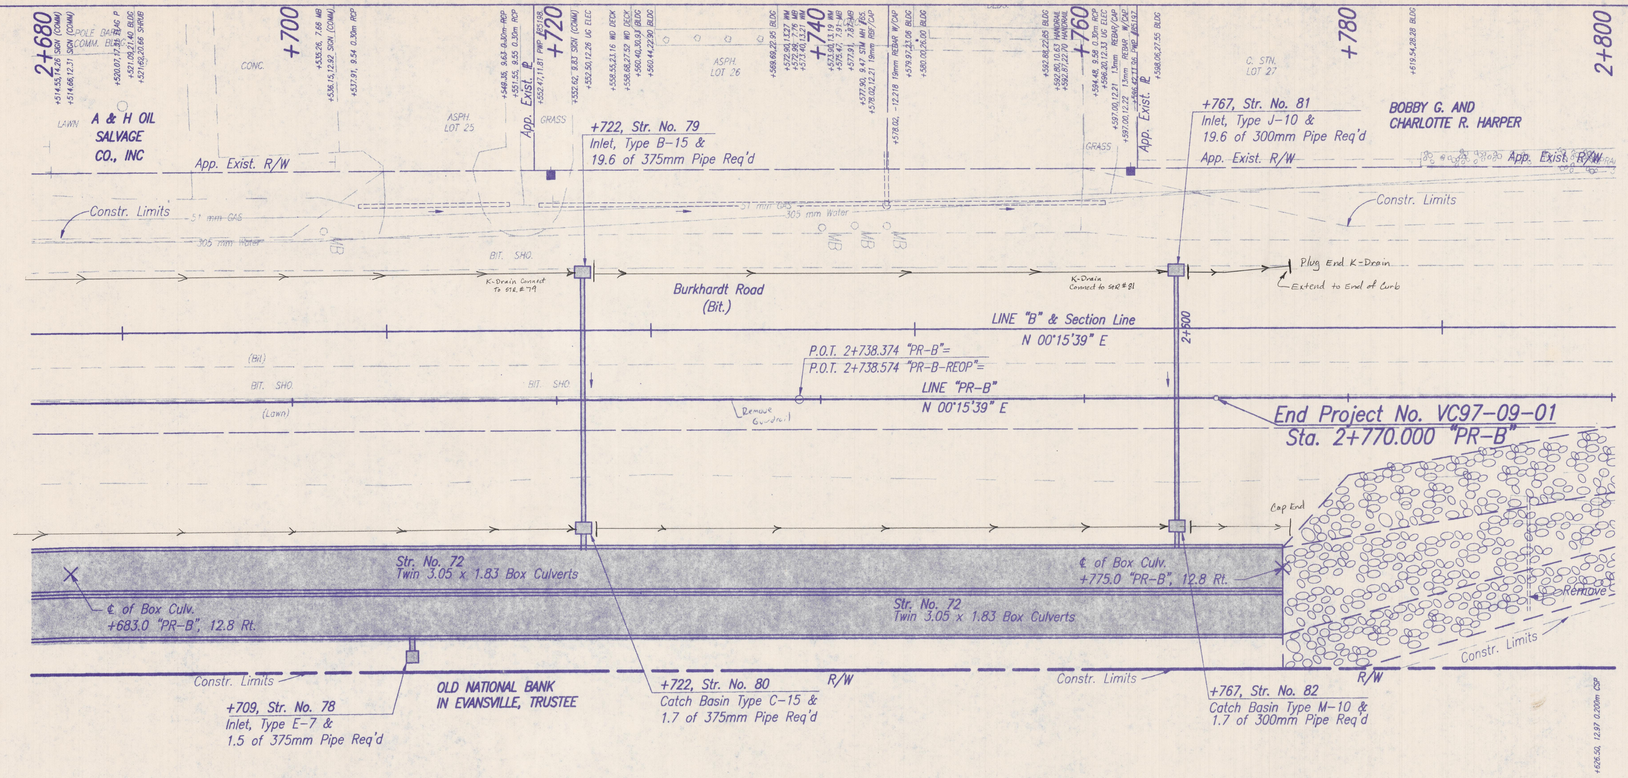

All topo taken from Line "B" unless otherwise noted.
All R/W taken from Line "PR-B" unless otherwise noted.
All R/W on this sheet to be as shown.

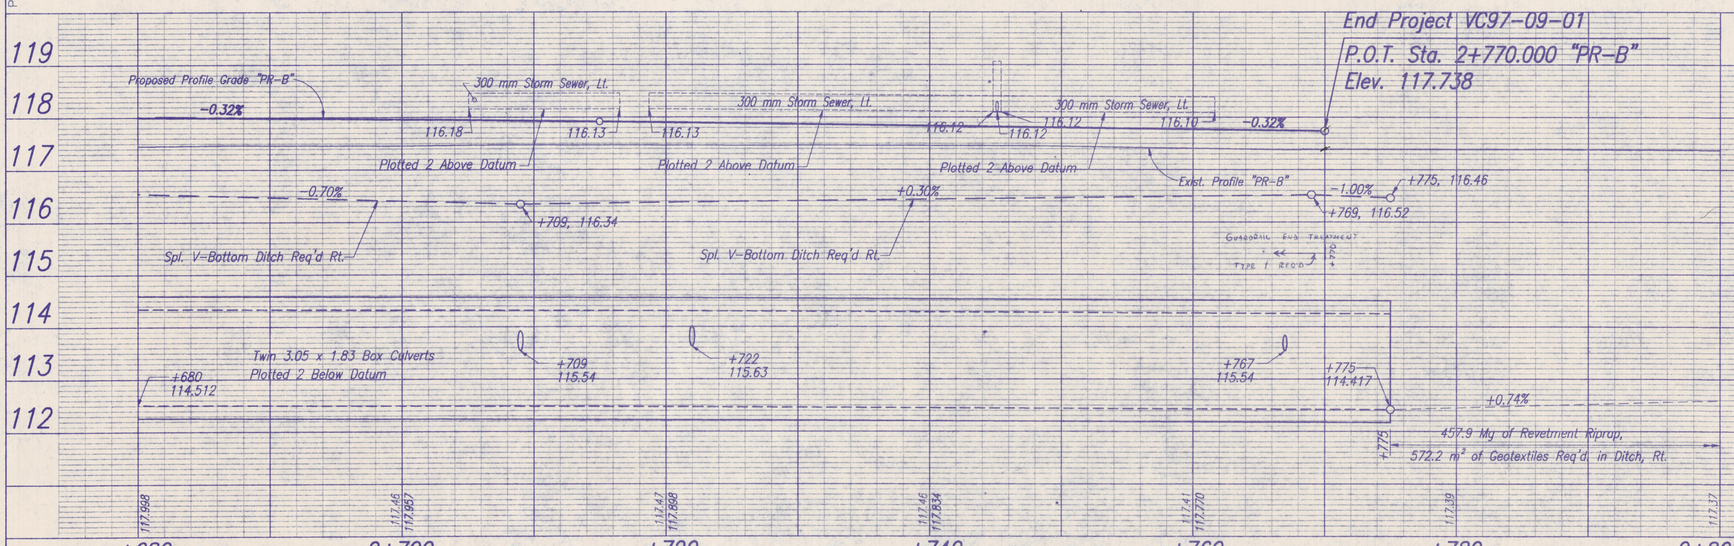

KENT DUANE DOWNEY
REGISTERED
15645
STATE OF
INDIANA
PROFESSIONAL ENGINEER

RECOMMENDED FOR APPROVAL: Keith V. Bourey 9/19/97
DESIGN ENGINEER DATE

DESIGNED: ATW, DAV
DRAWN: ATW, DAV, JRF
CHECKED: GLR
CHECKED: GLR

INDIANA DEPARTMENT OF TRANSPORTATION

PLAN & PROFILE
BURKHARDT ROAD

HORIZONTAL SCALE	BRIDGE FILE
1:200	
VERTICAL SCALE	DESIGNATION
1:50	
SURVEY BOOK	SHEETS
	14 of 90
CONTRACT	PROJECT
	VC97-09-01