
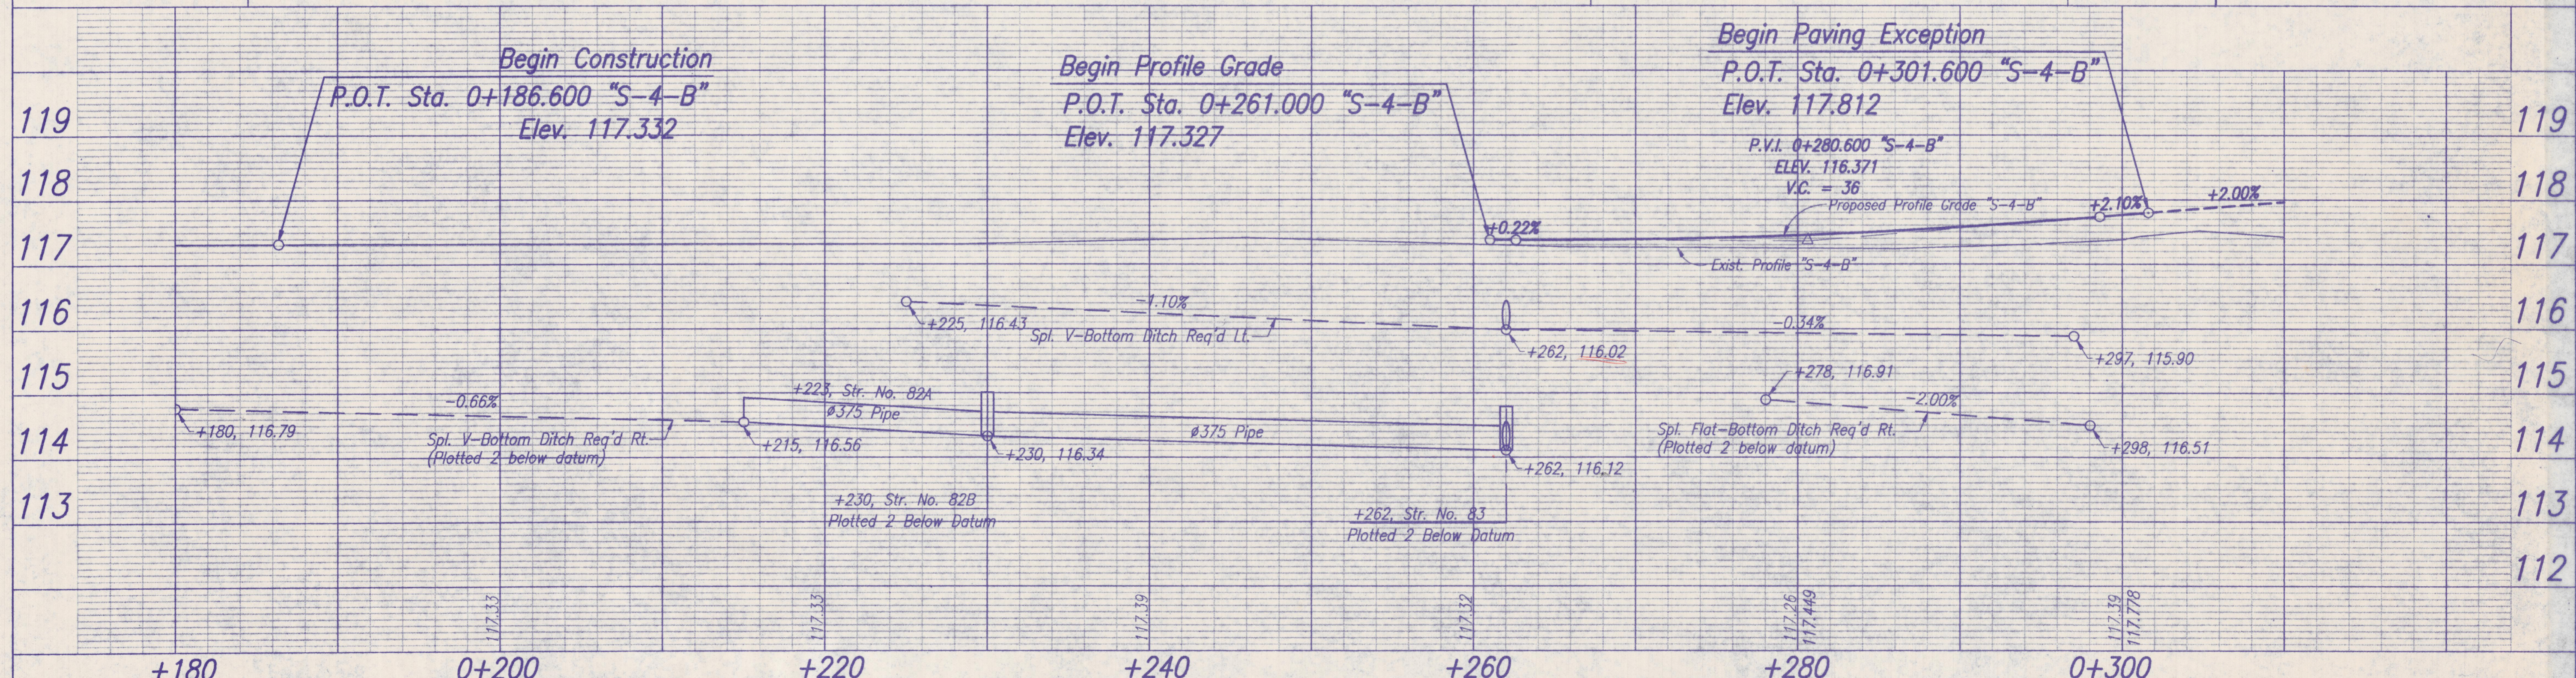


P:\Jobs\96403\dwg\PP\CENTRAL\PPS4B01 9-17-97 8:54:50 am EST

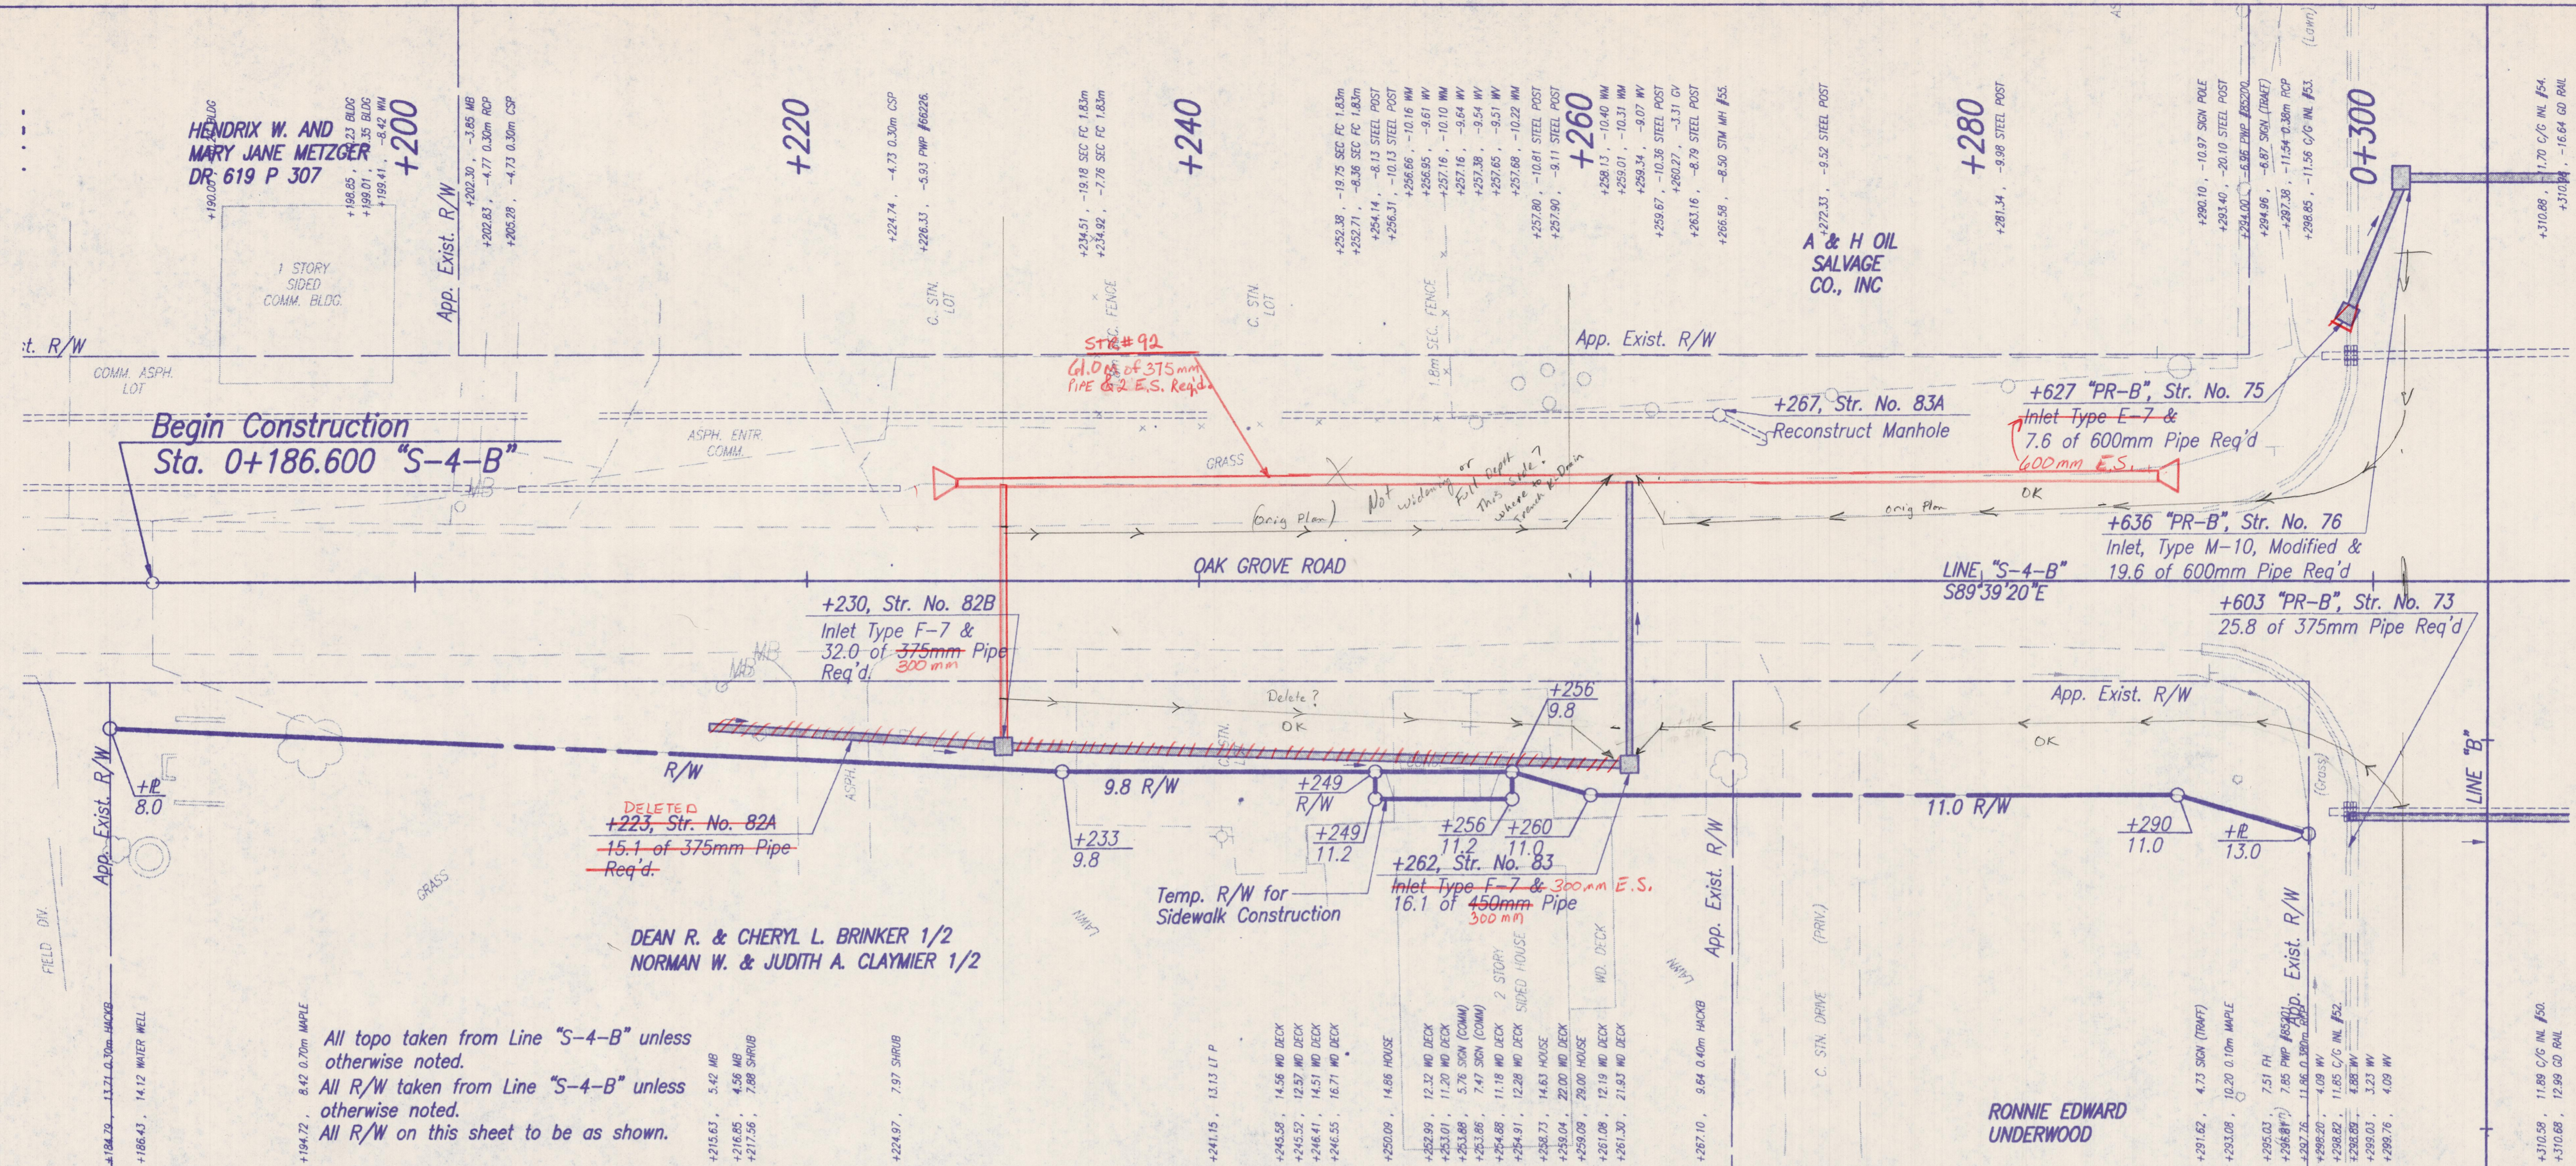

		RECOMMENDED FOR APPROVAL <i>Kent D. Downey</i> 9/19/97 DESIGN ENGINEER DATE	INDIANA DEPARTMENT OF TRANSPORTATION	HORIZONTAL SCALE 1:200 BRIDGE FILE
DESIGNED: ATW, DAV CHECKED: GLR	DRAWN: ATW, DAV, JRF CHECKED: GLR	PLAN & PROFILE OAK GROVE ROAD		VERTICAL SCALE 1:50 DESIGNATION
				SURVEY BOOK SHEETS 16 of 90
				CONTRACT PROJECT VC97-09-01