



P:\jobs\96403\dwg\PP\CENTRAL\PPS4802 9-17-97 8:56:52 am EST

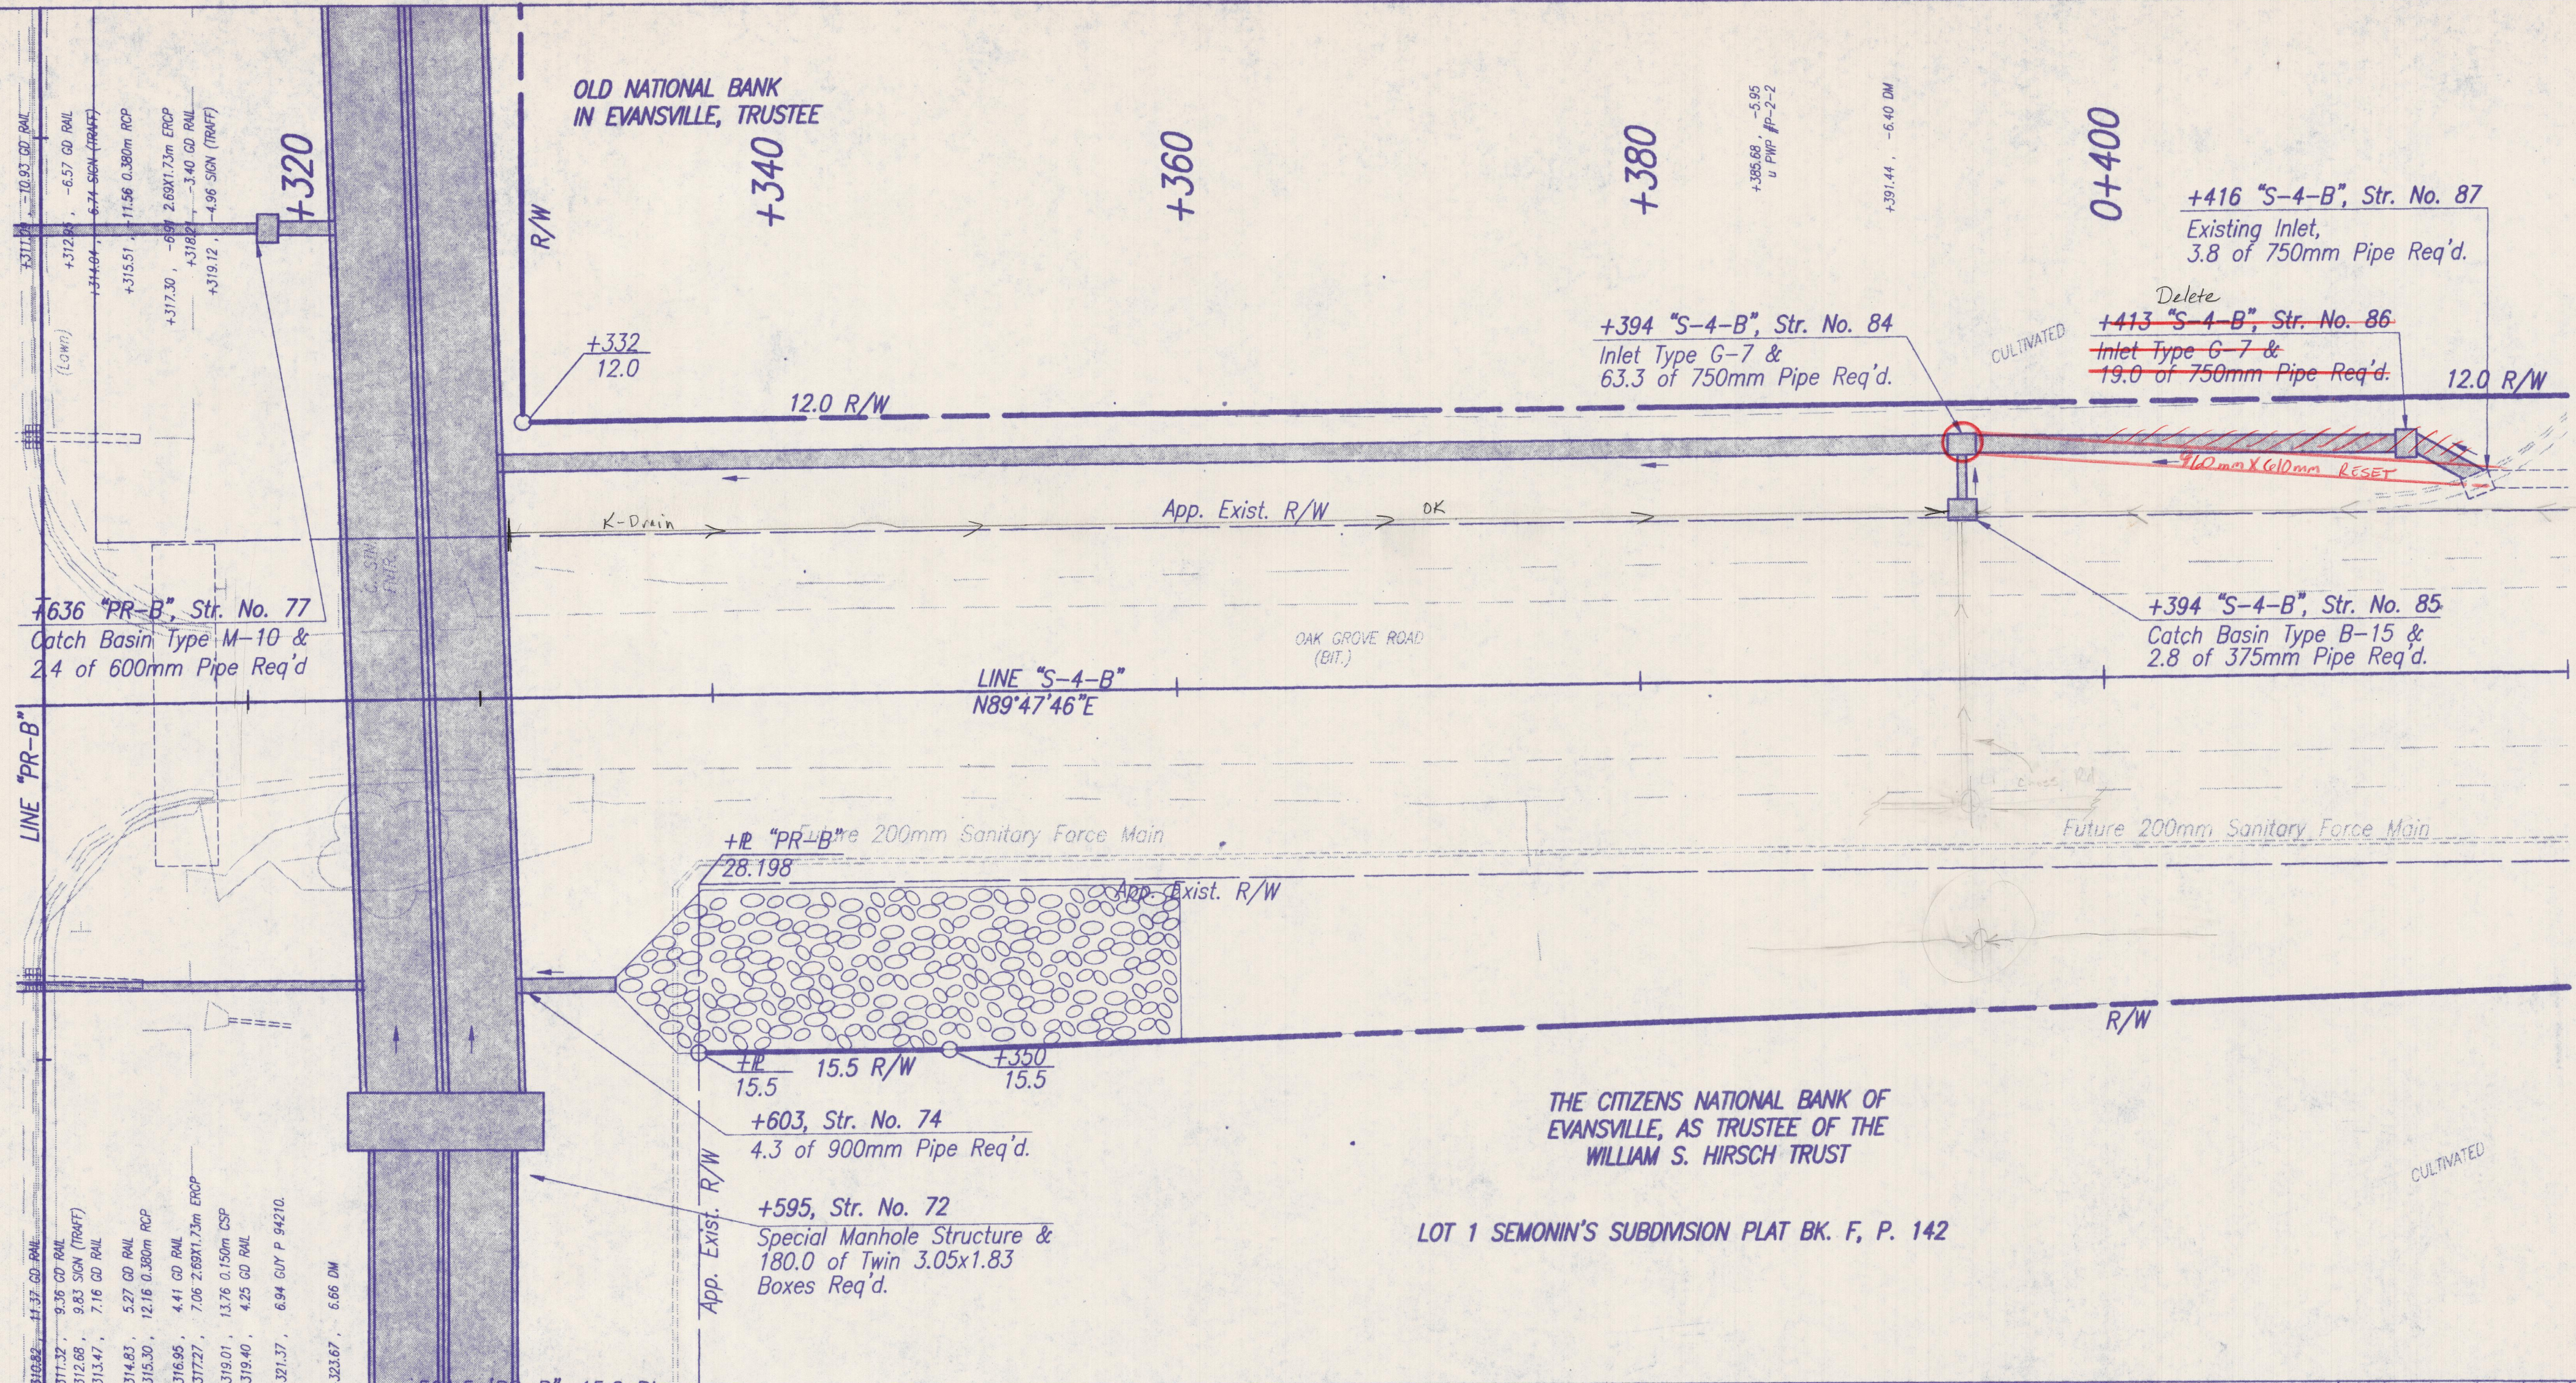

All topo taken from Line "S-4-B" unless otherwise noted.  
 All R/W taken from Line "S-4-B" unless otherwise noted.  
 All R/W on this sheet to be as shown.

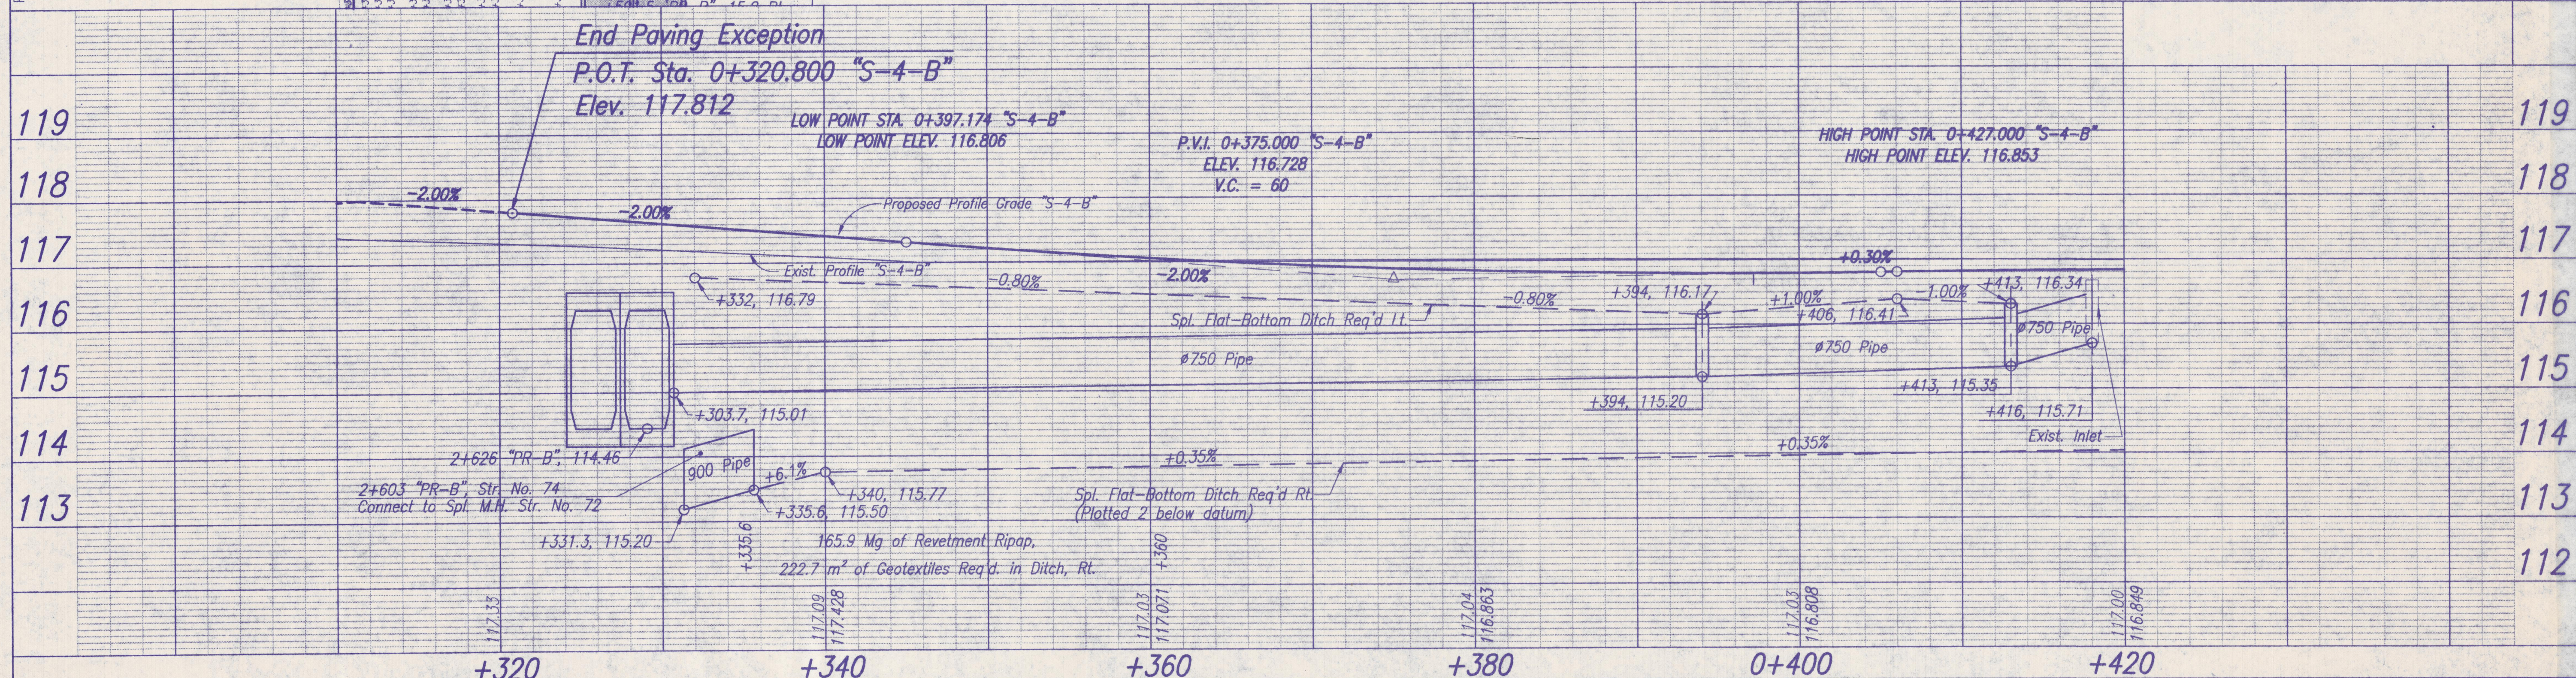

+320	+340	+360	+380
0+400	+420		

RECOMMENDED FOR APPROVAL *Kent D. Downey* 9/17/97  
 DESIGN ENGINEER DATE

DESIGNED: ATM, DAV DRAWN: ATM, DAV, JRF  
 CHECKED: GLR CHECKED: GLR

INDIANA DEPARTMENT OF TRANSPORTATION

**PLAN & PROFILE**  
**OAK GROVE ROAD**

HORIZONTAL SCALE	BRIDGE FILE
1:200	
VERTICAL SCALE	DESIGNATION
1:50	
SURVEY BOOK	SHEETS
	17 of 90
CONTRACT	PROJECT
	VC97-09-01