



P:\jobs\96403\dwg\CENTRAL\PPS4803 9-17-97 8:59:10 am EST

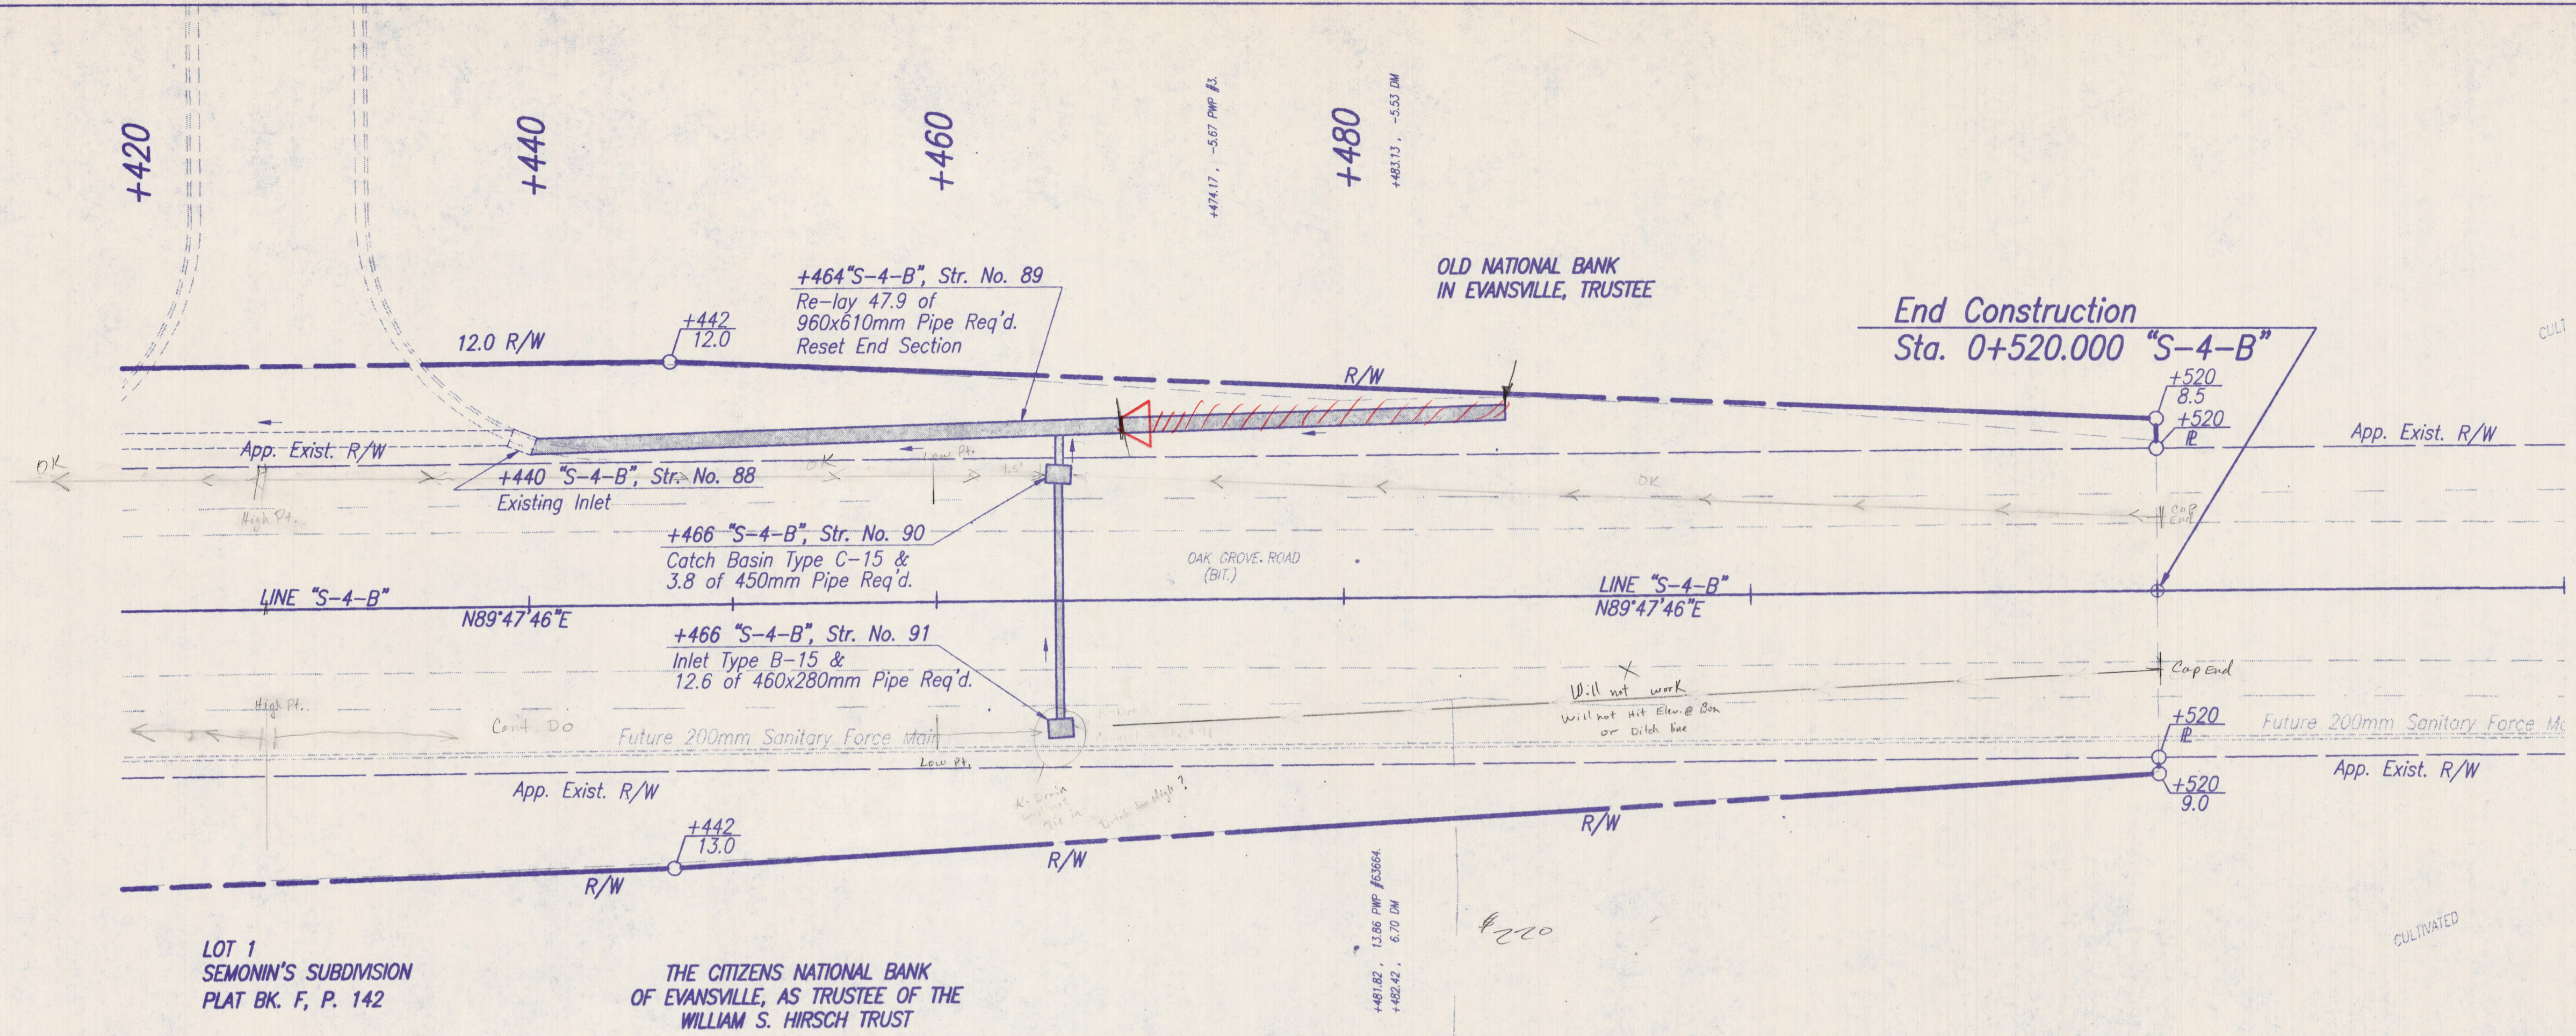

All topo taken from Line "S-4-B" unless otherwise noted.  
 All R/W taken from Line "S-4-B" unless otherwise noted.  
 All R/W on this sheet to be as shown.

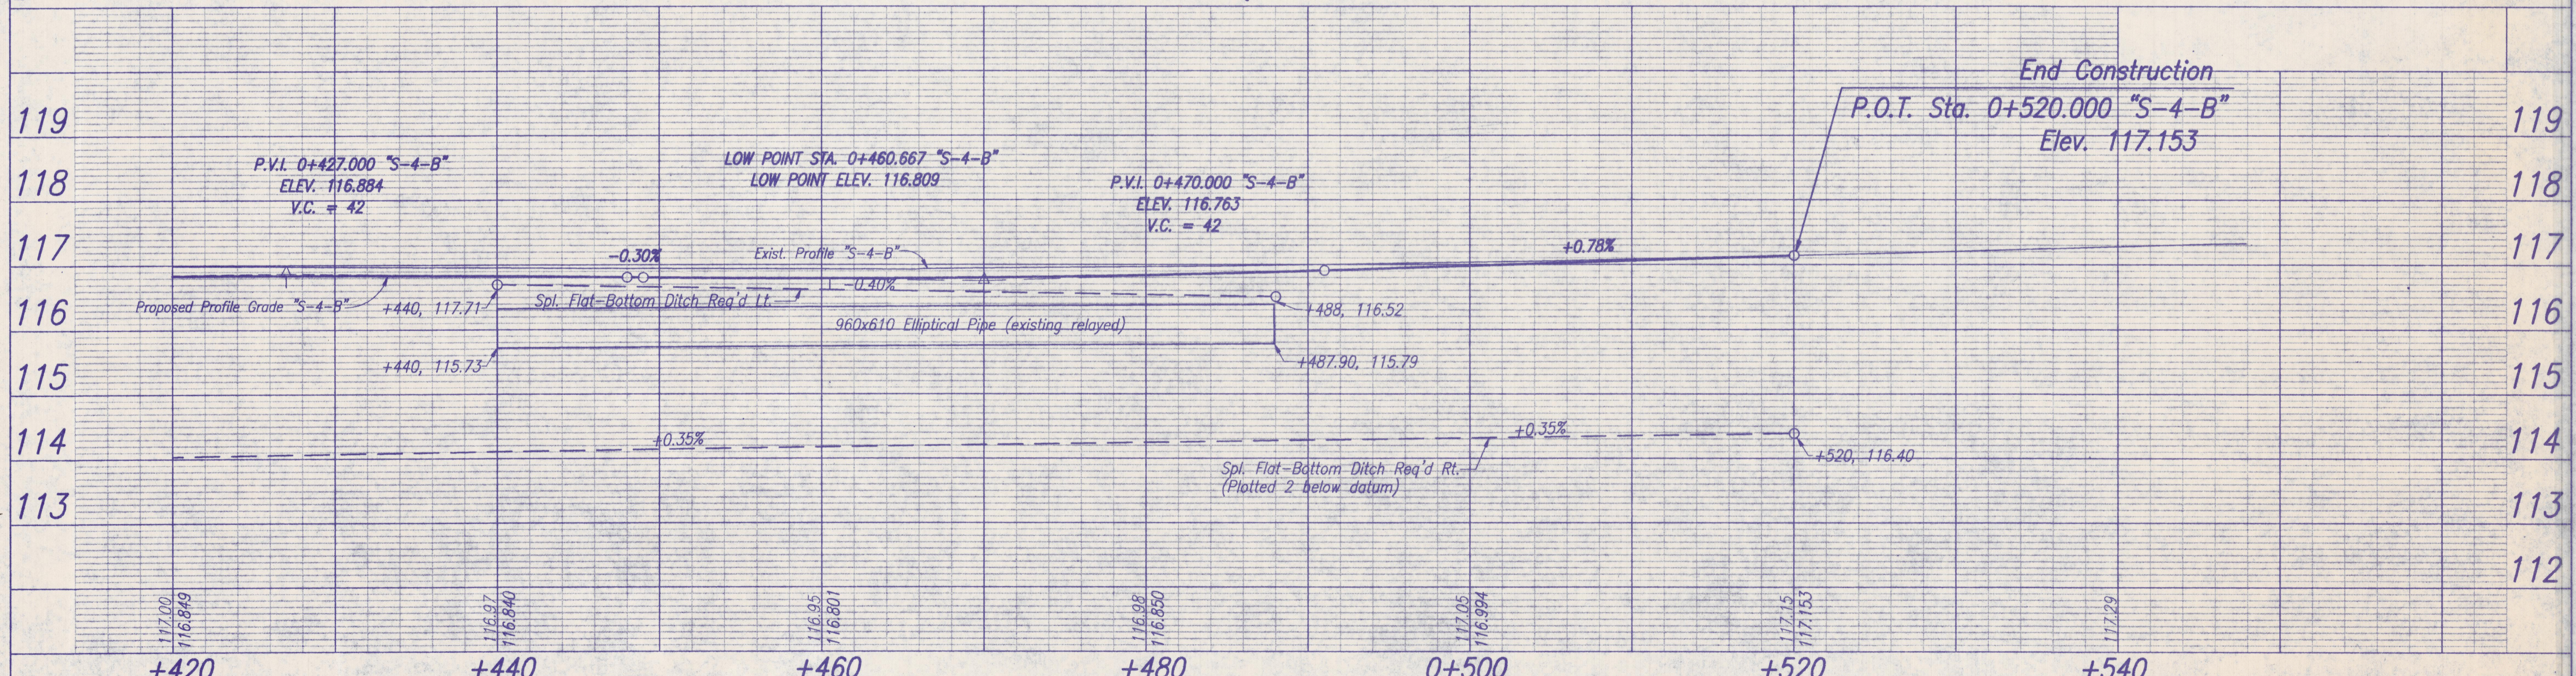

				RECOMMENDED FOR APPROVAL <i>Kent Duane Downey</i> 9/18/97 DESIGN ENGINEER DATE		<b>INDIANA DEPARTMENT OF TRANSPORTATION</b>		HORIZONTAL SCALE 1:200 BRIDGE FILE VERTICAL SCALE 1:50 DESIGNATION	
				DESIGNED: ATW, DAV DRAWN: ATW, DAV, JRF CHECKED: DAS CHECKED: DAS		<b>PLAN &amp; PROFILE OAK GROVE ROAD</b>		SURVEY BOOK SHEETS 18 of 90 CONTRACT PROJECT VC97-09-01	