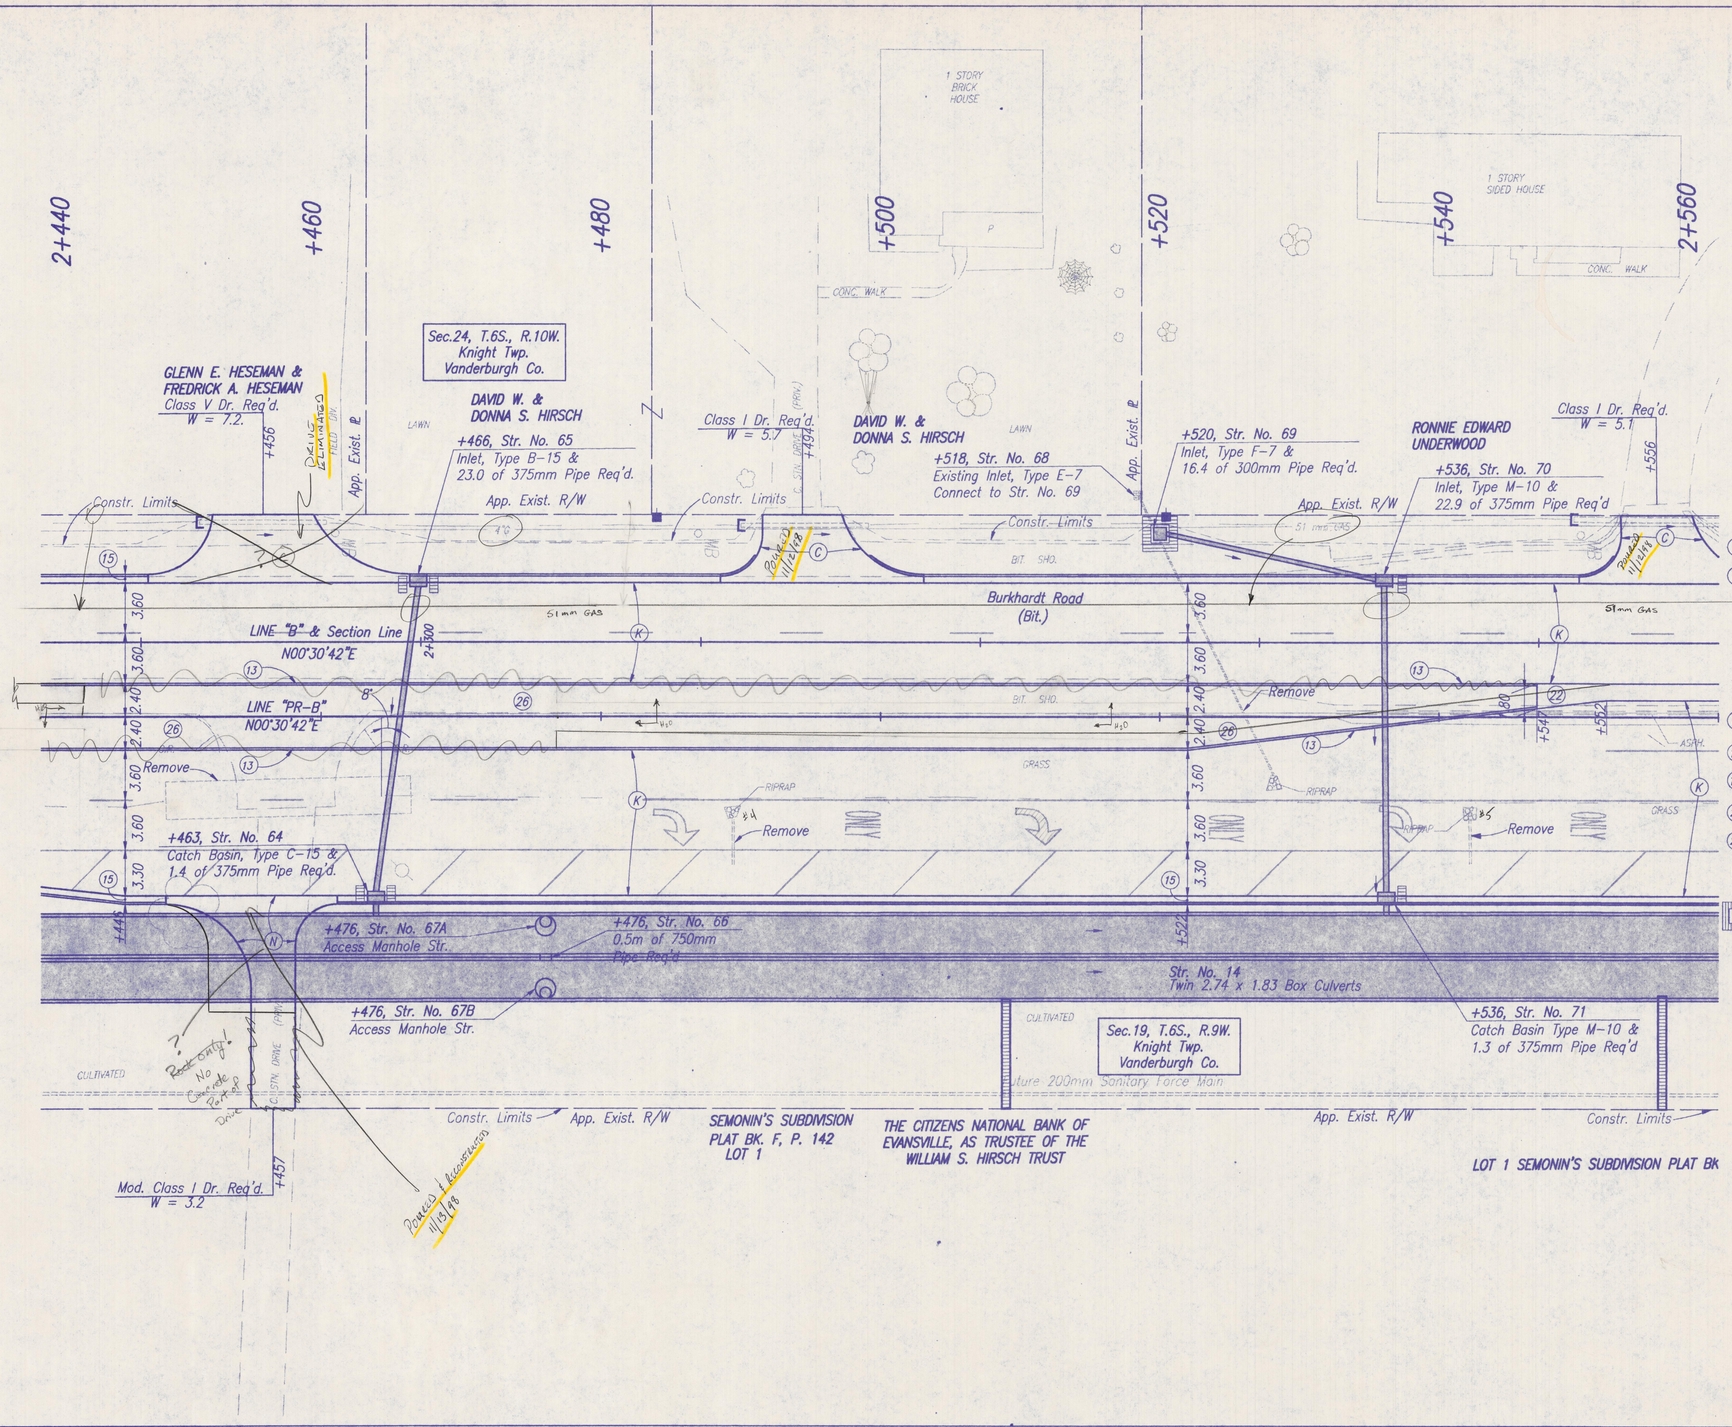

LEGEND

- (C) Cement Concrete Pavement for Drives, 150mm
- (K) Full Depth Bituminous Pavement
  - 60 kg/m² QC/QA HMA Surface 9.5mm, Mainline on
  - 150 kg/m² QC/QA HMA Intermediate 19.0mm, Mainline on
  - 270 kg/m² QC/QA HMA Base 25.0mm, Mainline on
  - 248 kg/m² HMA Base C25.0mm, Mainline on
  - 270 kg/m² QC/QA HMA Base 25.0mm, Mainline
- (N) 150mm Compacted Aggregate for Base, Type "O", #53
- (13) Curb, Concrete
- (15) Curb and Gutter, Concrete, Modified
- (22) Center Curb, Type "D"
- (26) Sodding
- Temporary Erosion and Sediment Control, Culvert Pipe Protection
- Temporary Erosion and Sediment Control, Drop Inlet Protection
- Temporary Erosion and Sediment Control, Curb Inlet Protection
- Temporary Erosion and Sediment Control, Straw Bale Ditch Check

All R/W taken from Line "PR-B" unless otherwise noted.
All R/W on this sheet to be as shown.

P:\jobs\96403\dwg\DET\CENTRAL\DET-008 9-17-97 9:17:59 am EST

KENT DUANE DOWNEY REGISTERED 15645 STATE OF INDIANA PROFESSIONAL ENGINEER

RECOMMENDED FOR APPROVAL: Kent D. Downey 9/17/97
DESIGN ENGINEER — DATE

DESIGNED: ATW | DRAWN: CEB
CHECKED: GLR | CHECKED: GLR

INDIANA DEPARTMENT OF TRANSPORTATION

CONSTRUCTION DETAIL
BURKHARDT ROAD

HORIZONTAL SCALE	BRIDGE FILE
1:200	
VERTICAL SCALE	DESIGNATION
N/A	
SURVEY BOOK	SHEETS
	27 of 90
CONTRACT	PROJECT
	VC97-09-01