


P:\jobs\96403\dwg\DET\CENTRAL\DET-009 9-17-97 9:22:57 am EST

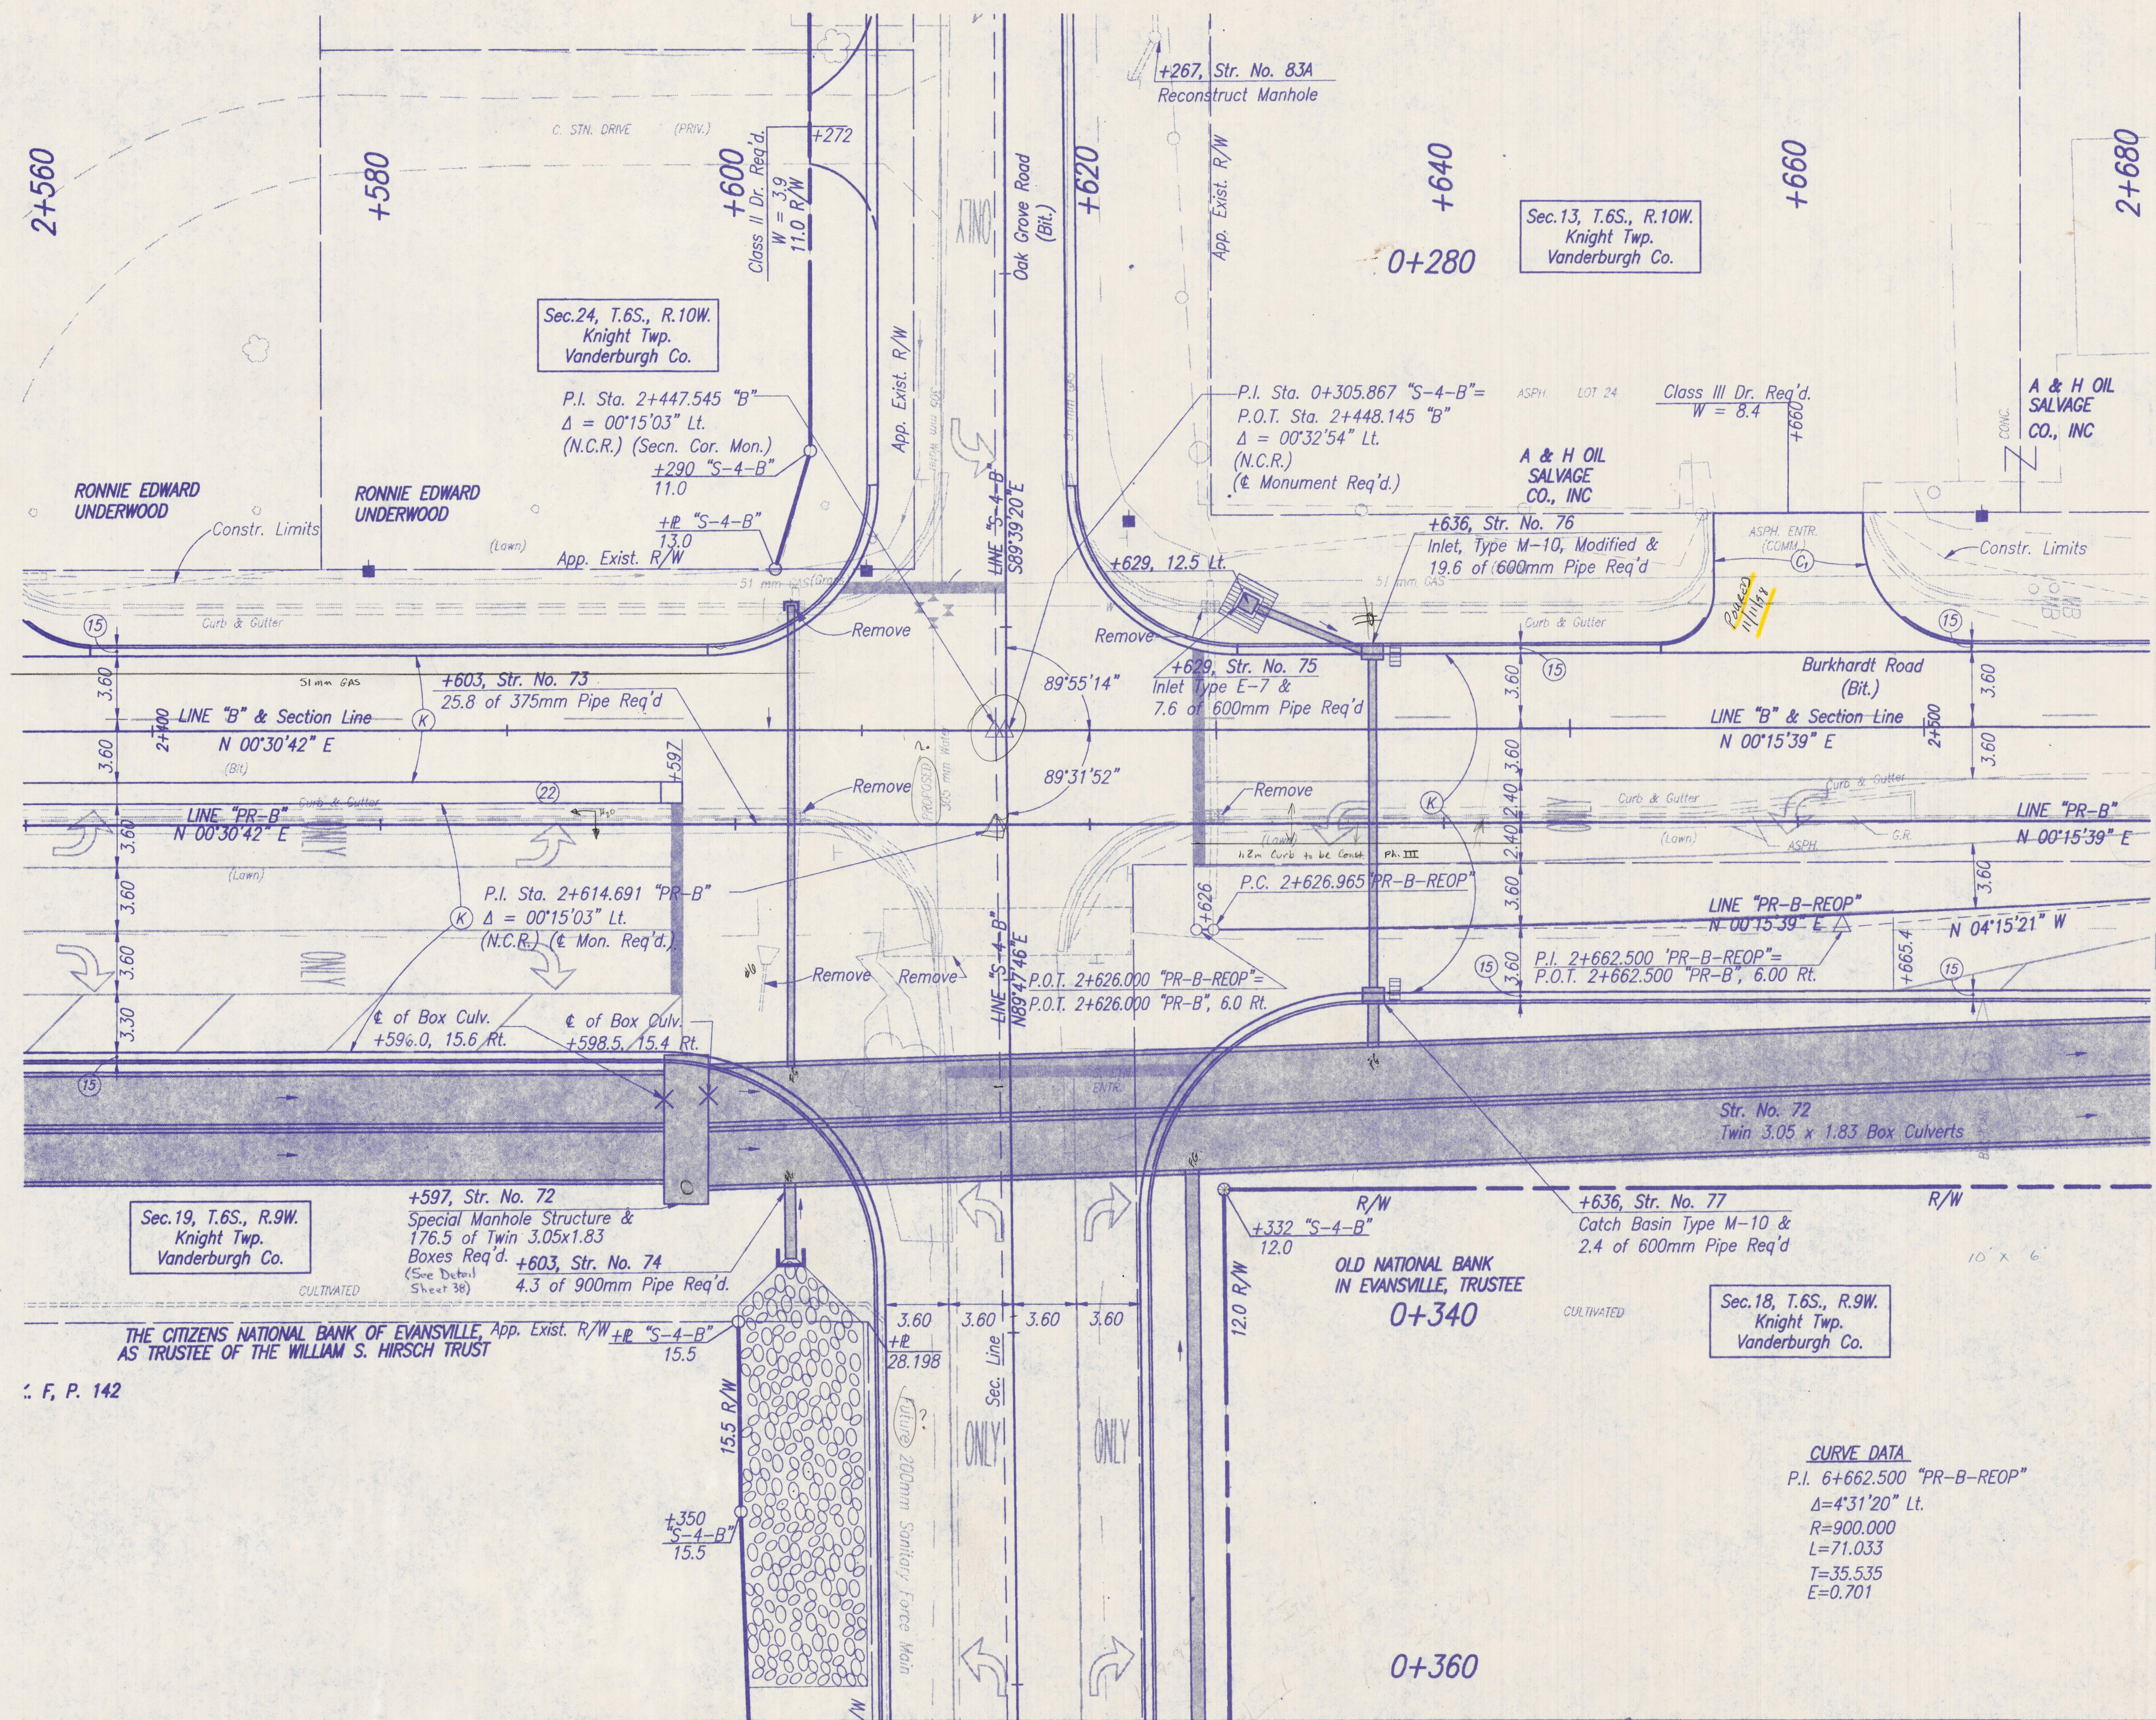

- LEGEND**
- (C) Cement Concrete Pavement for Drives, 200mm on 150mm Compacted Aggregate For Base Type "O", #53
 - (D) HMA for Approaches
60 kg/m² QC/QA HMA Surface 9.5mm, on 180 kg/m² QC/QA HMA Base 25.0mm
 - (K) Full Depth Bituminous Pavement
60 kg/m² QC/QA HMA Surface 9.5mm, Mainline on 150 kg/m² QC/QA HMA Intermediate 19.0mm, Mainline on 270 kg/m² QC/QA HMA Base 25.0mm, Mainline on 248 kg/m² HMA Base C25.0mm, Mainline on 270 kg/m² QC/QA HMA Base 25.0mm, Mainline
 - (15) Curb and Gutter, Concrete, Modified
 - (22) Center Curb, Type "D"
 - [] Temporary Erosion and Sediment Control, Culvert Pipe Protection
 - [] Temporary Erosion and Sediment Control, Drop Inlet Protection
 - [] Temporary Erosion and Sediment Control, Curb Inlet Protection

CURVE DATA
 P.I. 6+662.500 "PR-B-REOP"
 Δ = 4°31'20" Lt.
 R = 900.000
 L = 71.033
 T = 35.535
 E = 0.701

All R/W taken from Line "PR-B" unless otherwise noted.
 All R/W on this sheet to be as shown.

	RECOMMENDED FOR APPROVAL	<i>Kenneth Downey</i>	DATE	INDIANA DEPARTMENT OF TRANSPORTATION	HORIZONTAL SCALE	BRIDGE FILE
	DESIGNED: ATW	DRAWN: CEB		CONSTRUCTION DETAIL	SURVEY BOOK	SHEETS
	CHECKED: GLR	CHECKED: GLR		BURKHARDT ROAD	CONTRACT	28 of 90 PROJECT
					N/A	DESIGNATION
						VC97-09-01