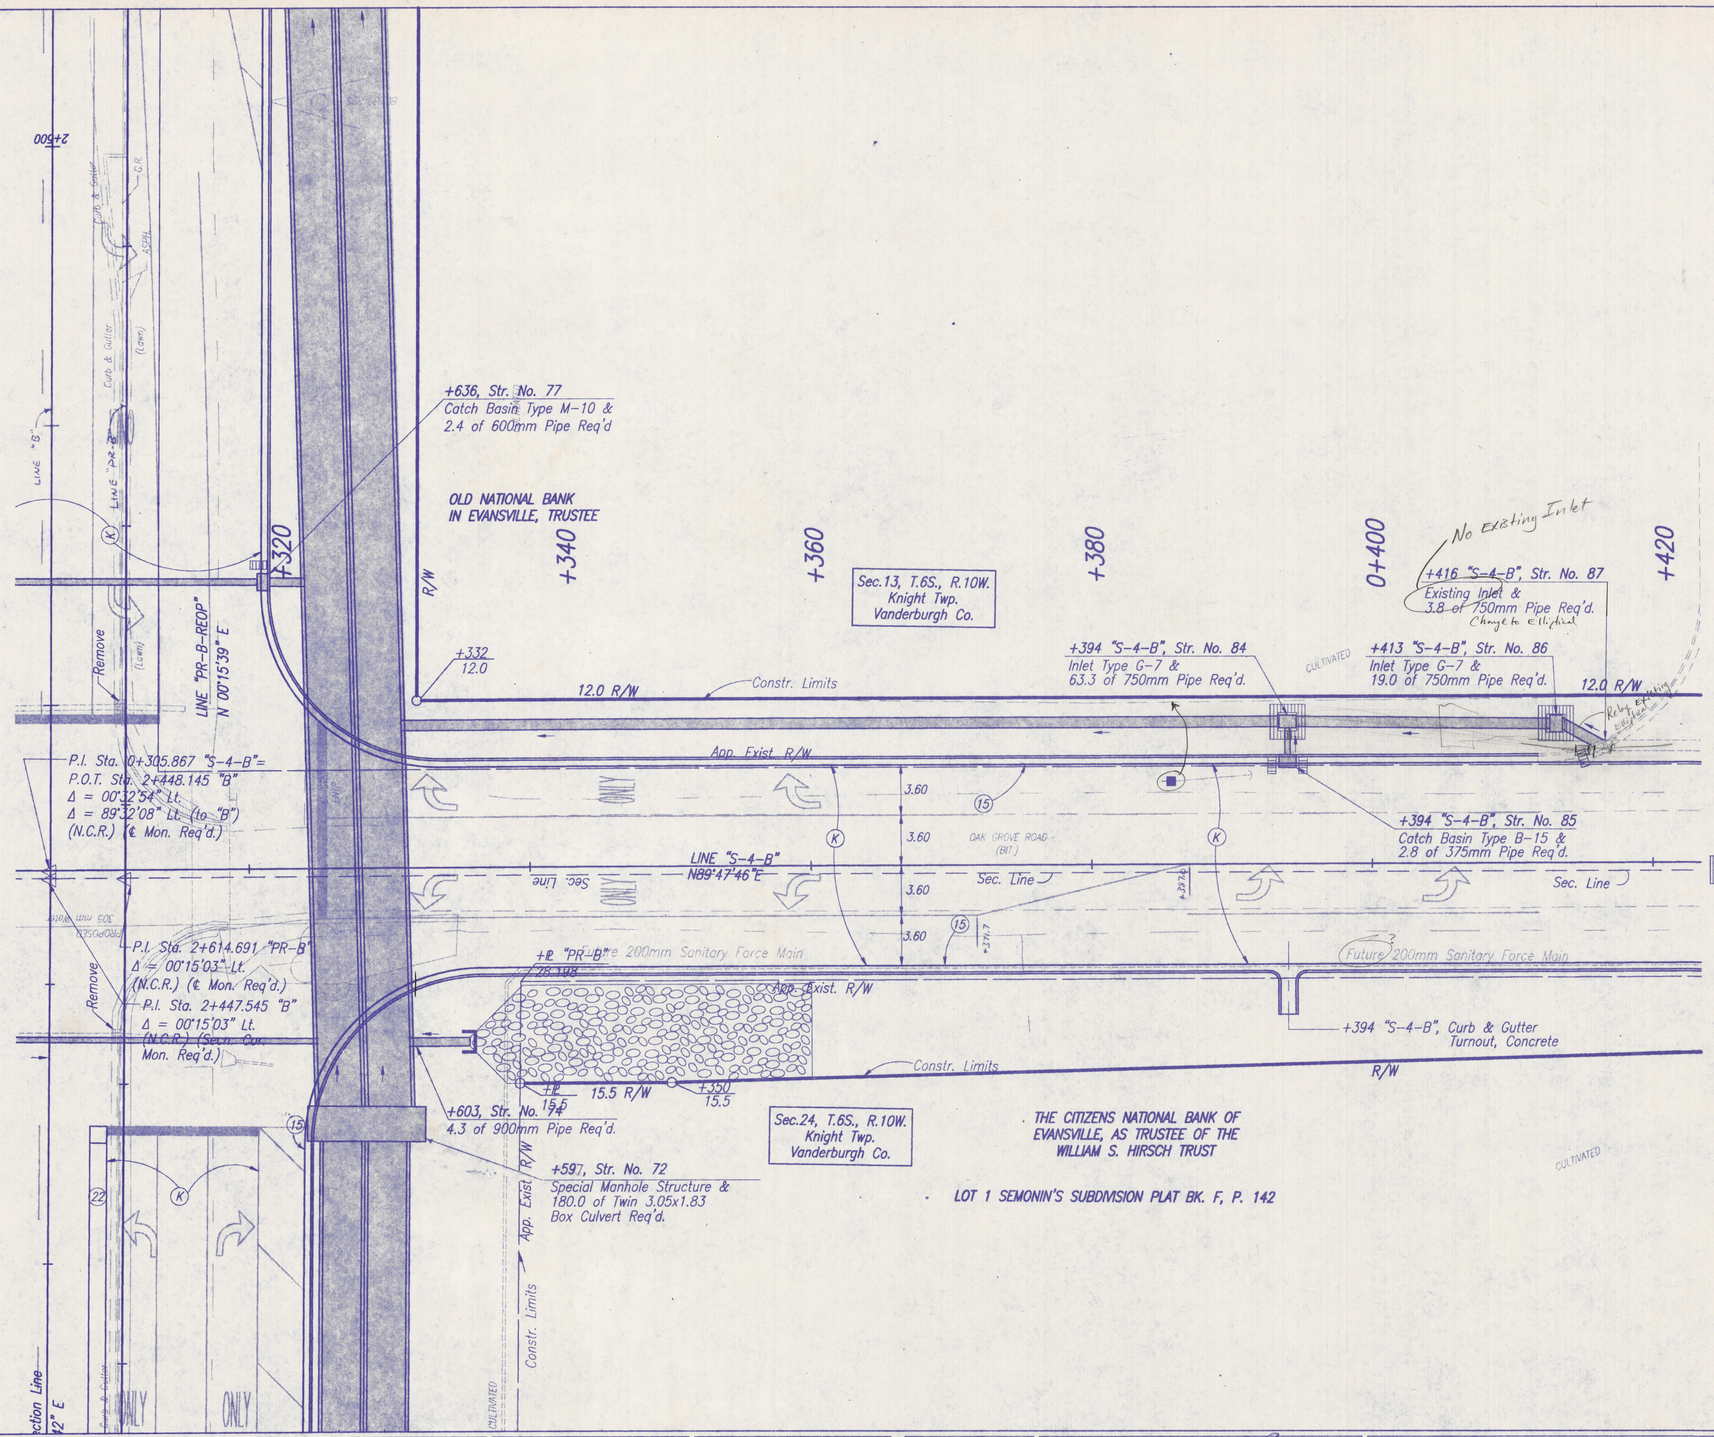

LEGEND

- (K) Full Depth Bituminous Pavement
  - 60 kg/m² QC/QA HMA Surface 9.5mm, Mainline on
  - 150 kg/m² QC/QA HMA Intermediate 19.0mm, Mainline on
  - 270 kg/m² QC/QA HMA Base 25.0mm, Mainline on
  - 248 kg/m² HMA Base C25.0mm, Mainline on
  - 270 kg/m² QC/QA HMA Base 25.0mm, Mainline
- (15) Curb and Gutter, Concrete, Modified
- (22) Center Curb, Type "D"
- Temporary Erosion and Sediment Control, Drop Inlet Protection
- Temporary Erosion and Sediment Control, Curb Inlet Protection
- Temporary Erosion and Sediment Control, Culvert Pipe Protection

All R/W taken from Line "S-4-B" unless otherwise noted.
All R/W on this sheet to be as shown.

P:\Jobs\96403\dwg\DET\CENTRAL\DET-018 9-17-97 9:39:39 am EST

KENT DUANE DOWNEY REGISTERED 15645 STATE OF INDIANA PROFESSIONAL ENGINEER

RECOMMENDED FOR APPROVAL _____ DESIGN ENGINEER DATE 9/18/97

DESIGNED: ATW DRAWN: CEB

CHECKED: GLR CHECKED: GLR

INDIANA DEPARTMENT OF TRANSPORTATION

CONSTRUCTION DETAIL
OAK GROVE ROAD

HORIZONTAL SCALE 1:200	BRIDGE FILE
VERTICAL SCALE N/A	DESIGNATION
SURVEY BOOK	SHEETS 32 of 90
CONTRACT	PROJECT VC97-09-01