

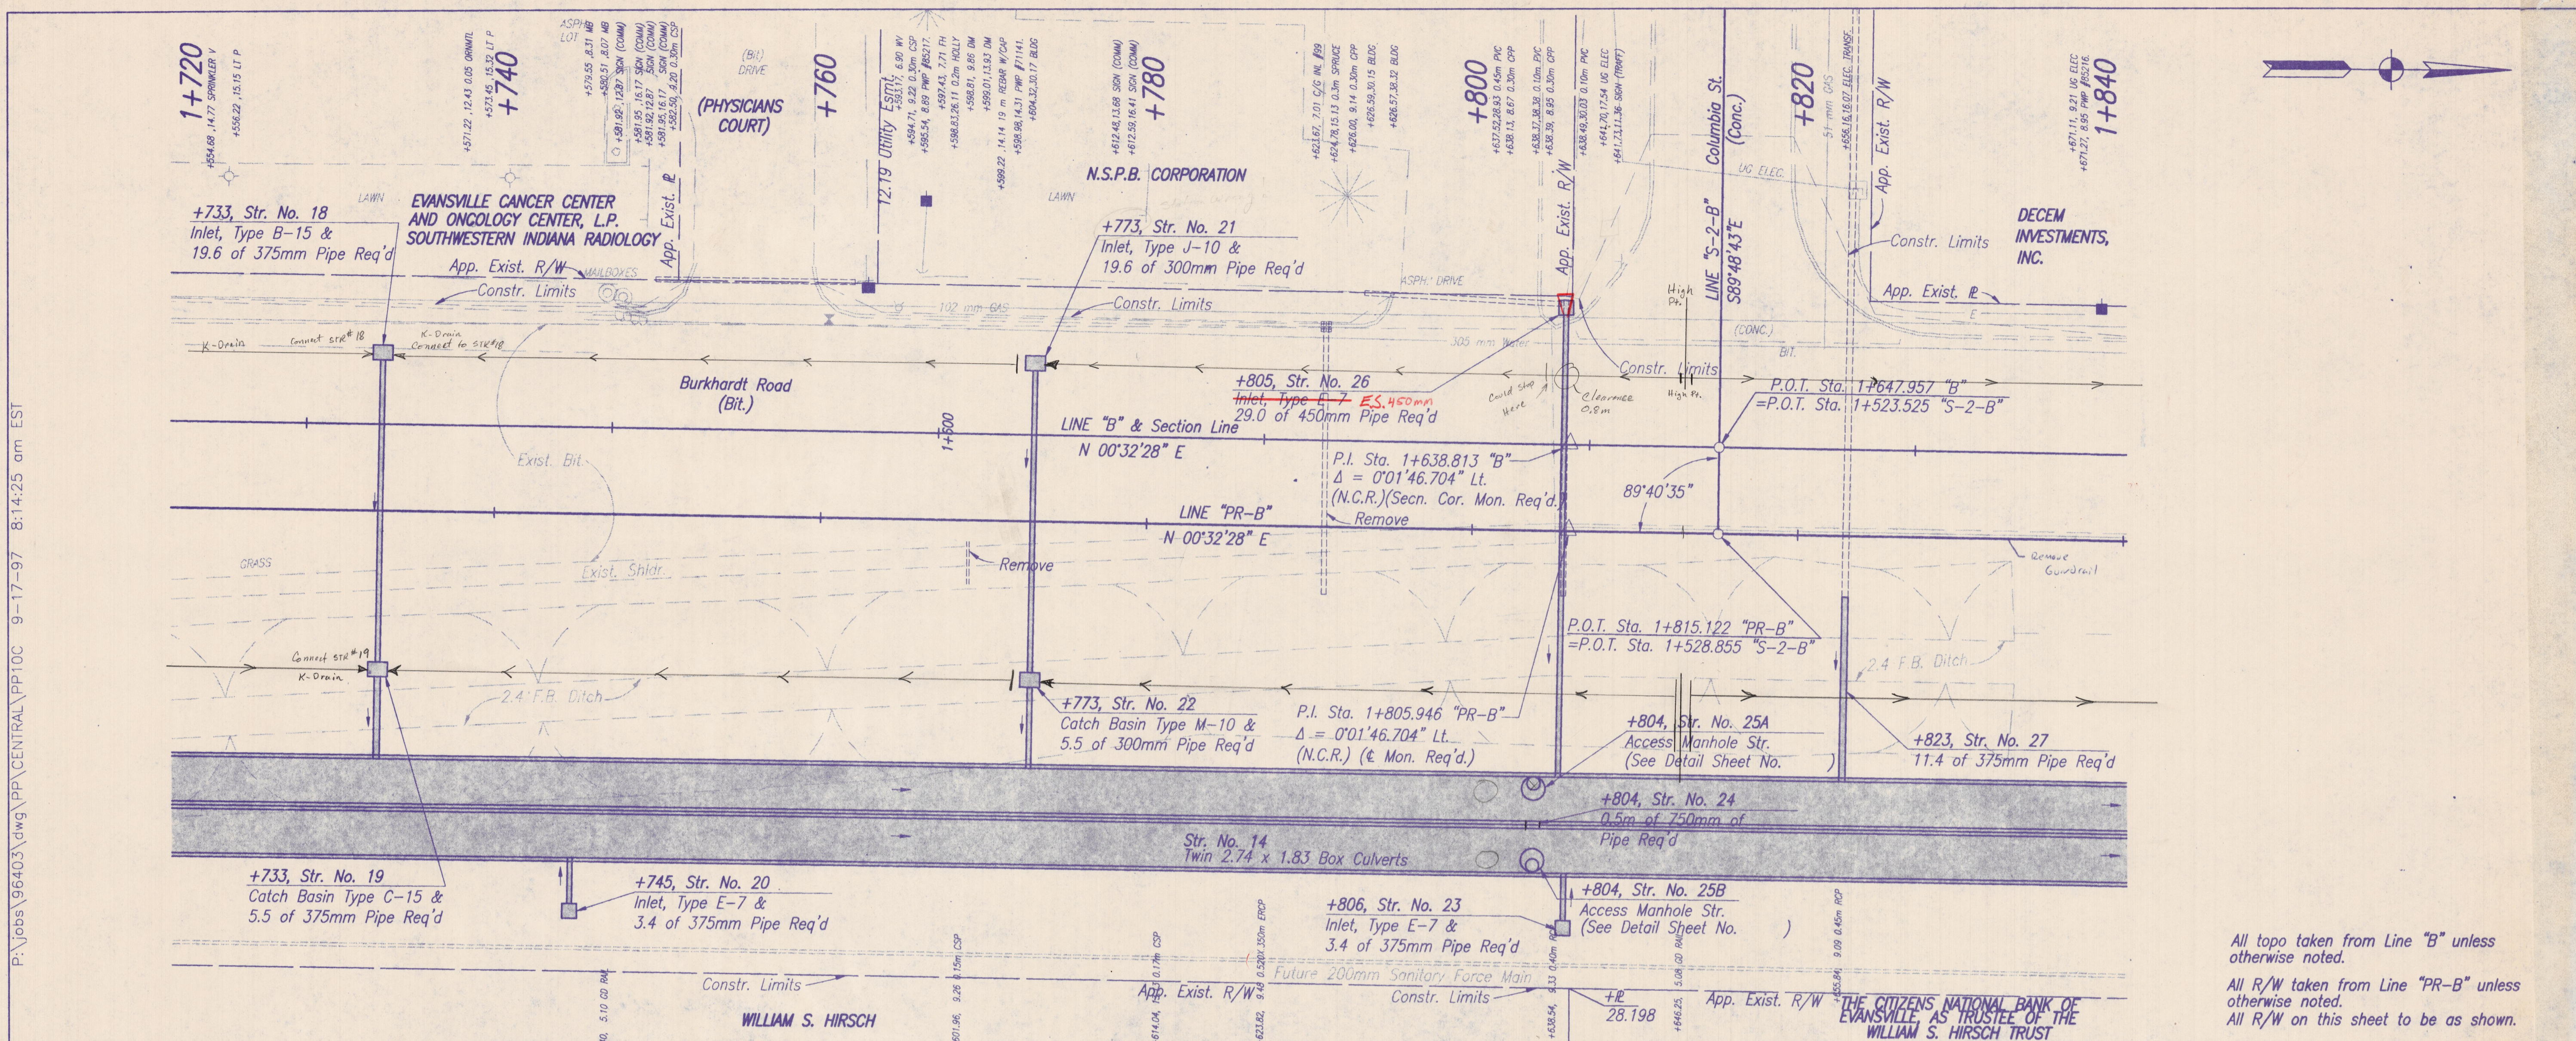
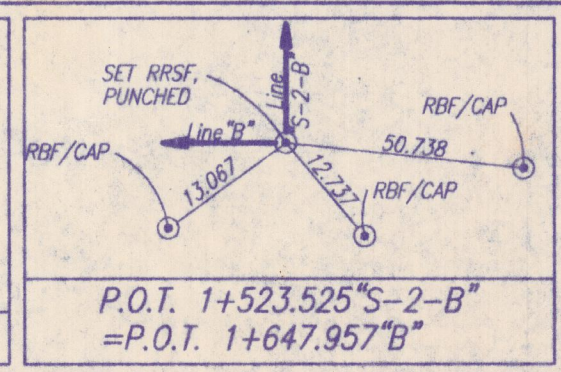


P:\jobs\96403\dwg\PP\CENTRAL\PP10C 9-17-97 8:14:25 am EST

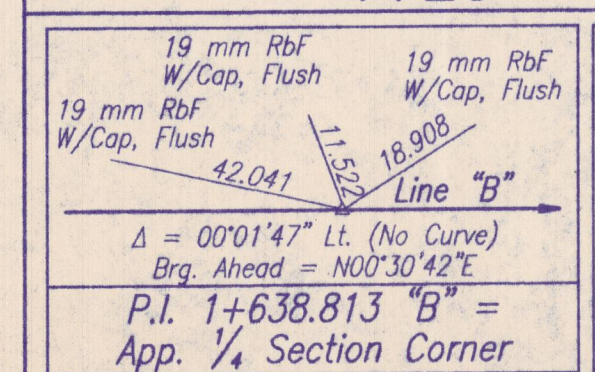

All topo taken from Line "B" unless otherwise noted.  
 All R/W taken from Line "PR-B" unless otherwise noted.  
 All R/W on this sheet to be as shown.

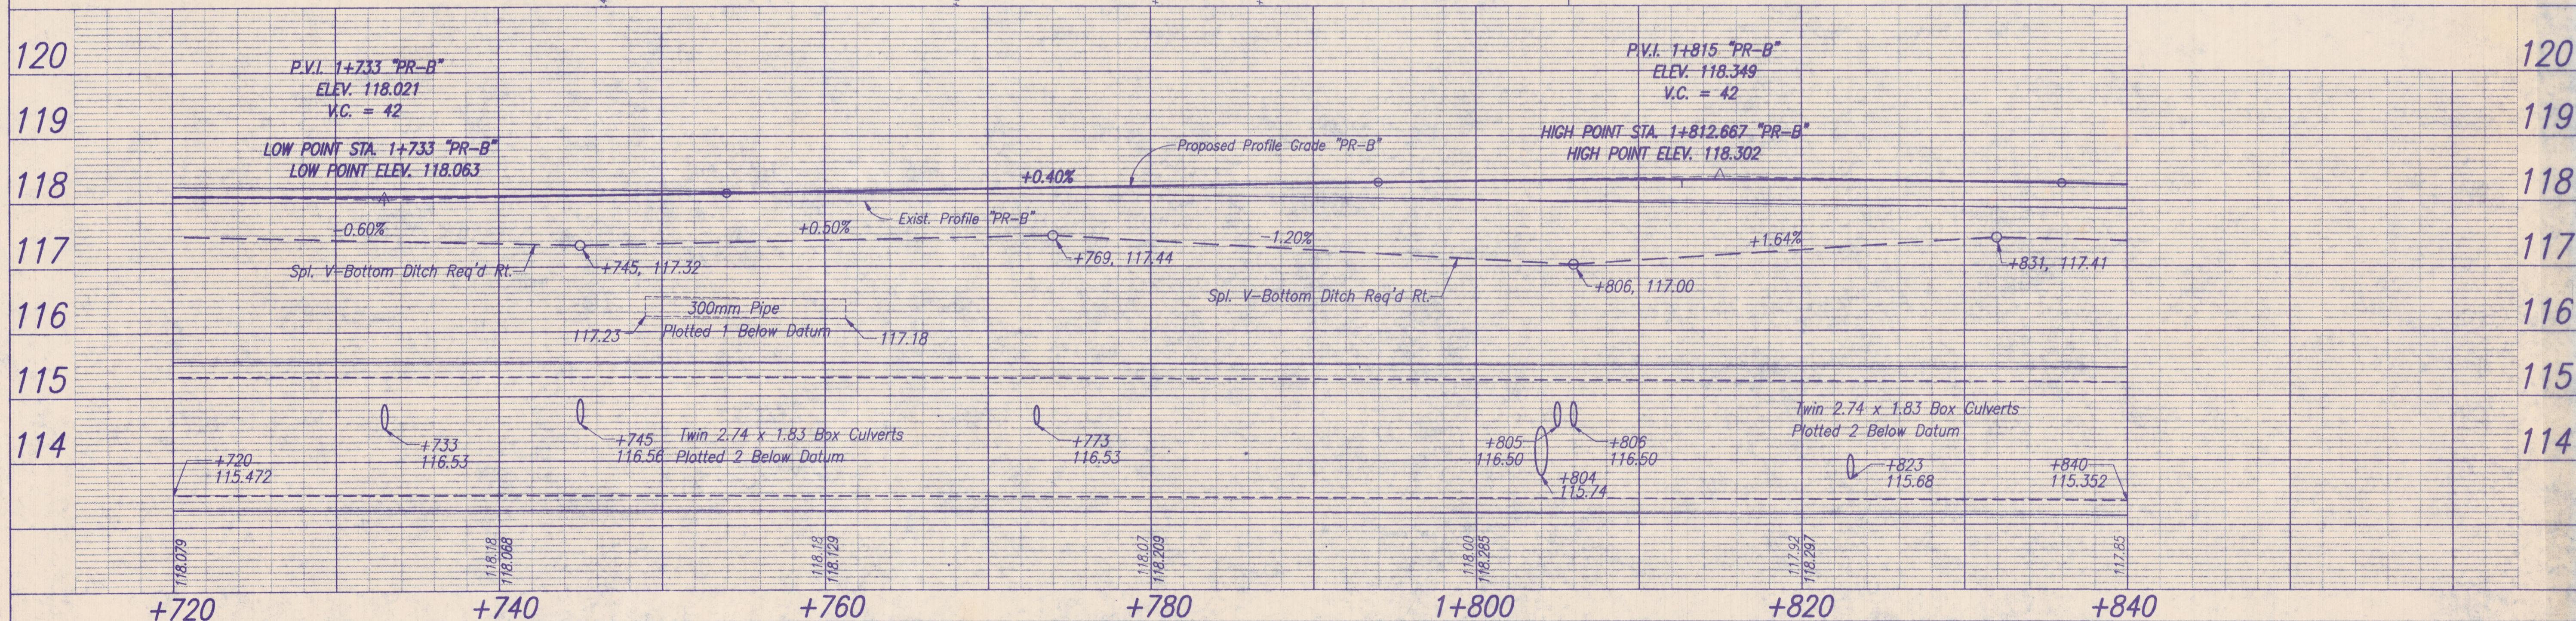

RECOMMENDED FOR APPROVAL: *Kent D. Downey* 9/19/97  
 DESIGN ENGINEER DATE  
 DESIGNED: ATM, DAV DRAWN: ATM, DAV, JRF  
 CHECKED: GLR CHECKED: GLR

INDIANA DEPARTMENT OF TRANSPORTATION  
**PLAN & PROFILE**  
**BURKHARDT ROAD**

HORIZONTAL SCALE 1:200	BRIDGE FILE
VERTICAL SCALE 1:50	DESIGNATION
SURVEY BOOK	SHEETS 6 of 90
CONTRACT	PROJECT VC97-09-01