



P:\jobs\96403\dwg\PP\CENTRAL\PP12C 9-15-97 8:40:55 am EST

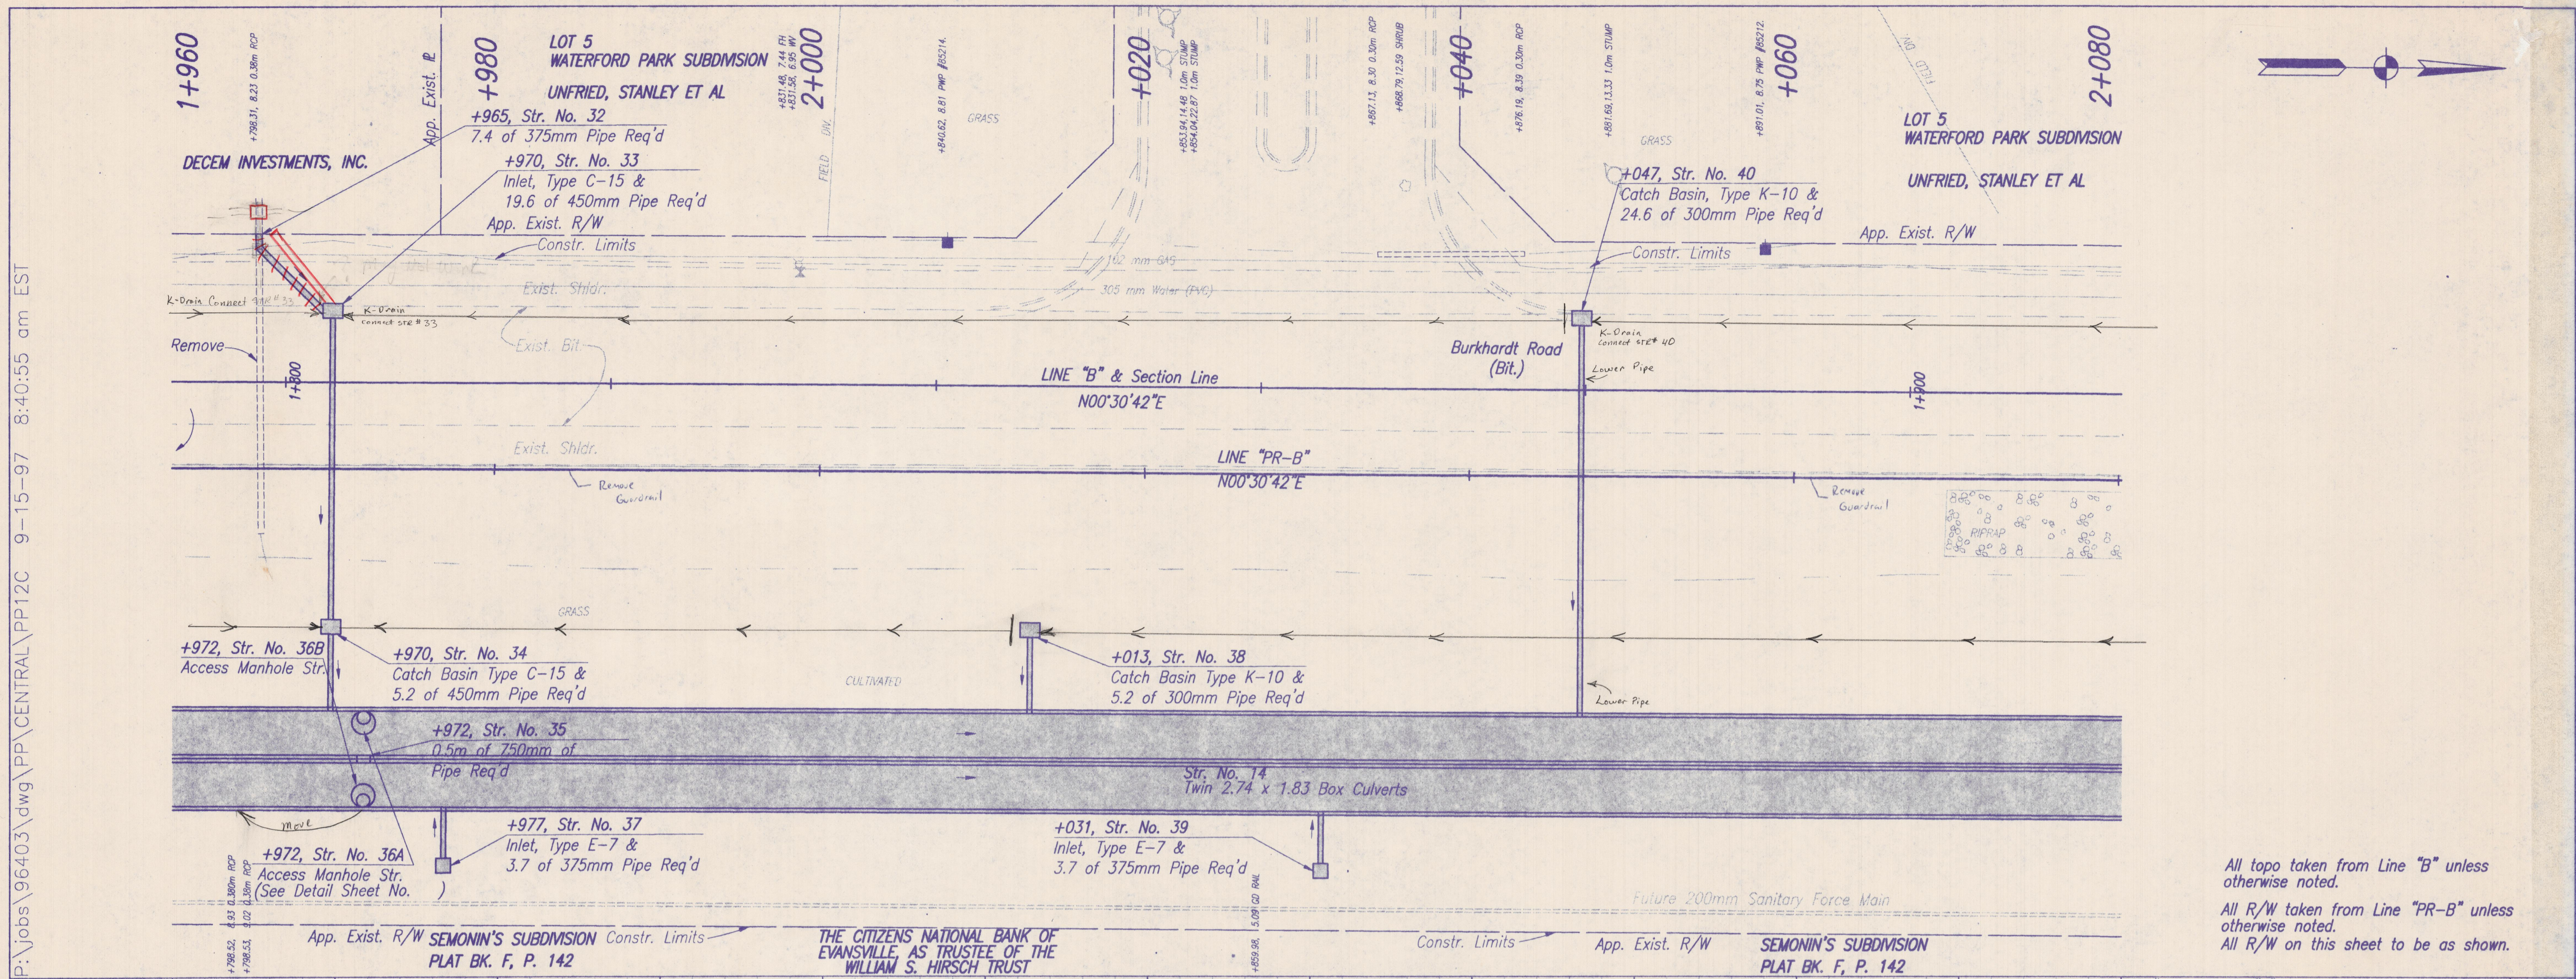

All topo taken from Line "B" unless otherwise noted.
 All R/W taken from Line "PR-B" unless otherwise noted.
 All R/W on this sheet to be as shown.

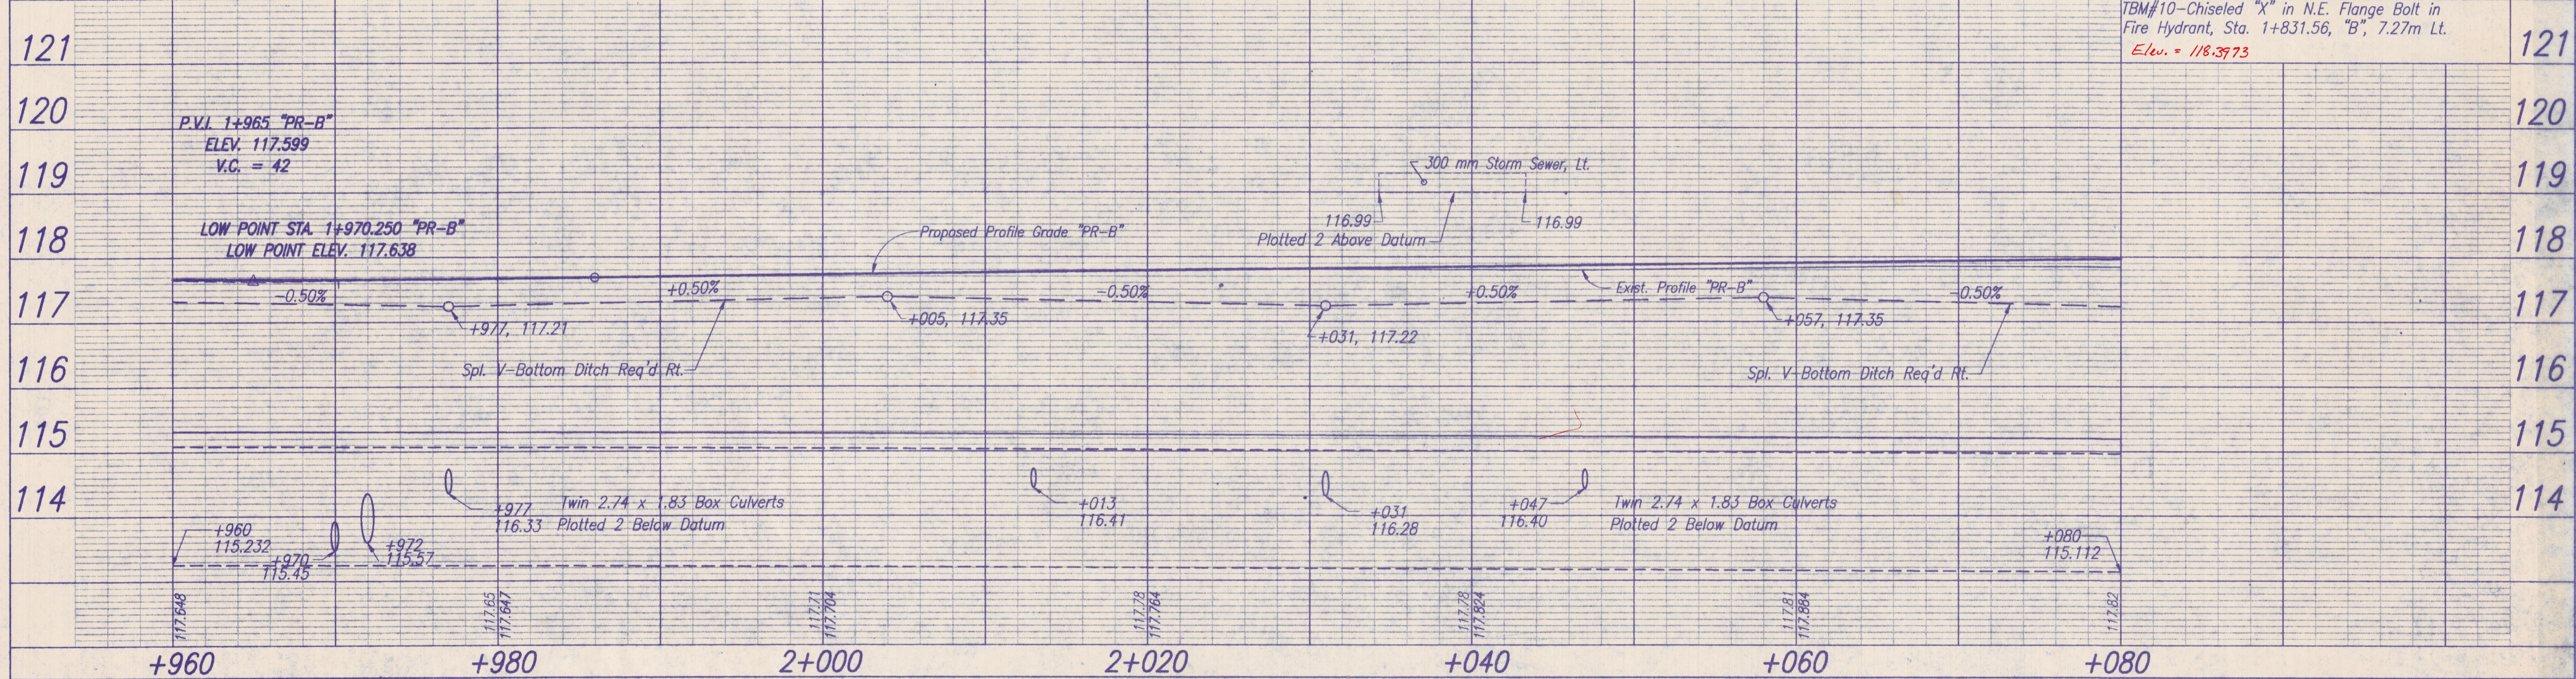

		RECOMMENDED FOR APPROVAL DESIGN ENGINEER DATE 9/19/97		INDIANA DEPARTMENT OF TRANSPORTATION		HORIZONTAL SCALE 1:200 VERTICAL SCALE 1:50	
DESIGNED: ATW, DAV CHECKED: GLR		DRAWN: ATW, DAV, JRF CHECKED: GLR		PLAN & PROFILE BURKHARDT ROAD		SURVEY BOOK SHEETS 3 of 90 CONTRACT PROJECT VC97-09-01	