



P:\Jobs\96403\dwg\PP\CENTRAL\PP13C 8-26-97 12:25:06 pm EST

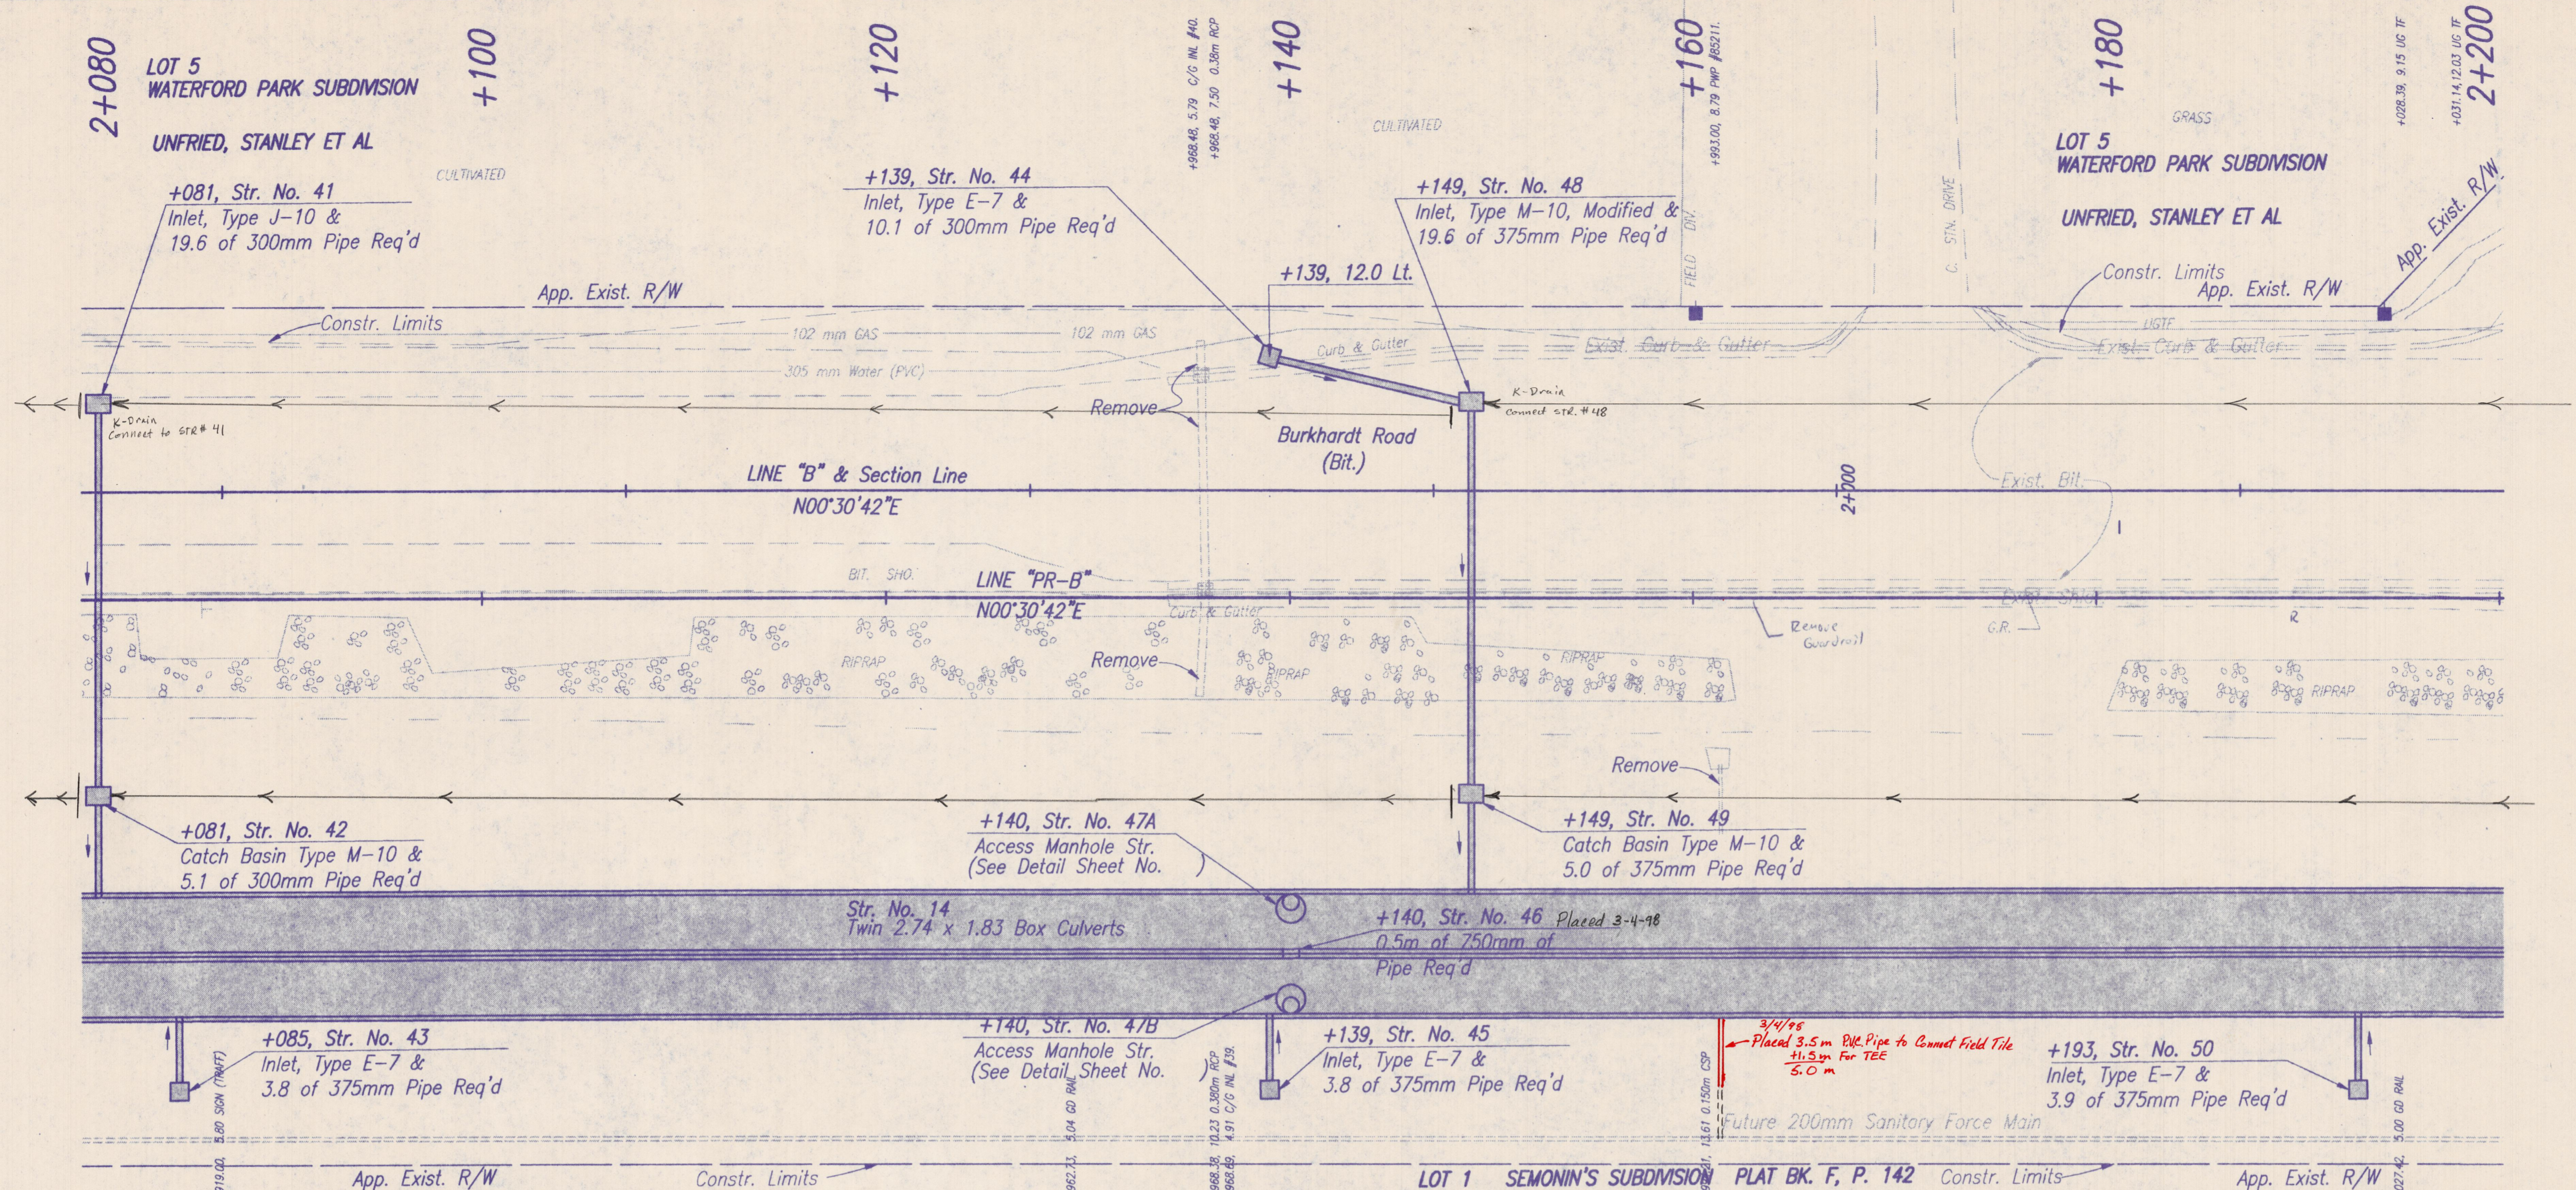

All topo taken from Line "B" unless otherwise noted.
 All R/W taken from Line "PR-B" unless otherwise noted.
 All R/W on this sheet to be as shown.

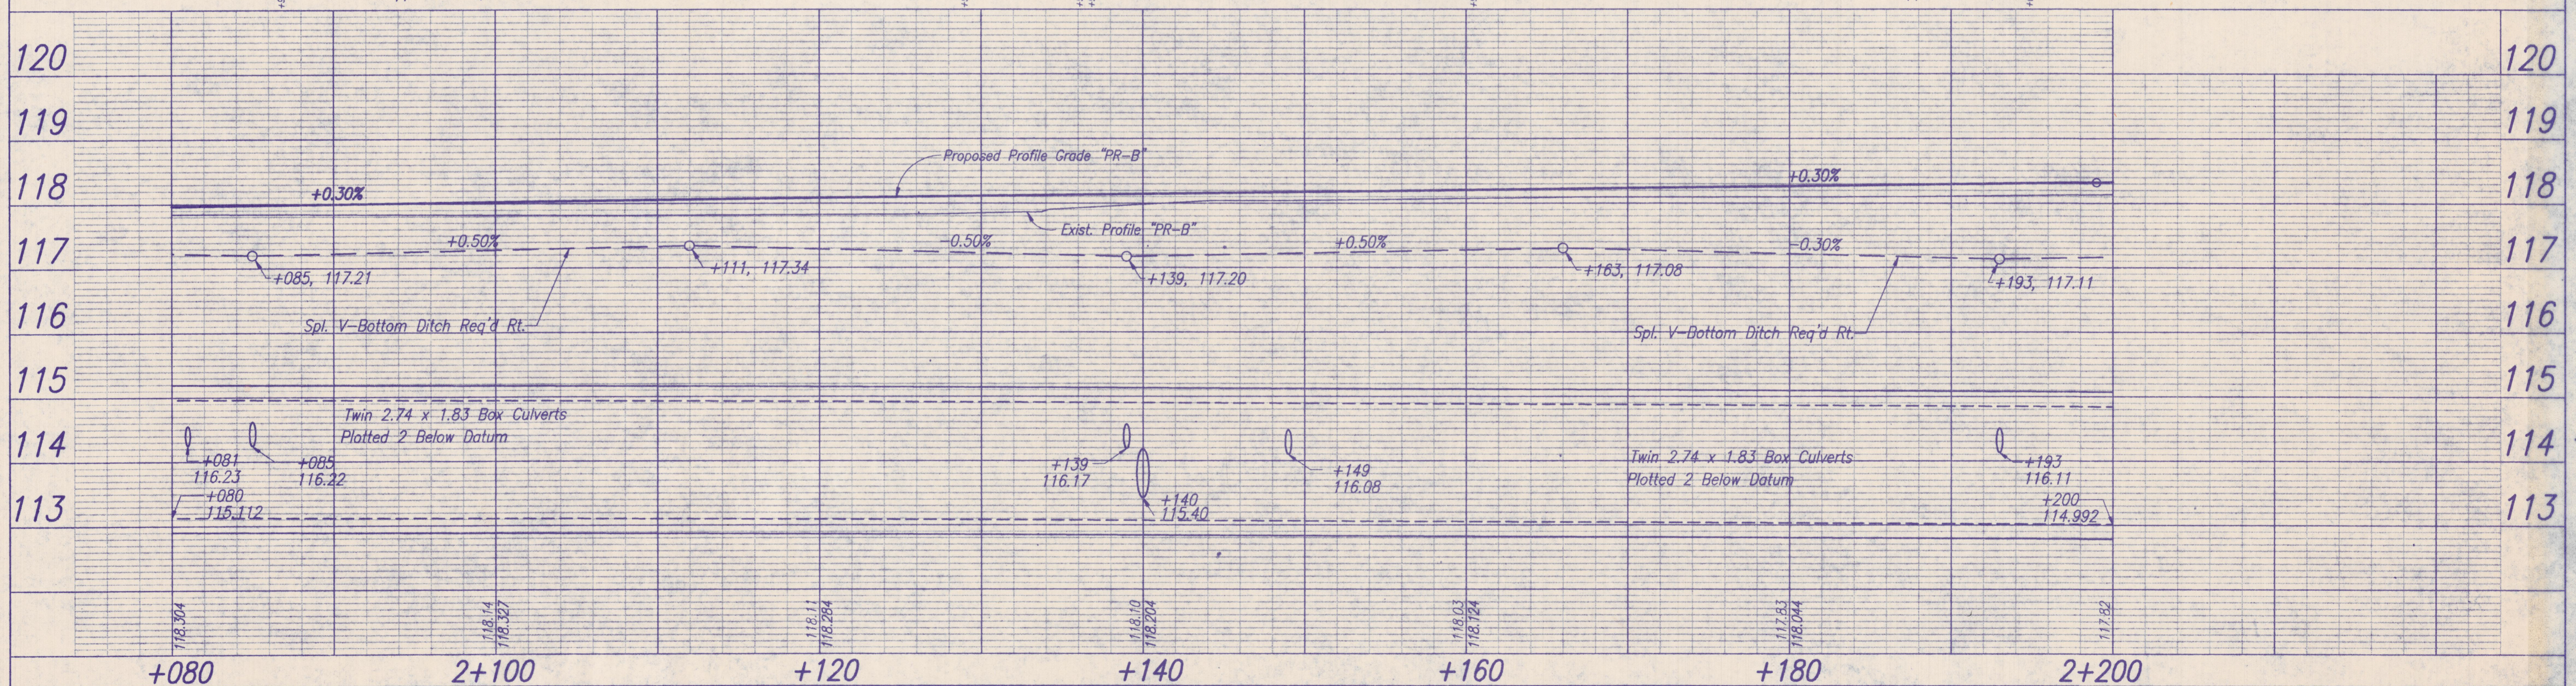

+080	2+100	+120	+140	+160	+180	2+200	
				RECOMMENDED FOR APPROVAL: <i>Kent Dwayne Downey</i> 9/19/97 DESIGN ENGINEER DATE		INDIANA DEPARTMENT OF TRANSPORTATION	
DESIGNED: ATW, DAV		DRAWN: ATW, DAV, JRF		PLAN & PROFILE BURKHARDT ROAD		HORIZONTAL SCALE: 1:200 BRIDGE FILE VERTICAL SCALE: 1:50 DESIGNATION SURVEY BOOK: _____ SHEETS: 9 of 90 CONTRACT: _____ PROJECT: VC97-09-01	
CHECKED: GLR		CHECKED: GLR					