

SEIB RD.

STATE RD #1


CAMDEN FARMS

Tax Code: 2-117-5
Clem A. Frank
5000 Heckel Road
Evansville, IN. 47711
(DR 3, CD 9463)

Tax Code: 2-127-26
For Haven Christ Fellowship, Inc.
R. R. 3
Owensville, IN. 47665

Tax Code: 02-124-17
City of Evansville
c/o Sunbeam Plastics Corp.
3245 Kansas Rd.
Evansville, IN. 47711

Tax Code: 2-127-22
Russen & Delores M. Seiler
2530 Knob Hill Dr.
Evansville, IN. 47711

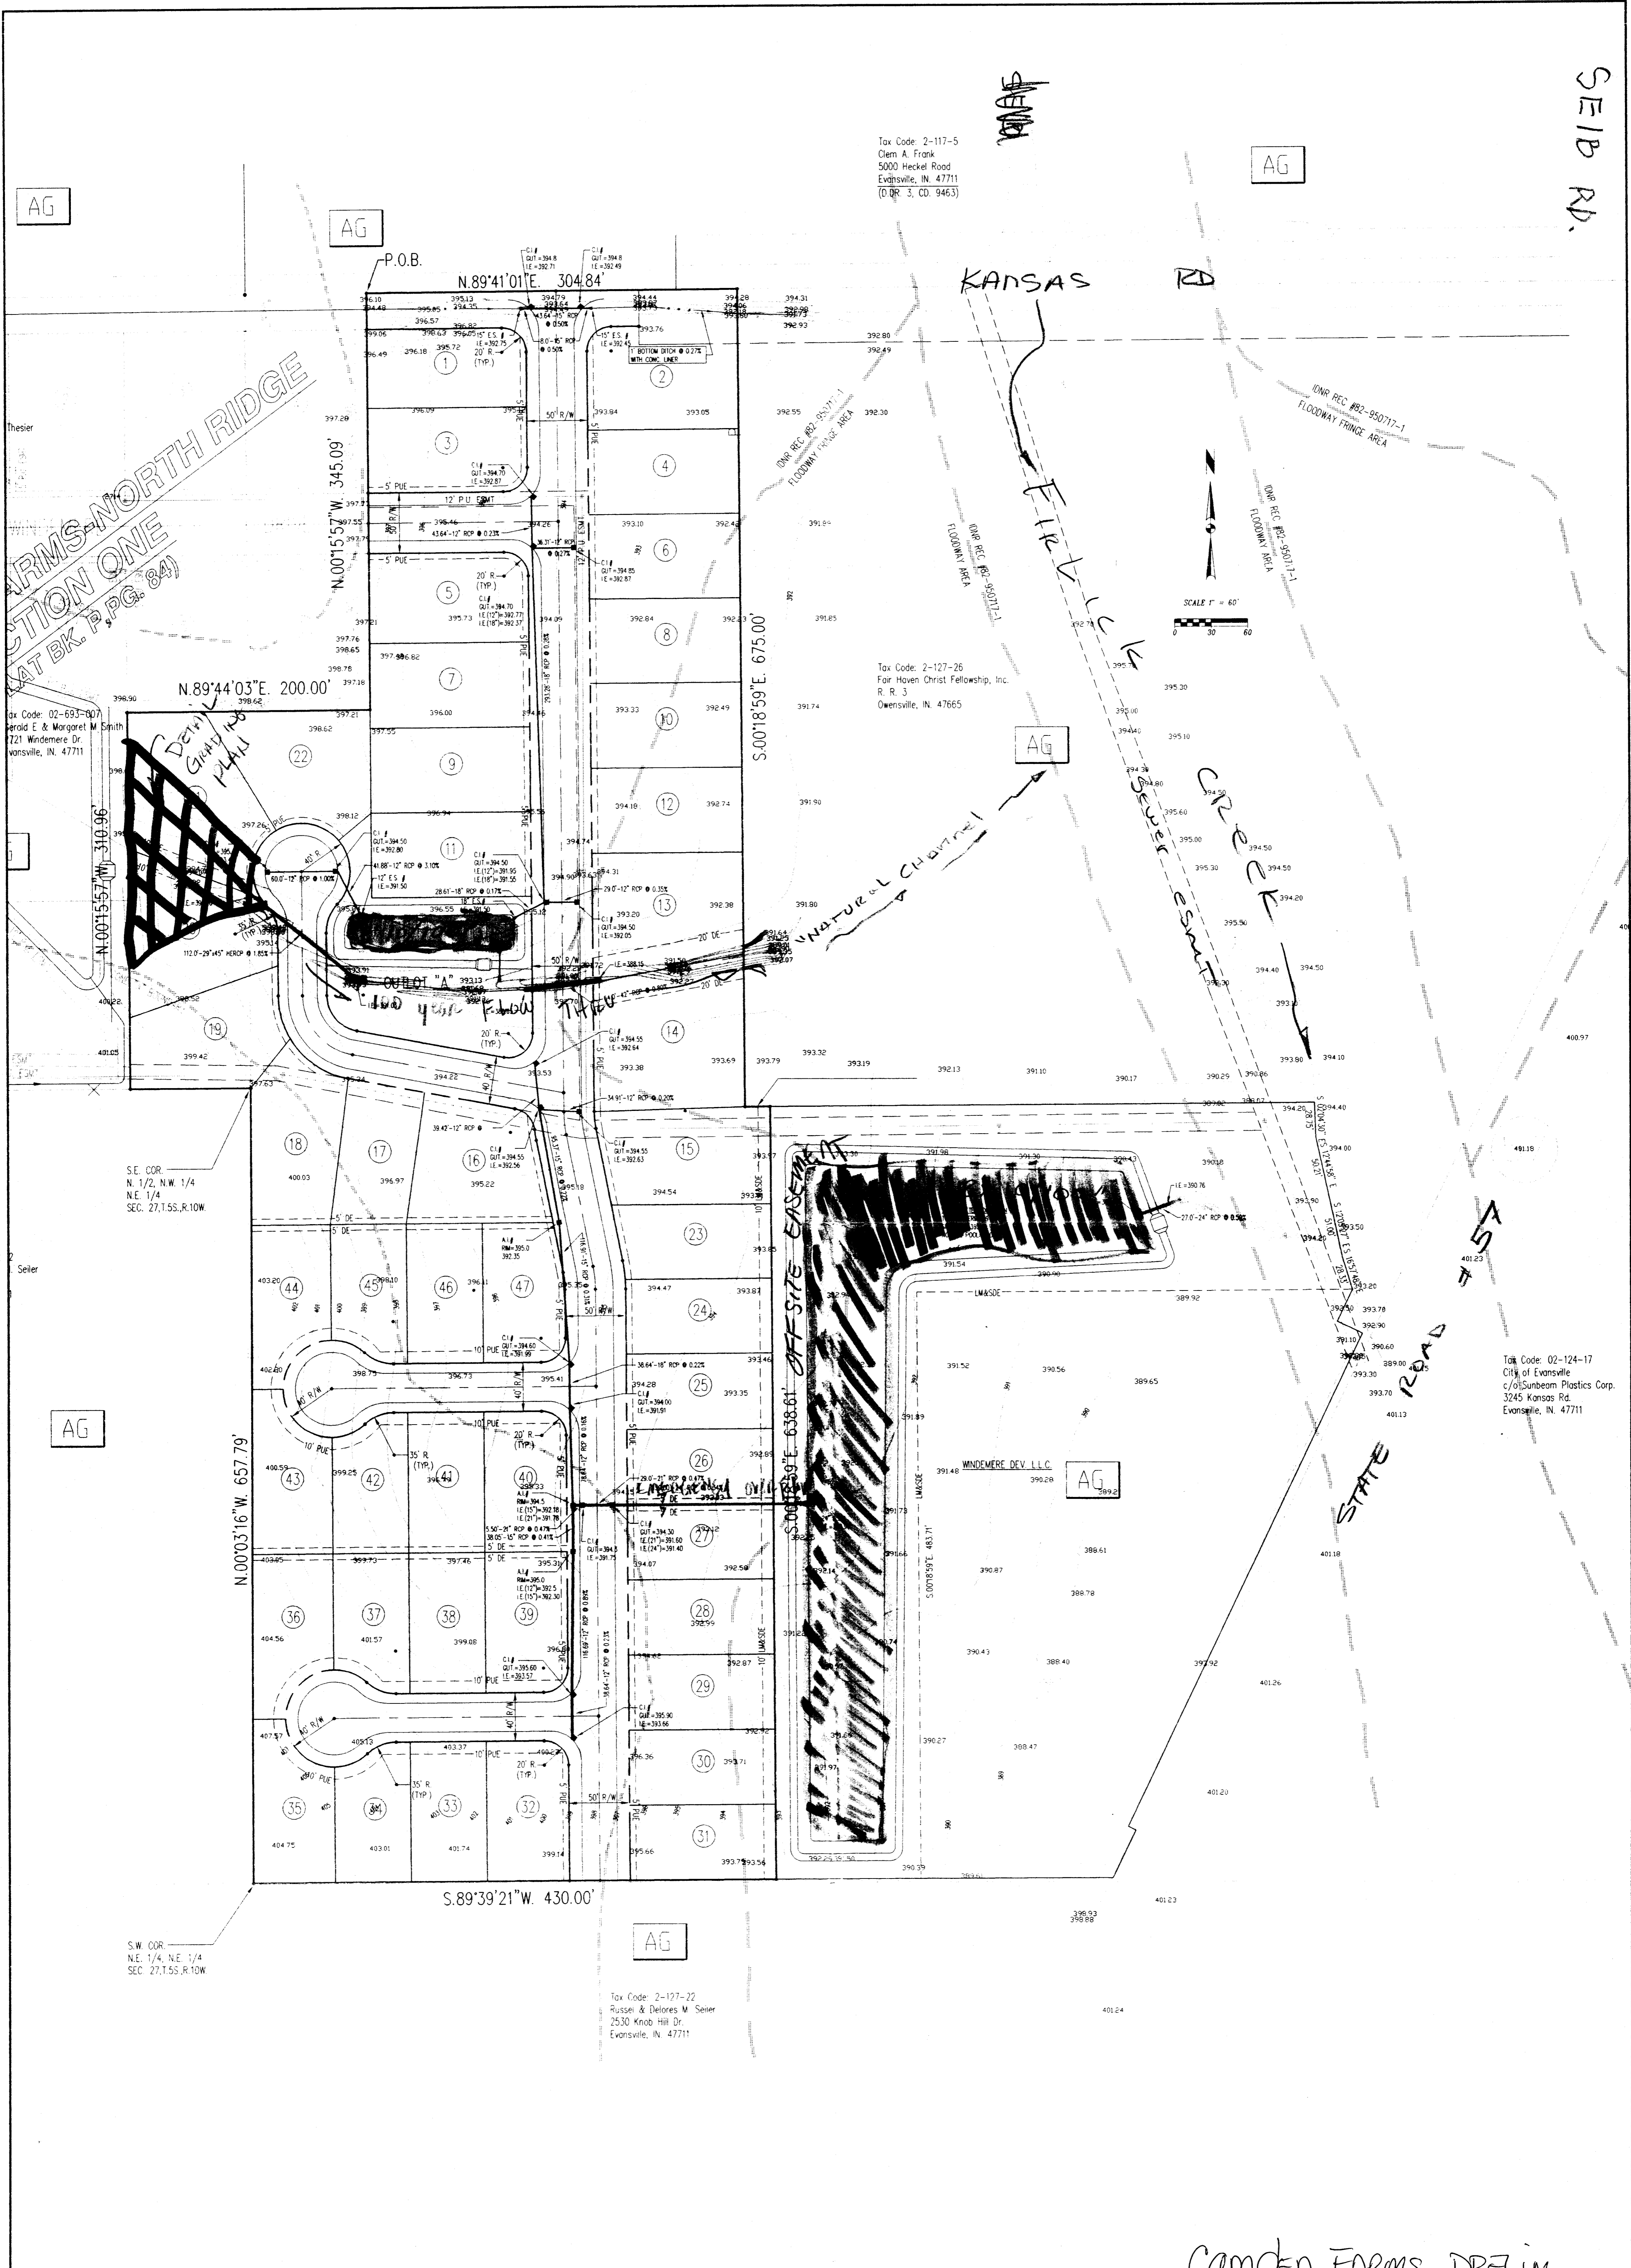


ARMS-NORTH RIDGE
SECTION ONE
AT BK. P.G. 84

Ex Code: 02-593-007
David E. & Margaret M. Smith
721 Windemere Dr.
Evansville, IN. 47711

S.E. COR.
N. 1/2, N.W. 1/4
N.E. 1/4
SEC. 27.1.55, R.10W.

S.W. COR.
N.E. 1/4, N.E. 1/4
SEC. 27.1.55, R.10W.

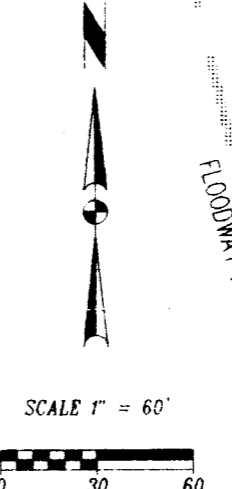

CAMDEN FARMS DRAINAGE PLAN

Scale 1" = 60' Drawn By: KAP Date: 1-28-10 Checked By: RRB Date: 8-19-08 Sheet Number: DR-1	Revisions <table border="1"> <thead> <tr> <th>No.</th> <th>By</th> <th>Date</th> <th>Description</th> </tr> </thead> <tbody> <tr><td> </td><td> </td><td> </td><td> </td></tr> <tr><td> </td><td> </td><td> </td><td> </td></tr> <tr><td> </td><td> </td><td> </td><td> </td></tr> <tr><td> </td><td> </td><td> </td><td> </td></tr> <tr><td> </td><td> </td><td> </td><td> </td></tr> </tbody> </table>	No.	By	Date	Description																					Project: CAMDEN FARMS Sheet Title: PRELIMINARY DRAINAGE PLAN	SITECON, Inc. Engineers-Surveyors 600 S.E. Eighth Street Suite 2 Evansville, Indiana 47713 (812) 423-2320	Written dimensions on these drawings shall have precedence over scale dimensions. Contractors shall verify and be responsible for all dimensions and conditions on the job and SITECON, Inc., must be notified of any variations from the dimensions and conditions shown by these drawings.
	No.	By	Date	Description																								