Cayman Ridge Lot 149

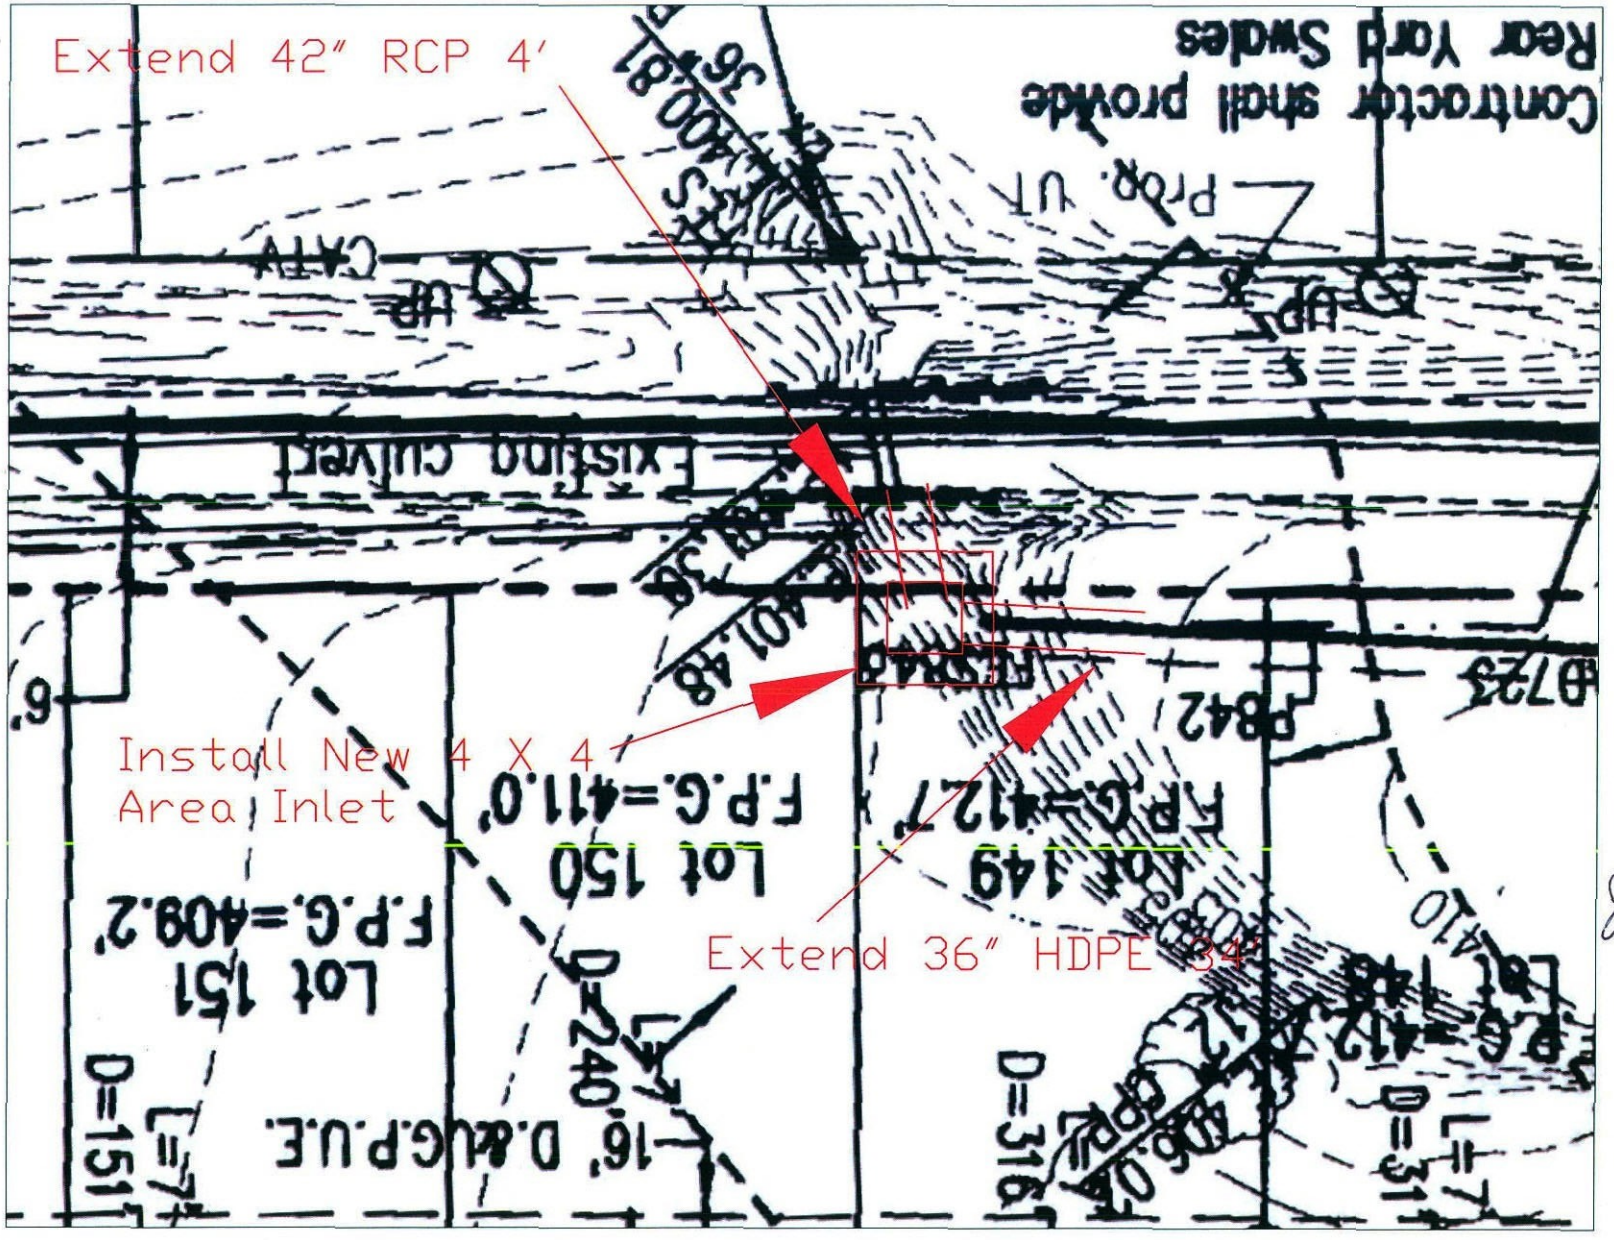

OK
John Stoll
4/14/11

Regrade Area To New Inlet