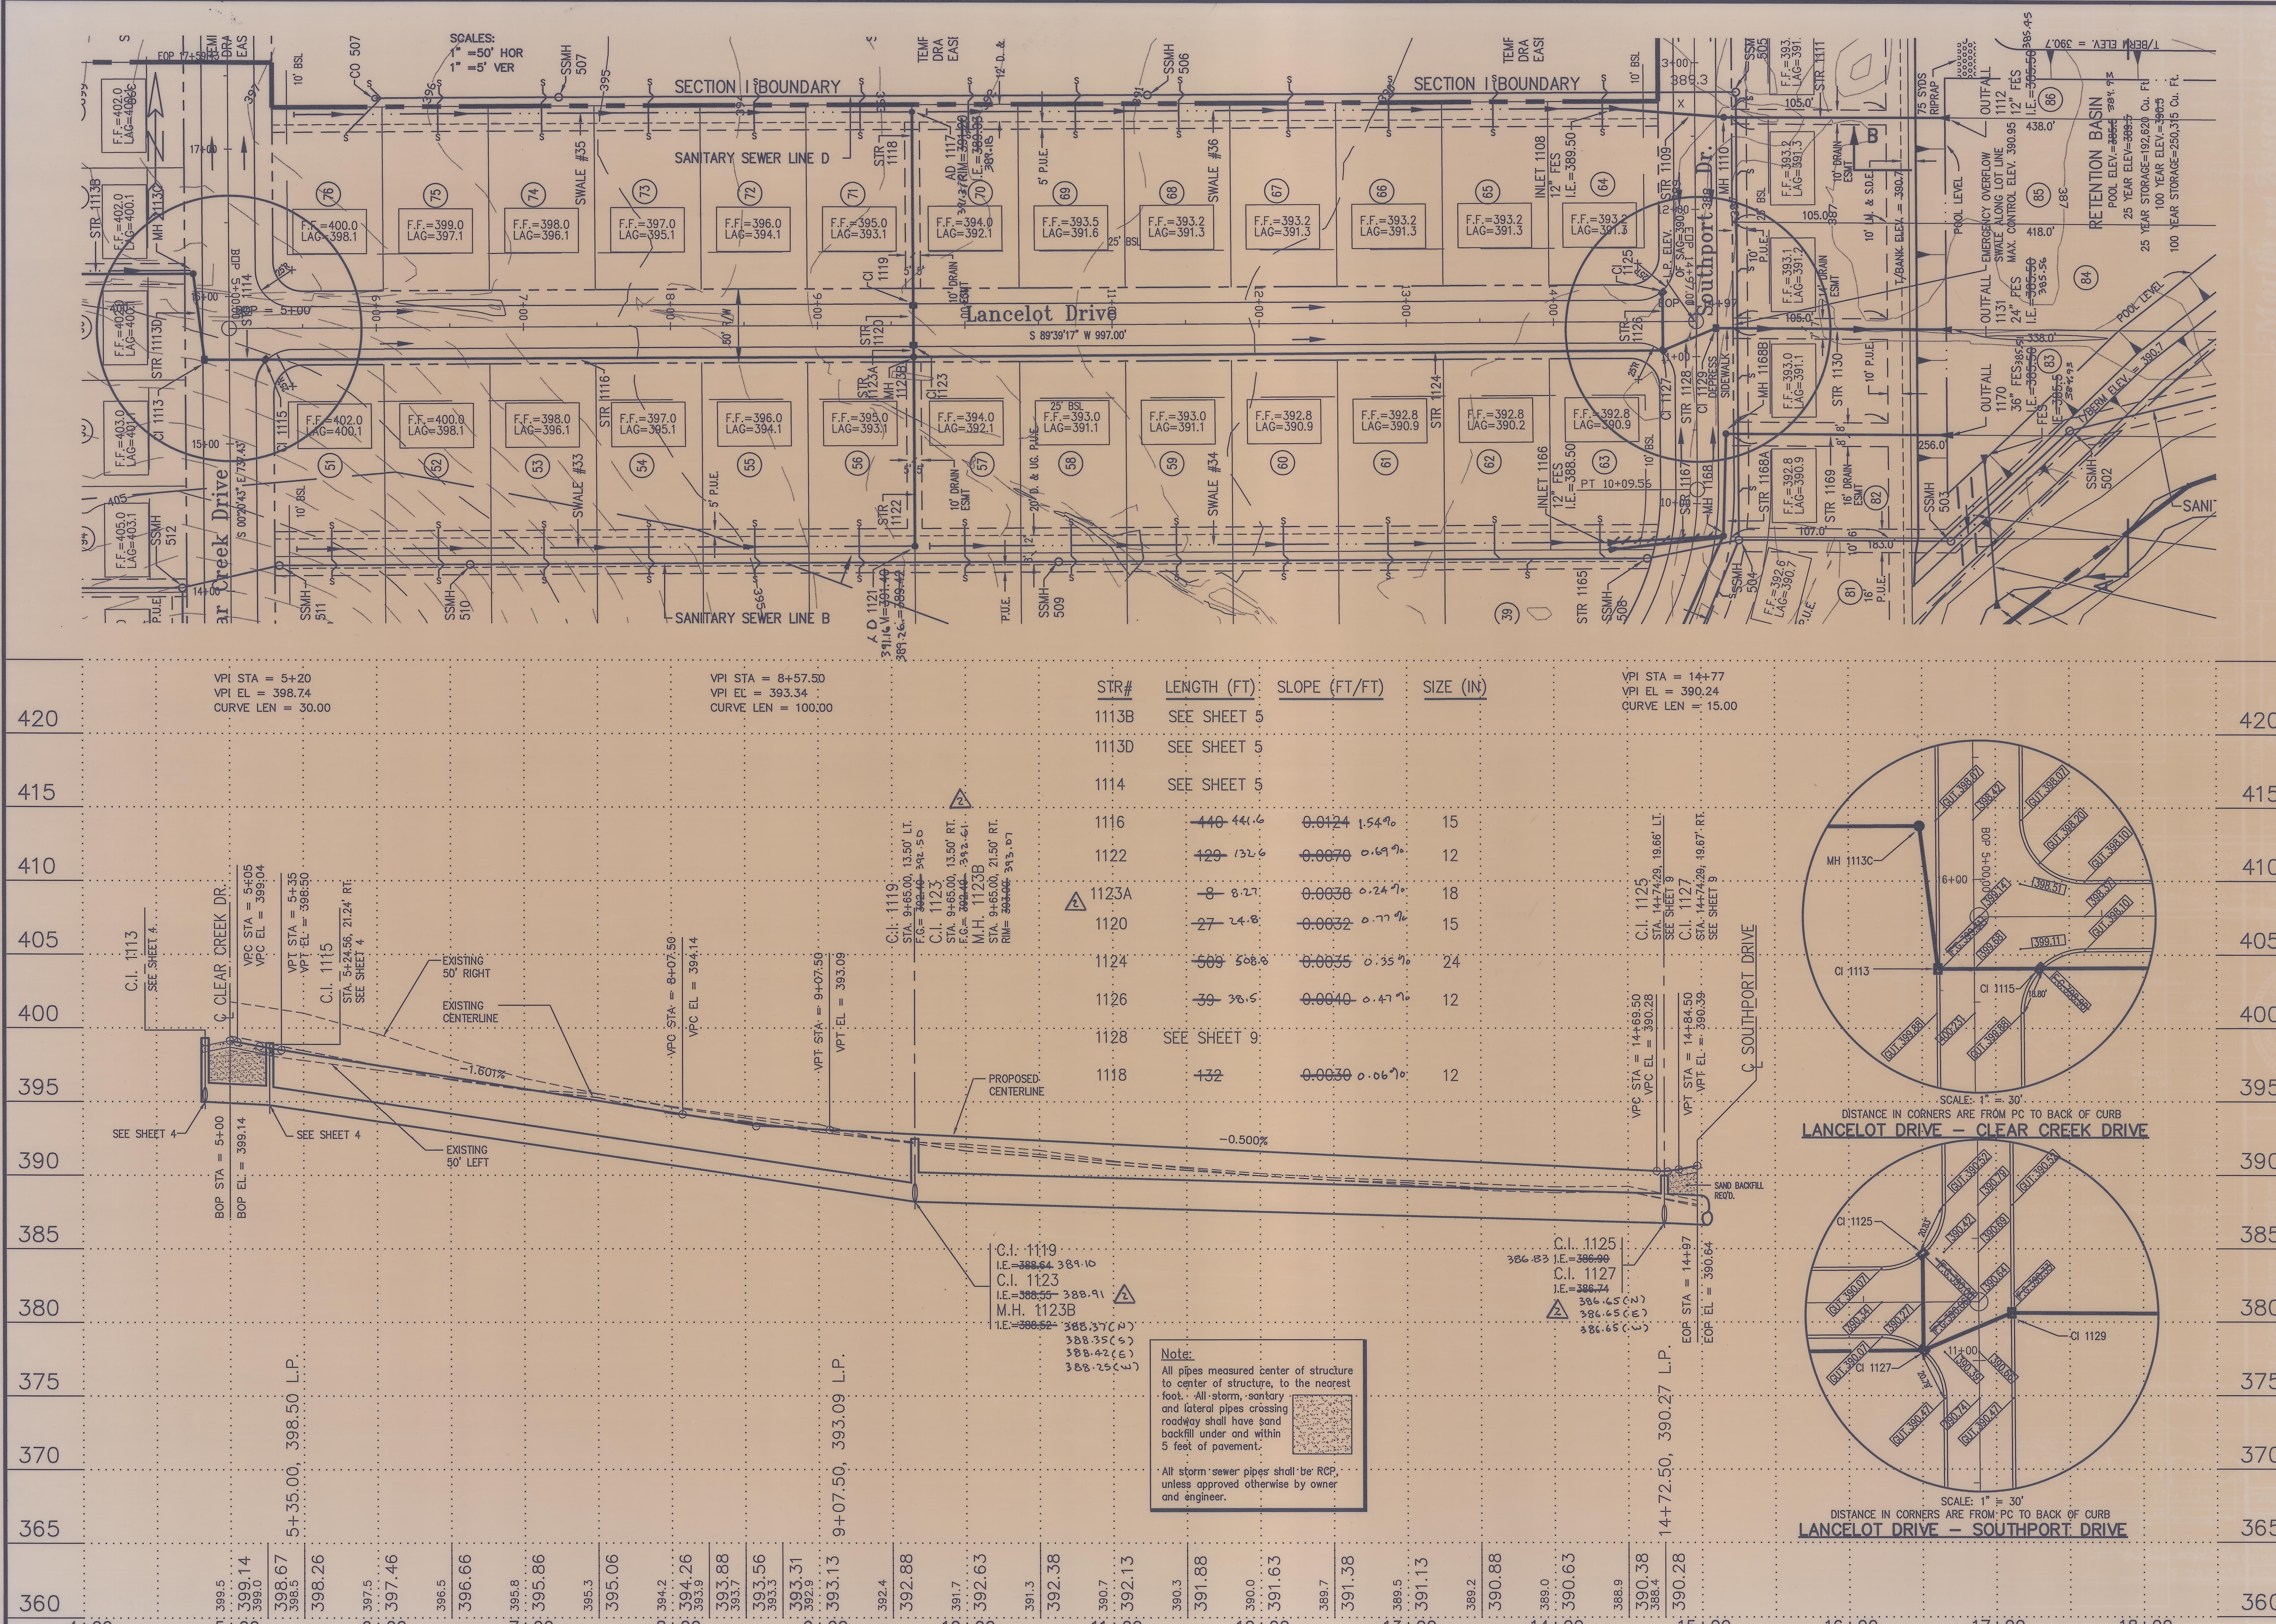

STR#	LENGTH (FT)	SLOPE (FT/FT)	SIZE (IN)
1113B	SEE SHEET 5		
1113D	SEE SHEET 5		
1114	SEE SHEET 5		
1116	~~440~~ 441.6	~~0.0124~~ 1.54%	15
1122	~~129~~ 132.6	~~0.0070~~ 0.69%	12
1123A	~~8~~ 8.27	~~0.0038~~ 0.24%	18
1120	~~27~~ 24.8	~~0.0032~~ 0.77%	15
1124	~~509~~ 508.8	~~0.0035~~ 0.35%	24
1126	~~39~~ 38.5	~~0.0040~~ 0.47%	12
1128	SEE SHEET 9		
1118	~~132~~	~~0.0030~~ 0.06%	12

Note:
All pipes measured center of structure to center of structure, to the nearest foot. All storm, santary and lateral pipes crossing roadway shall have sand backfill under and within 5 feet of pavement.

All storm sewer pipes shall be RCP, unless approved otherwise by owner and engineer.

Morley and Associates, INC.
Consulting Engineers/Surveyors/Architects
605 S.E. Martin Luther King Jr. Blvd.
Evansville, Indiana 47713
(812) 464-9585

All ideas, designs, calculations, and arrangements indicated or represented by this drawing are owned by and the property of Morley and Associates, Inc. and were created for the use on and in connection with the specified project. None of such ideas, designs, calculations, or arrangements shall be used by or disclosed to any person, firm, or corporation for any purpose whatsoever without the written permission of Morley and Associates, Inc.

Written dimensions on these drawings shall have precedence over scale dimensions. Contractors shall verify and be responsible for all dimensions and conditions on the job and Morley and Associates, Inc. must be notified of any variations from the dimensions and conditions shown by these drawings.

Revisions

No.	By	Date	Description
1	J.E.M.	4/14/97	Revise road grades and sewer elevations.
2	JEM	5/29/98	STORM SEWER AS BUILTS

JAMES Q. MORLEY REGISTERED No. 13817 STATE OF INDIANA PROFESSIONAL ENGINEER
James Q. Morley

Project: Clear Creek Village – Section 1

Sheet Title: Lancelot Drive Plan and Profile

Hor. Scale: 1"=50'
Ver. Scale: 1"=5'

Designed By: J.E.M.	Job Number: 96-3309-1(A)(A2)
Drawn By: G.A.H.	Date: 09-27-96
Checked By:	Filename: RCP01004.DWG