




SCALE 1" = 50'

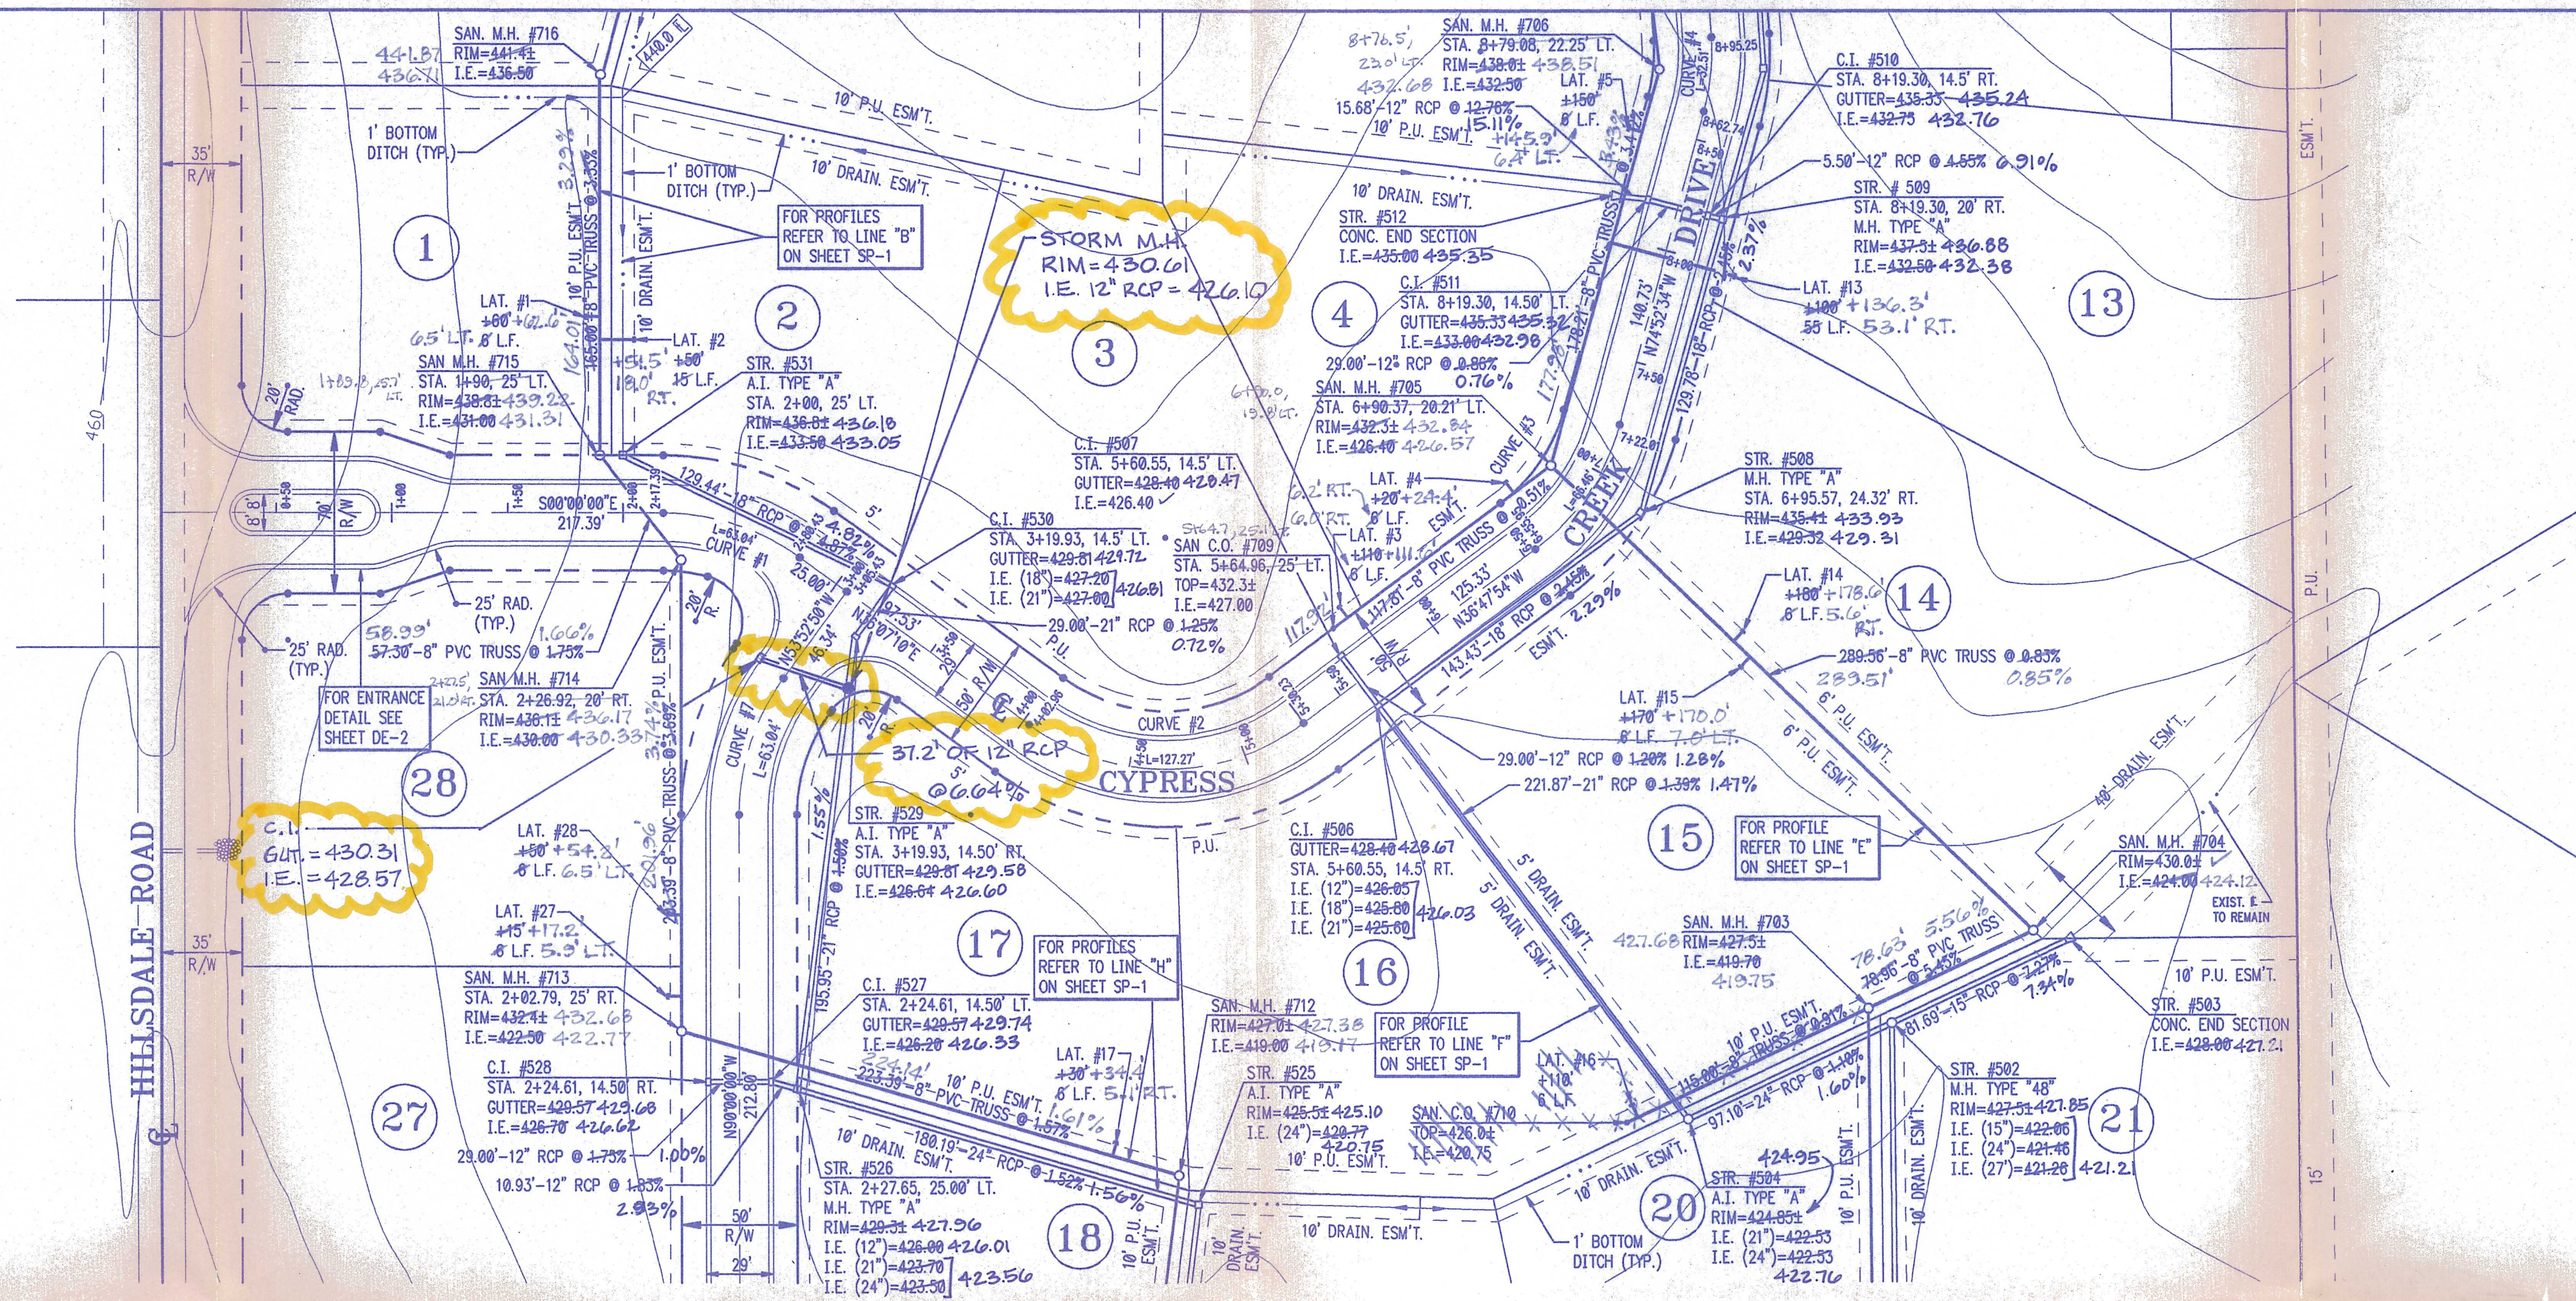

CURVE DATA

DESIGNATION	RADIUS	DELTA	LENGTH	CHORD
CURVE #1	100.00'	36°07'10"	63.04'	S18°03'35"W 62.00'
CURVE #2	100.00'	72°55'04"	127.27'	S00°20'22"E 118.85'
CURVE #3	100.00'	38°04'39"	66.46'	S55°50'14"E 65.24'
CURVE #4	100.00'	18°37'39"	32.51'	S84°11'23"W 32.37'
CURVE #7	100.00'	36°07'10"	63.04'	N71°56'25"W 62.00'


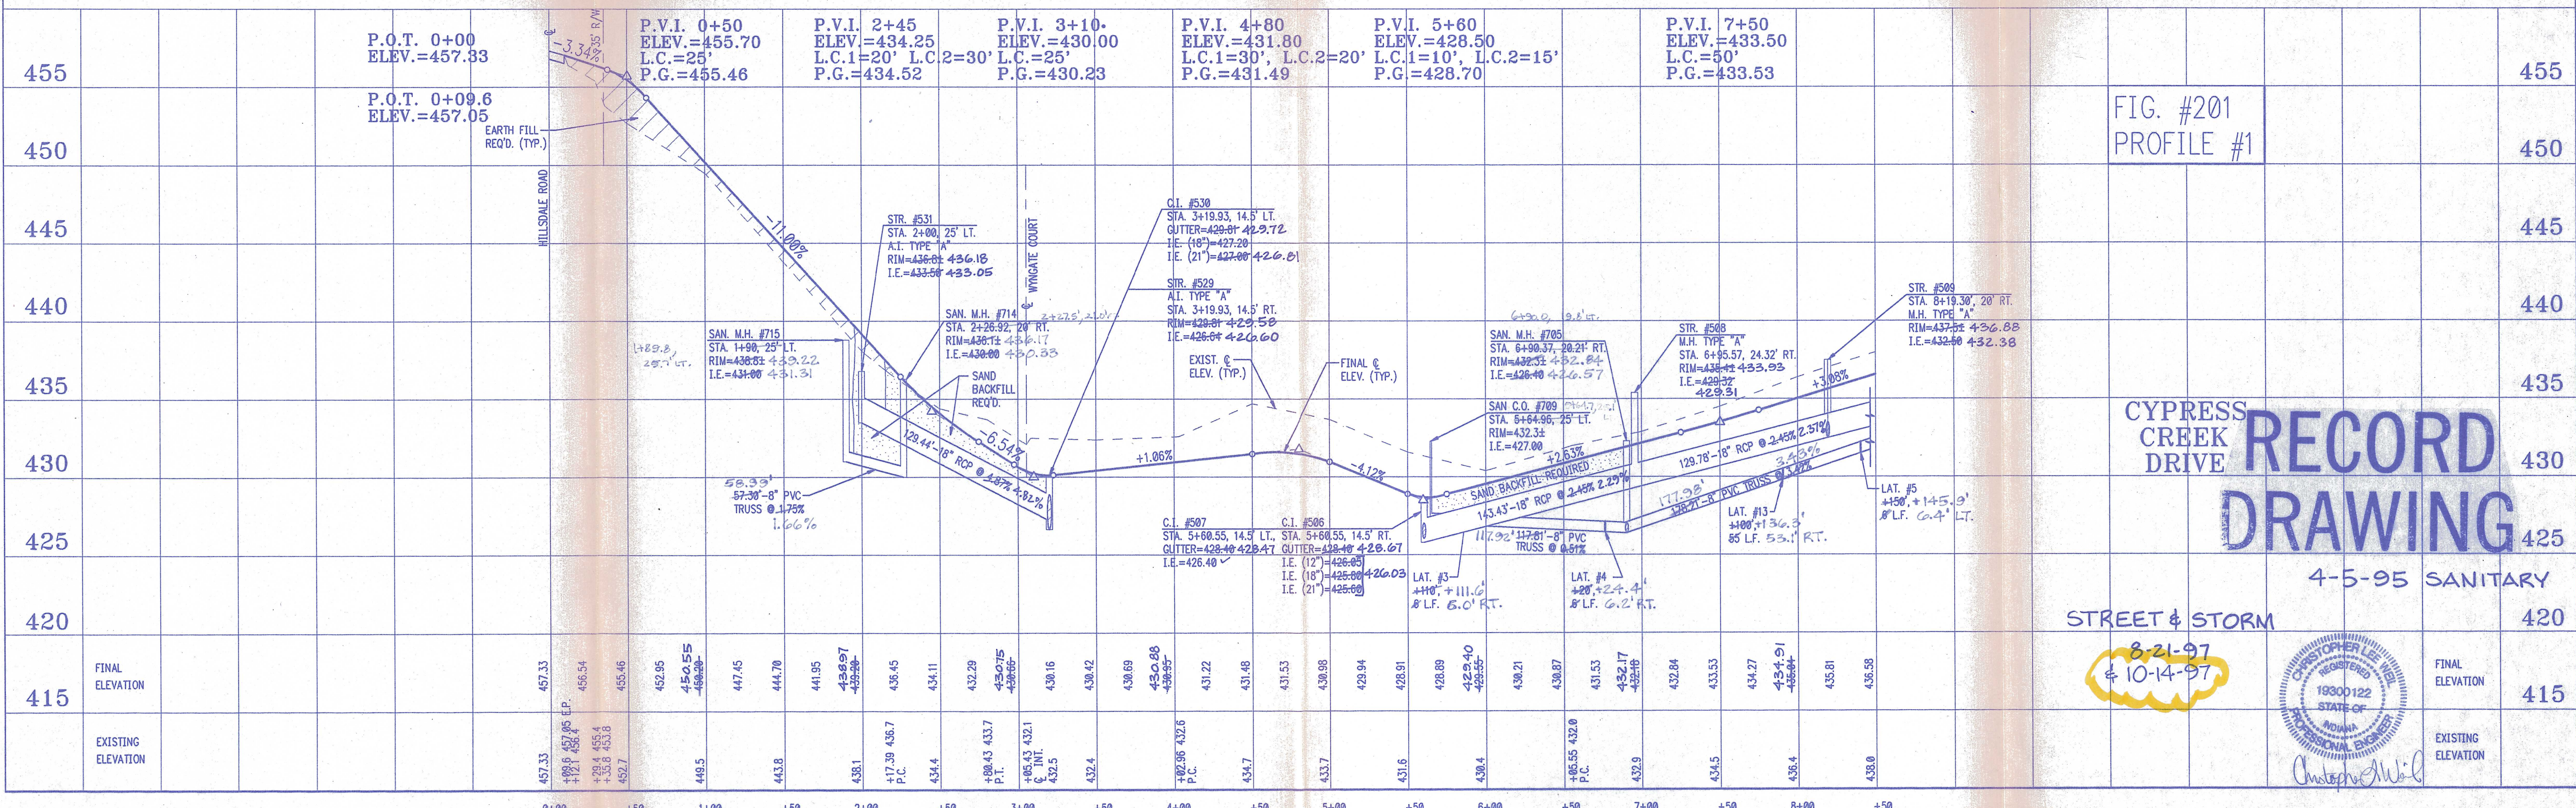


FIG. #201
PROFILE #1

**RECORD
DRAWING**

4-5-95 SANITARY
STREET & STORM

8-21-97
10-14-97

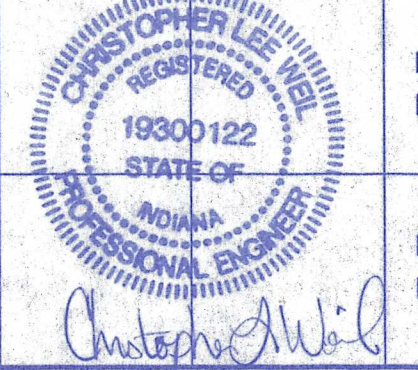

FINAL ELEVATION
EXISTING ELEVATION