

CURVE DATA

DESIGNATION	RADIUS	DELTA	LENGTH	CHORD
CURVE #4	100.00'	18°37'39"	32.51'	S84°11'23"W 32.37'
CURVE #5	75.00'	86°05'55"	112.70'	N43°02'57"E 102.39'
CURVE #6	100.00'	48°13'04"	84.16'	N24°06'32"E 81.89'

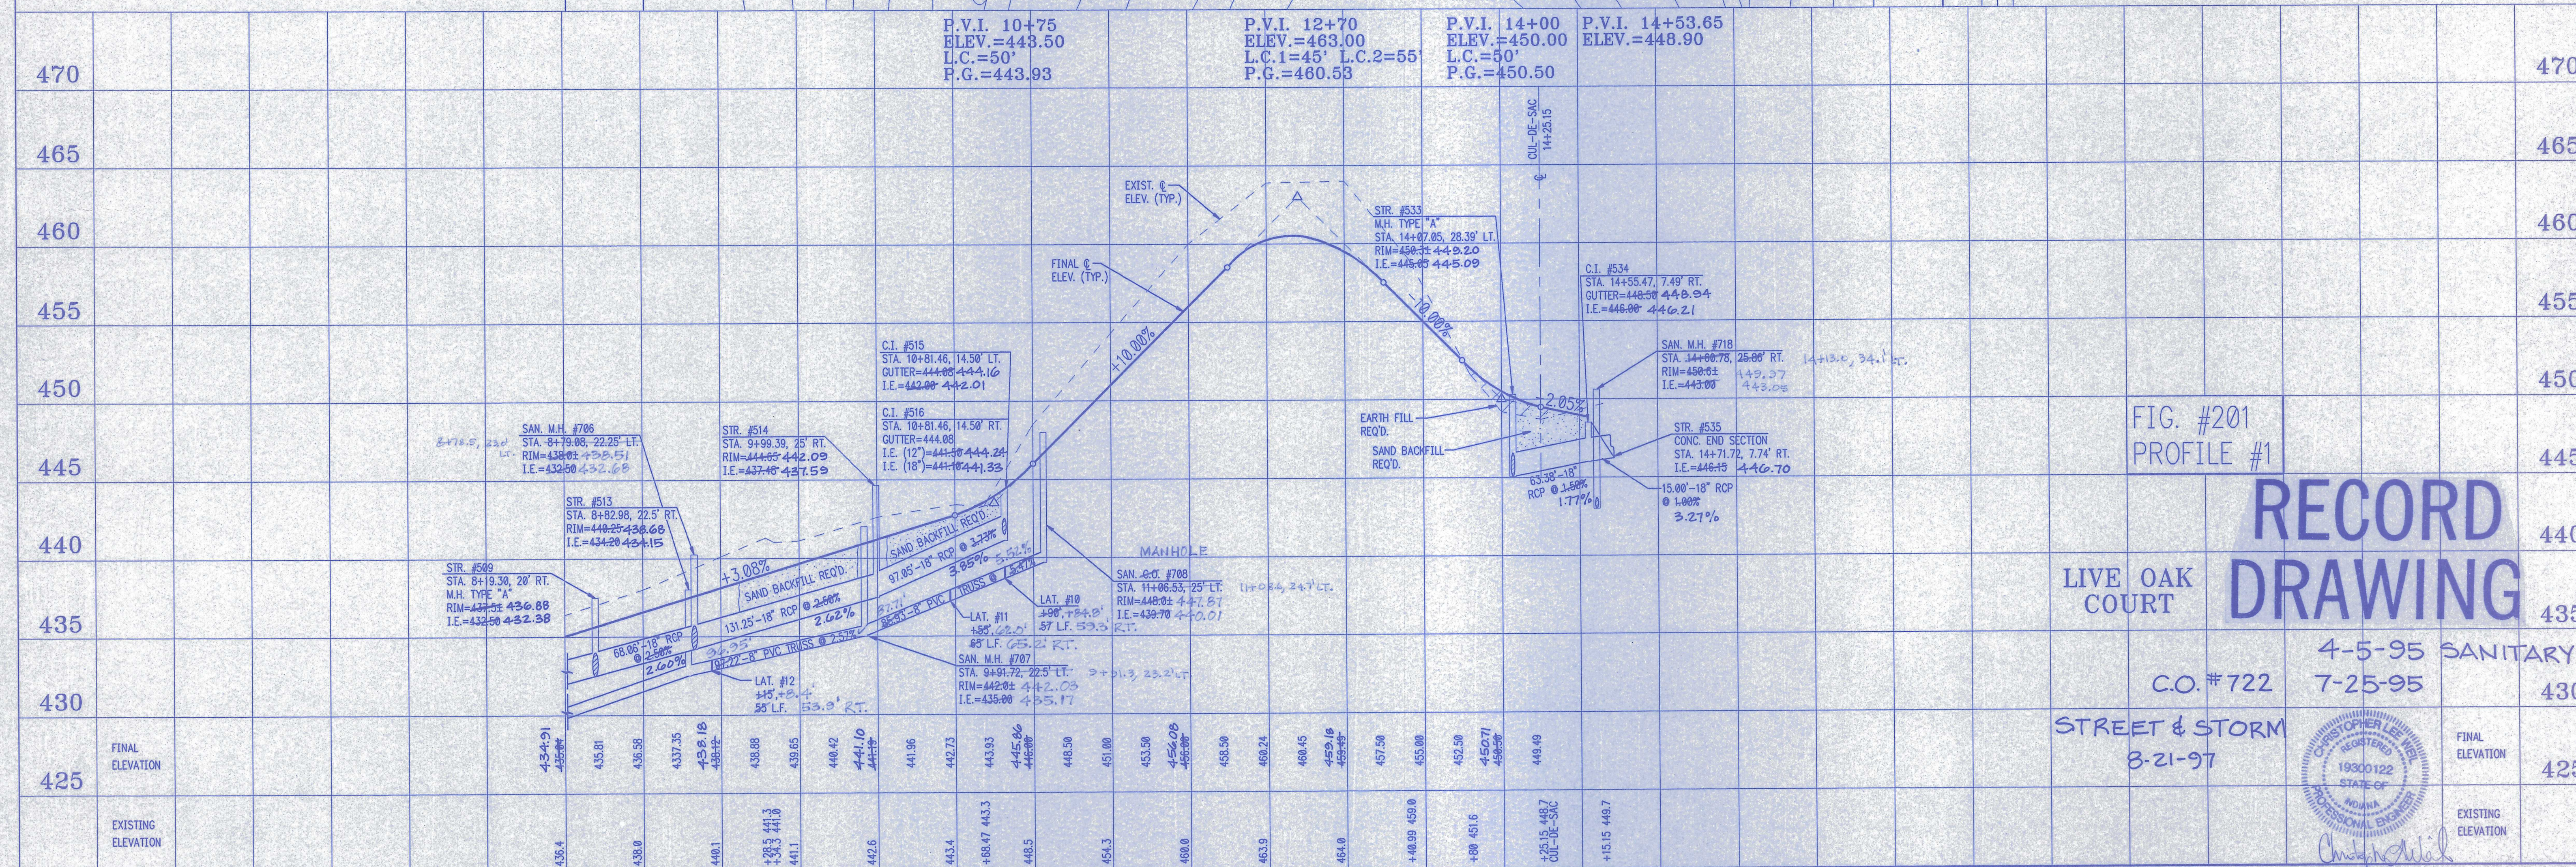


FIG. #201
PROFILE #1

**RECORD
DRAWING**

LIVE OAK
COURT

CO. #722

STREET & STORM
3-21-97

4-5-95 SANITARY

7-25-95



FINAL ELEVATION

EXISTING ELEVATION