



PLAN	BY	DATE
SURVEYED		
PLOTTED		
GRADES CHECKED		
RT. OF WAY CHECKED		
NOTE BOOK NO.		

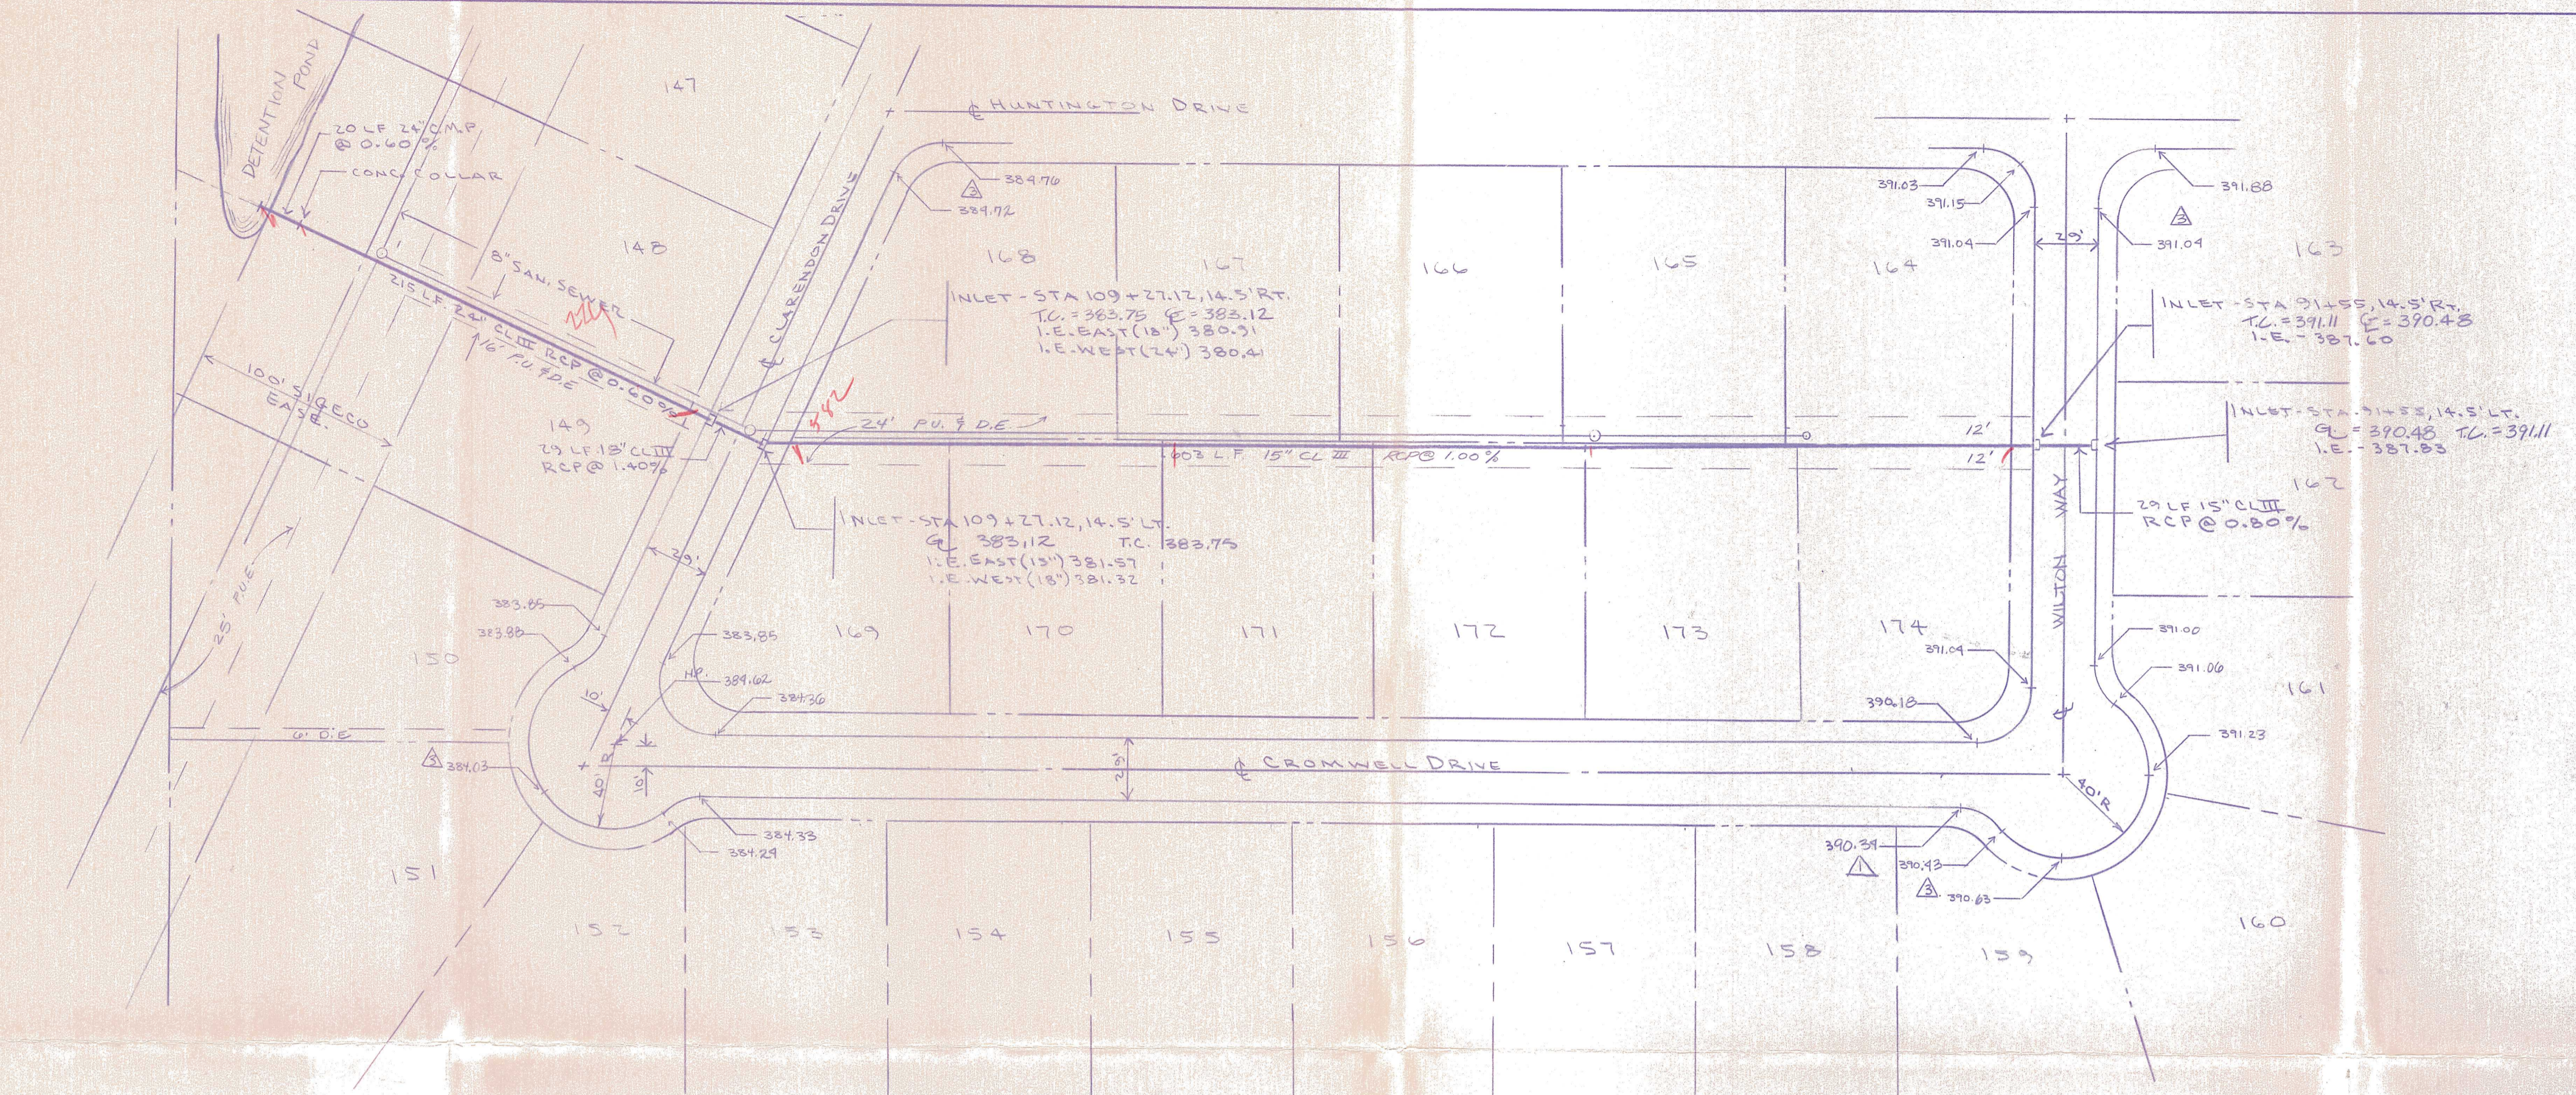

PROFILE	BY	DATE
SURVEYED		
GRADES CHECKED		
STRUCTURE NOTATIONS CHKD		
NOTE BOOK NO.		

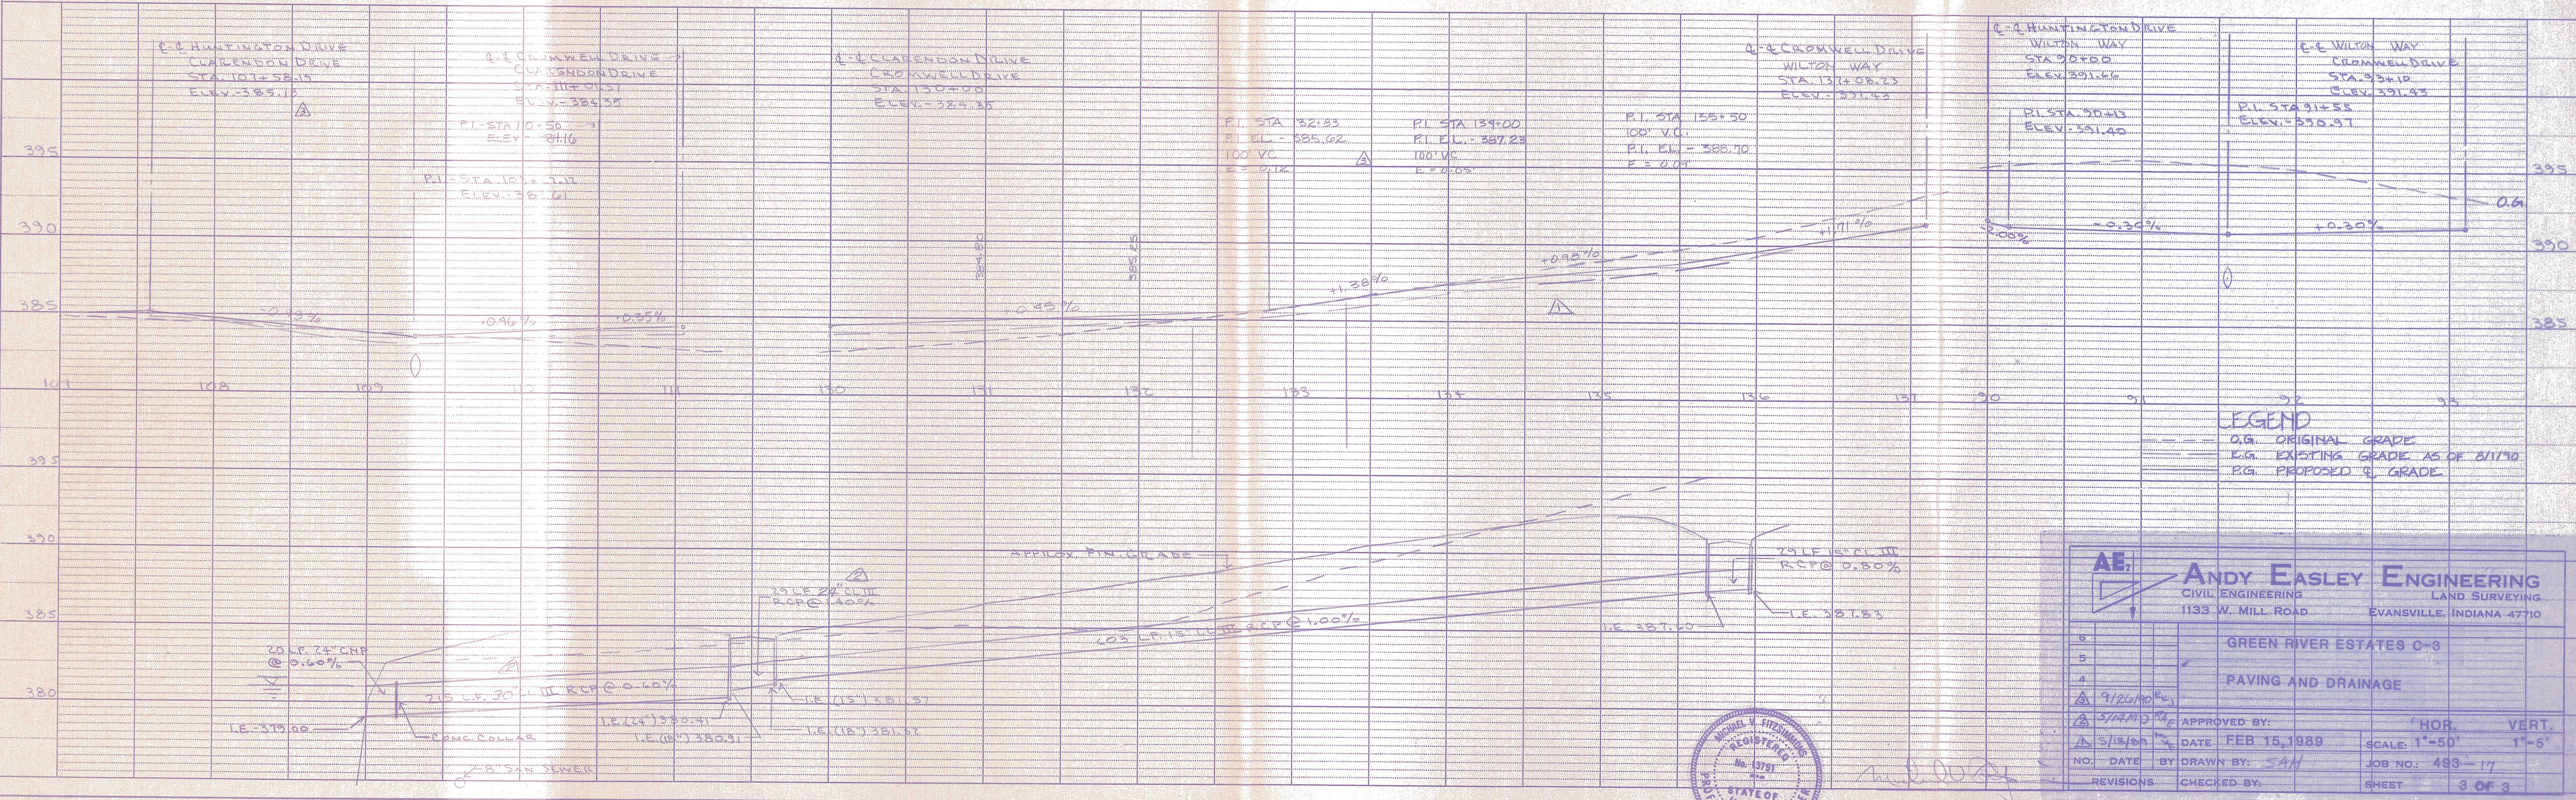

**LEGEND**  
 --- O.G. ORIGINAL GRADE  
 - - - E.G. EXISTING GRADE AS OF 8/1/70  
 = = = P.G. PROPOSED GRADE

**AE**  
**ANDY EASLEY ENGINEERING**  
 CIVIL ENGINEERING  
 1133 W. MILL ROAD  
 EVANSVILLE, INDIANA 47710

GREEN RIVER ESTATES C-8  
 PAVING AND DRAINAGE

APPROVED BY: [Signature]  
 DATE: FEB 15, 1989  
 NO. DATE BY DRAWN BY: SAN  
 REVISIONS CHECKED BY:

HOR. SCALE: 1"=50'  
 VERT. SCALE: 1"=5'  
 JOB NO: 483-17  
 SHEET: 3 OF 3

