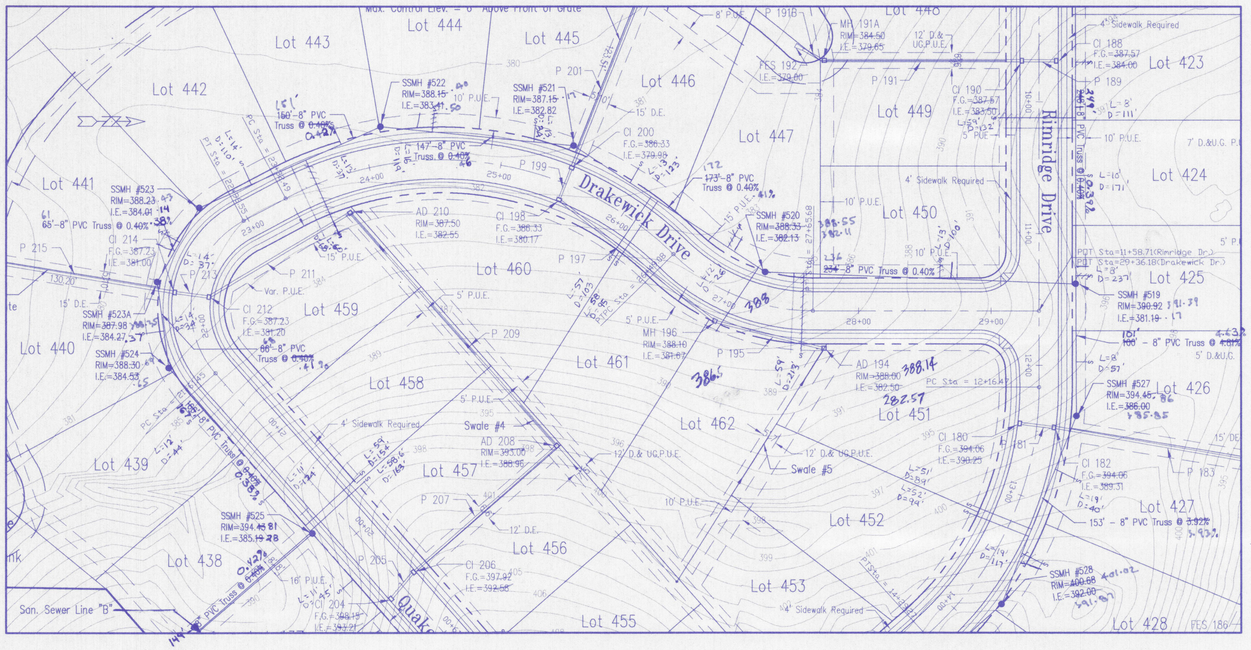

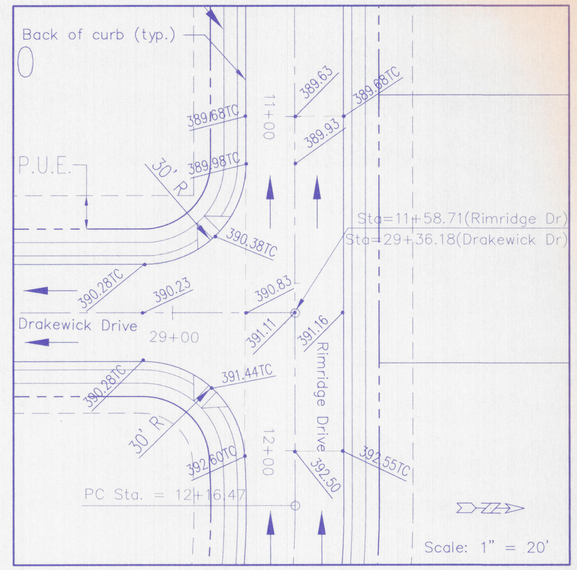

Rimridge Dr.—Drakewick Dr. Intersection

SCALES:
1" = 50' HOR
1" = 5' VER

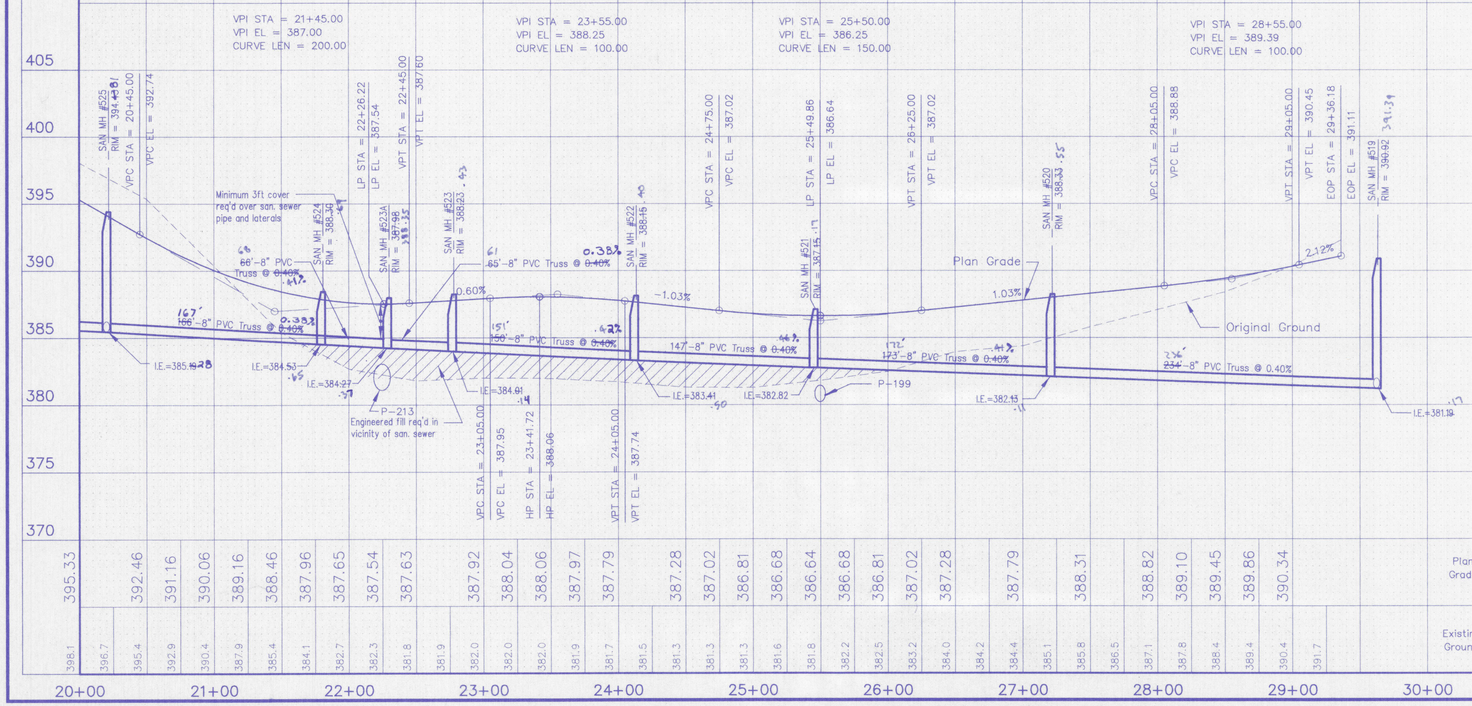

RECORD DRAWING

ISSUED FOR CONSTRUCTION 9-19-00

Morley and Associates, INC.
Consulting Engineers/Surveyors/Architects
600 S.E. Sixth Street
Evansville, Indiana 47713
(812) 464-9585

All work, design, calculations, and arrangements, indicated or represented by this drawing are owned by and the property of Morley and Associates, Inc. and were created for the use on and in connection with the construction of the project shown. All drawings, plans, specifications and/or copies thereof shall not be used by or disclosed to any person, firm or corporation for any purpose whatsoever without the written permission of Morley and Associates, Inc.

Written dimensions on these drawings shall have precedence over scale dimensions. Contractors shall verify and be responsible for all dimensions. Contractors shall notify and advise Morley and Associates, Inc. must be notified of any variations from the dimensions and conditions shown by these drawings.

Revisions

No.	By	Date	Description
1	DWS	3/21/01	Sheet Revision: Change cal line, storm & sanitary system
2	GAM	6-18-01	Sheet Revision: Change Sta. & Elev.

DAVID W. SCHWENK
REGISTERED
No. 19900178
STATE OF
INDIANA
PROFESSIONAL ENGINEER

Project: Keystone Section VII
Keystone Development, LLC

Sheet Title: Drakewick Drive
Plan and Profile
Station 20+00 – 29+36.18

Scale: As Shown

Designed By: DWS	Job Number: 3998-4
Drawn By: GAM	Date: 3-21-01
Checked By:	Filename: RCp01007.dwg

Sheet Number: C-10 of 18