


Saybrook Drive-Delk Drive Intersection

Scale: 1" = 20'

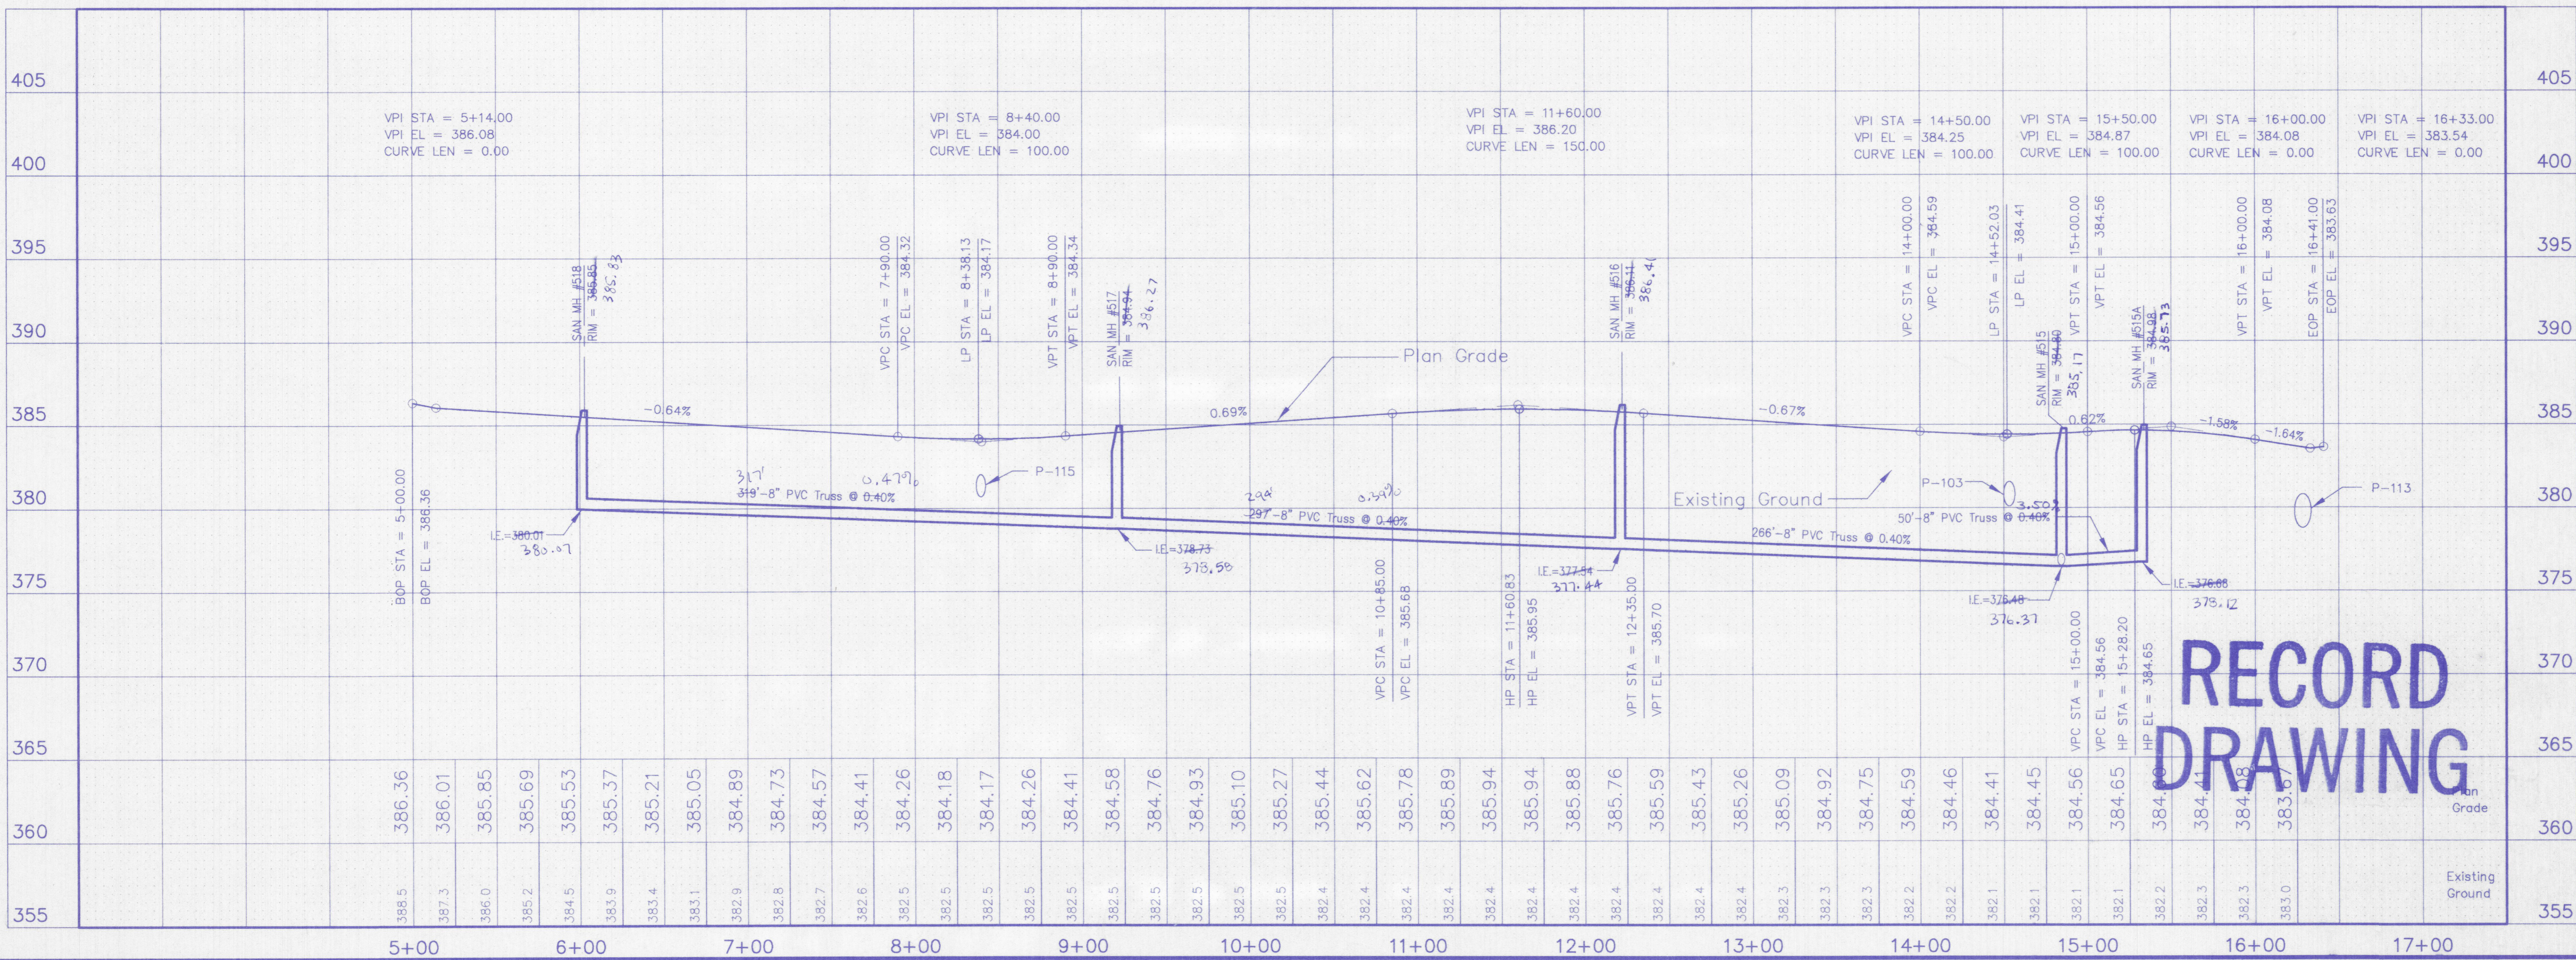

**RECORD
DRAWING**

Morley and Associates, Inc.
Consulting Engineers/Surveyors/Architects
600 S.E. Sixth Street
Evansville, Indiana 47713
(812) 464-9585

Revisions

No.	By	Date	Description
1	GH	6-01-01	SAN 1 STW A.S. P.U.L.T. 5 SEC. VIII STATE OF INDIANA

Professional Engineer Seal: DAVID SCHWINE, No. 1900175, STATE OF INDIANA

Project: Keystone Section VII
Keystone Development, LLC

Sheet Title: Delk Drive
Plan and Profile

Scale: As Shown
Designed By: DWS Job Number: 3998-4
Drawn By: GAM Date: 9-19-00
Checked By: RCP File Name: RCP01001.dwg
Sheet Number: C-4 of 18